


J. V. THOMPSON COAL

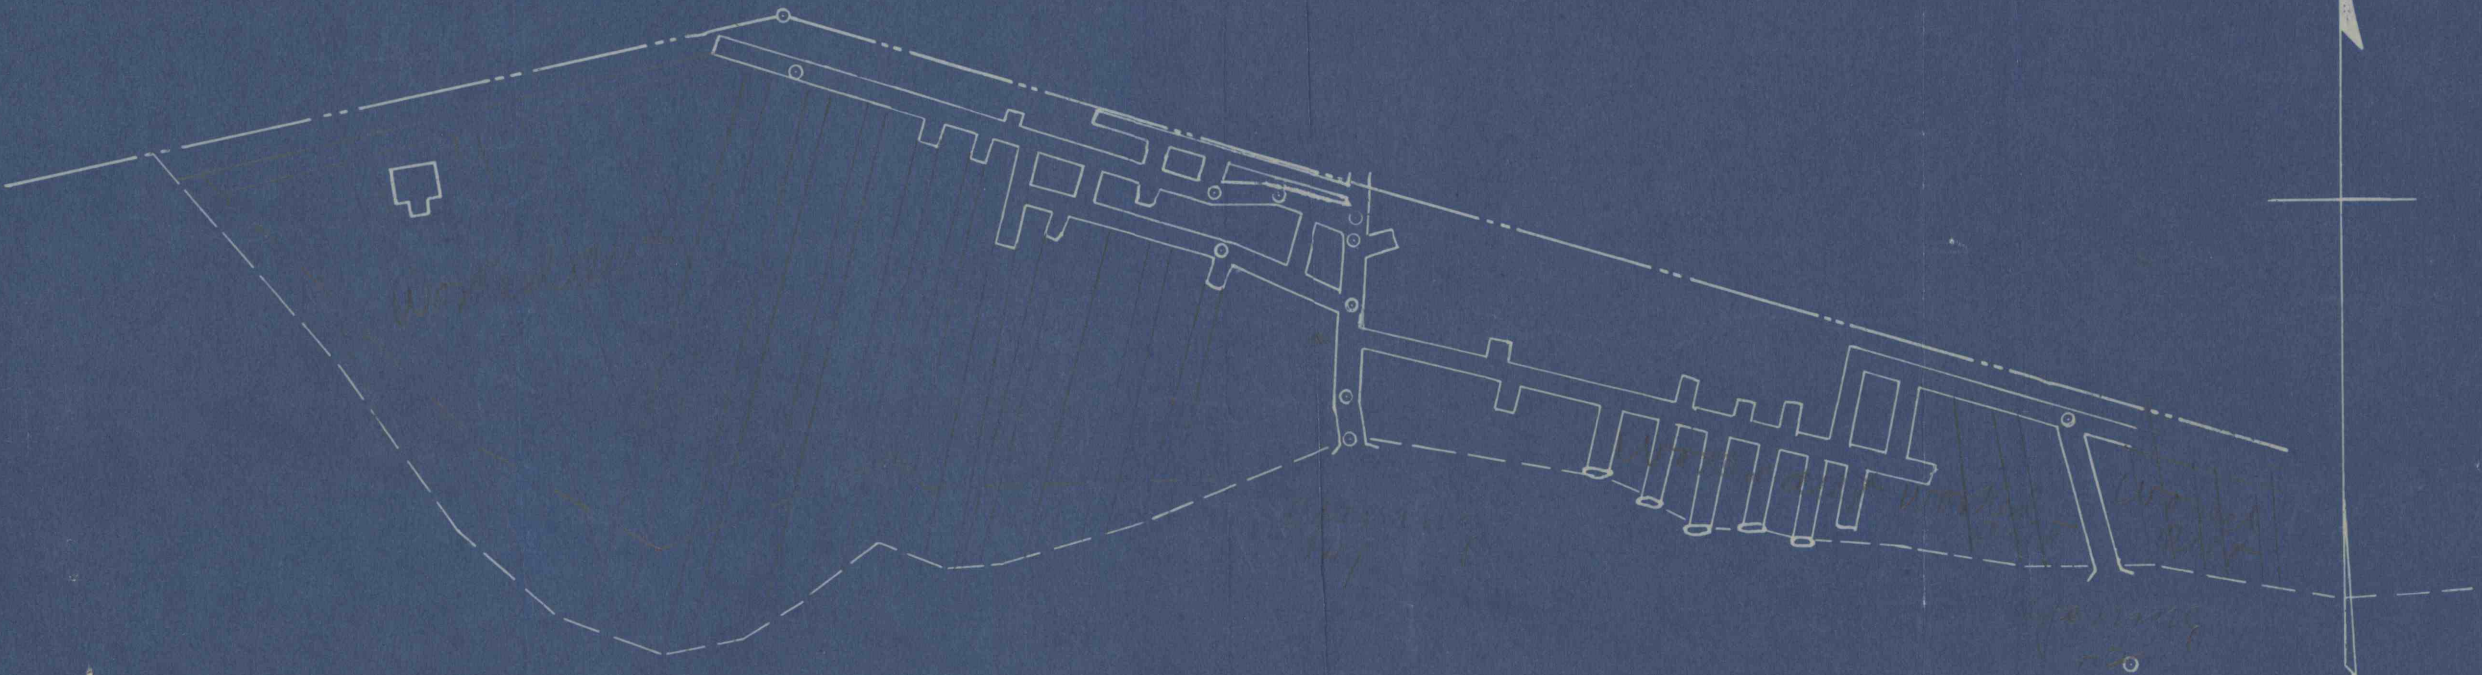

JENNINGS COAL CO.

SPRINGHILL TWP FAYETTE CO PA

SCALE 1" = 100'

H.B. GANS ENGR

#1407
8-10-99
CC