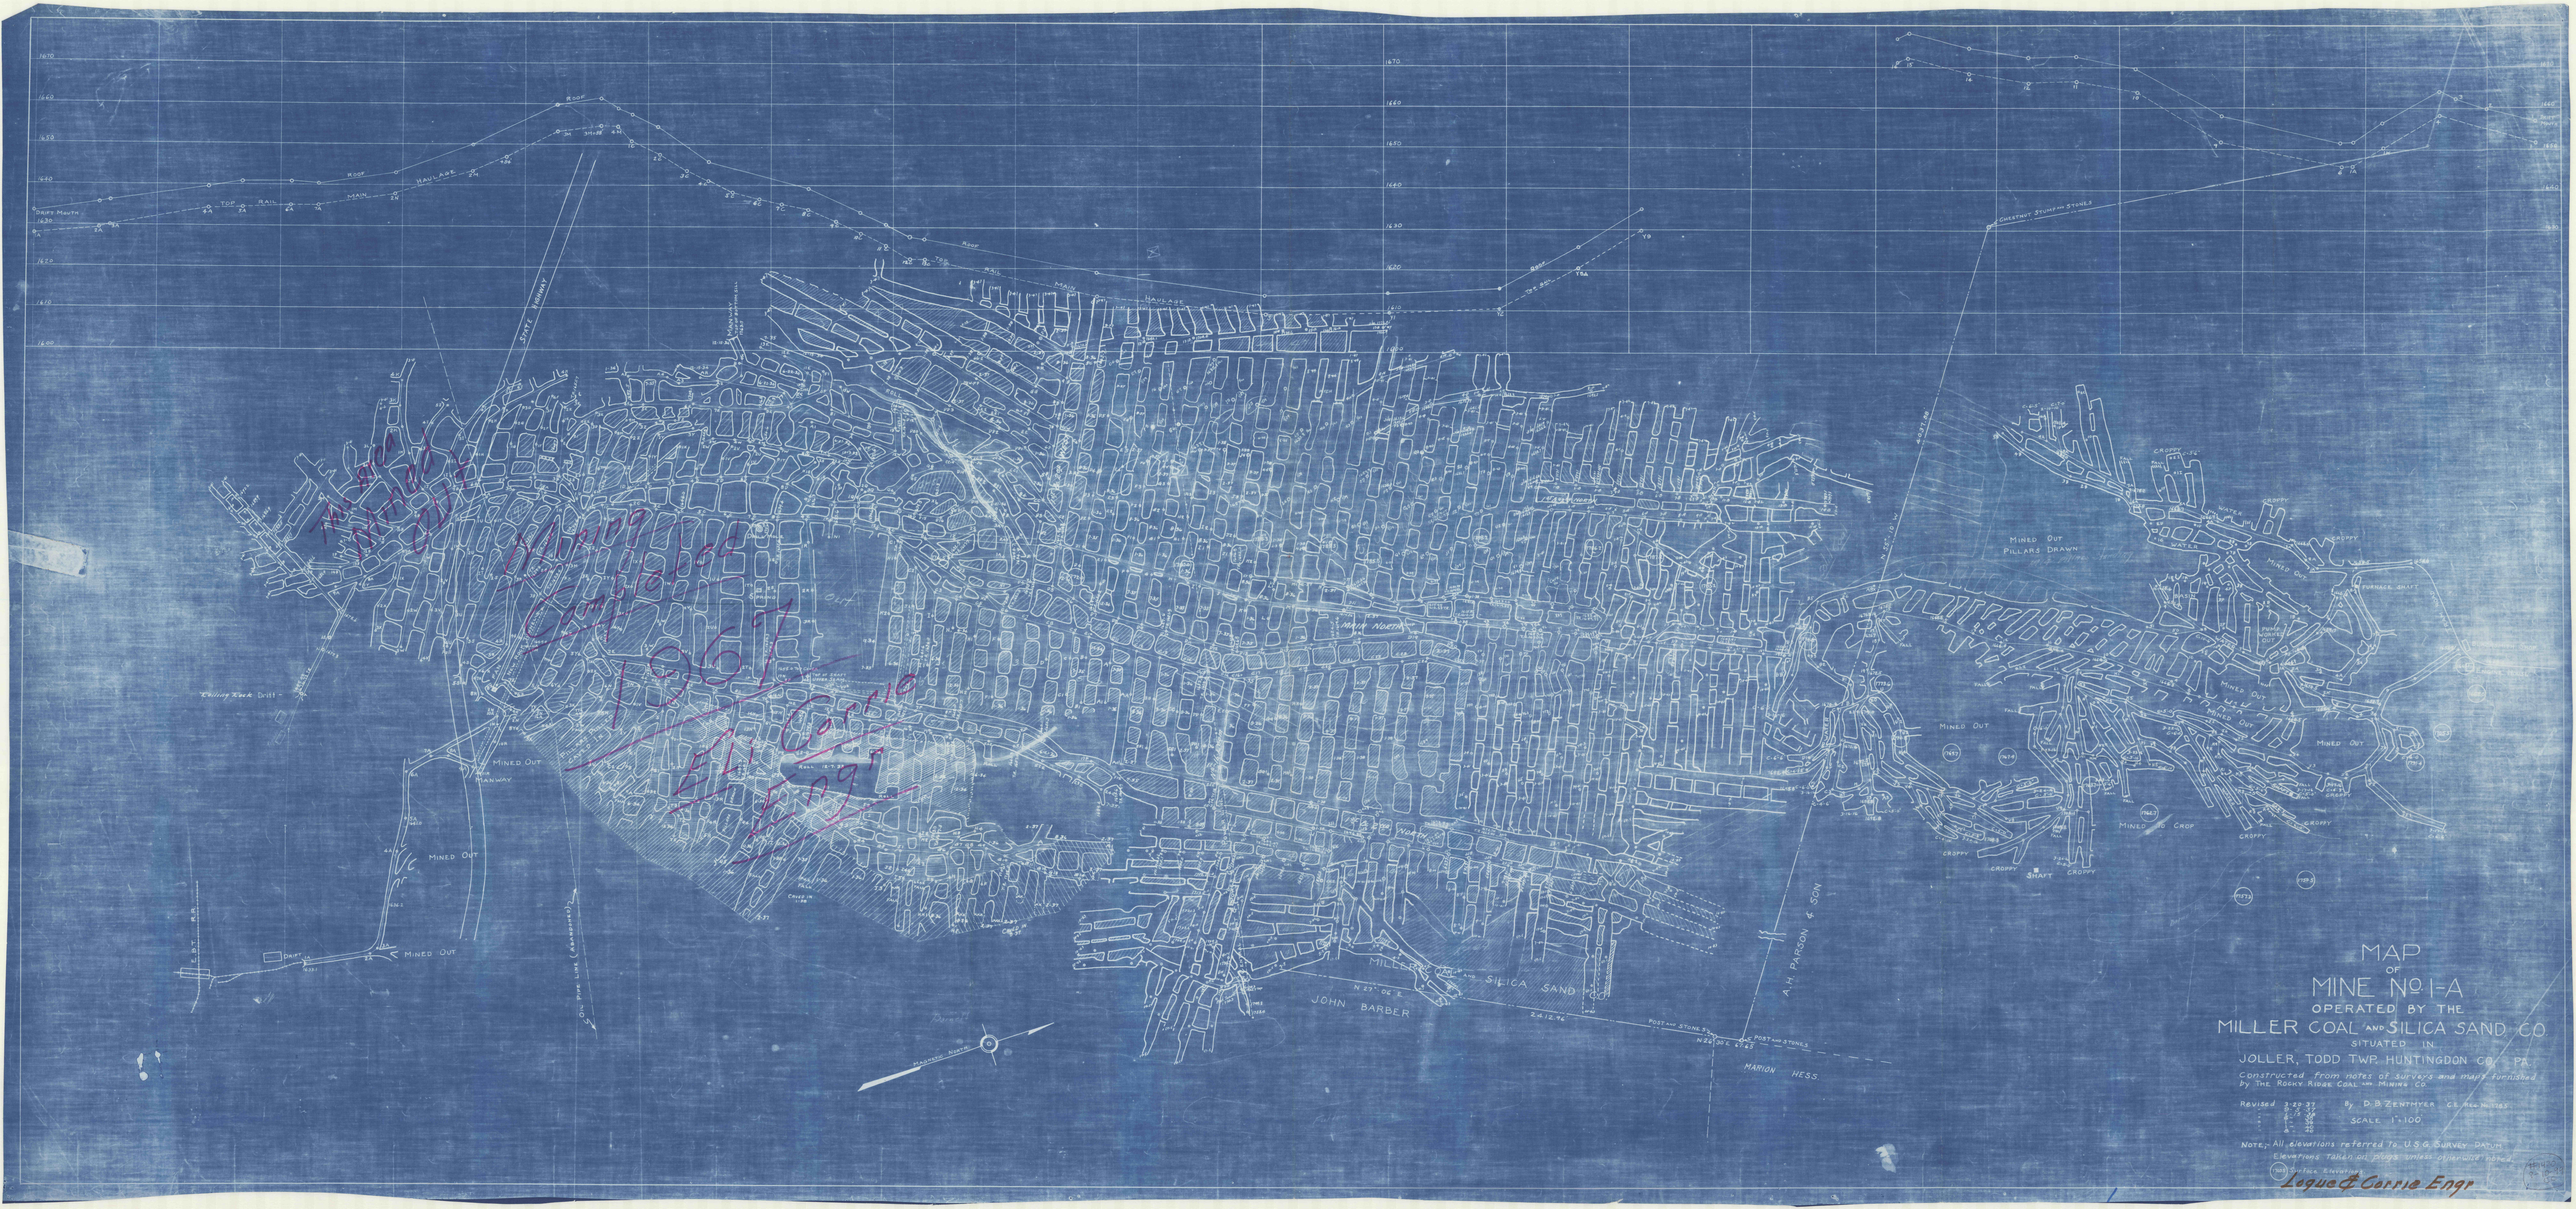

MAP
OF
MINE No. 1-A
OPERATED BY THE
MILLER COAL AND SILICA SAND CO.
SITUATED IN
JOLLER, TODD TWP. HUNTINGDON CO. PA.

Constructed from notes of surveys and maps furnished
by The Rocky Ridge Coal and Mining Co.

By D.B. Zentmyer C.E. Reg. No. 1785

Scale 1" = 100'

Revised 3-20-37
" 9-5-37
" 6-15-38
" 1-39
" 1-40
" 8-40

Note:- All elevations referred to U.S.G. Survey Datum.
Elevations taken on plugs unless otherwise noted.

(1705) Surface Elevations

Logue & Corrie Engr

#1420
8-10-99
CC

This area Mined Out

Mapping Completed
1961 Corrie
Ellis Engr

TRAM ROAD
FURNACE SHAFT
BLACKSMITH SHOP
ENGINE HOUSE
PUMP WORKED OUT
CROPPY
WATER
BASIN
FALL
MINED OUT
MINED OUT PILLARS DRAWN
MINED TO CROP
SHAFT
CHESTNUT STUMP AND STONES
N 55° 10' W 4037.88
A.H. PARSON & SON
POST AND STONES
MARION HESS
N 26° 30' E 67.65
MILLER COAL AND SILICA SAND
N 27° 06' E 2412.96
JOHN BARBER
MAIN NORTH
MAIN HAULAGE
ROOF
TOP RAIL
DRIFT MOUTH
ROLL
DRILL HOLE
SPRING
TOP OF SHAFT UPPER SEAM
PILLARS PULLED CAVED IN
NEW ROCK TUNNEL
FAN
MANWAY
MANWAY TOP OF BOTTOM SILL 1763.7
STATE HIGHWAY
OIL PIPE LINE (ABANDONED)
CAVED IN
Rolling Rock Drift
DRIFT
E.B.T. R.R.
MAGNETIC NORTH
1670
1660
1650
1640
1630
1620
1610
1600