

W. M^c GARVEY

GLASGOW

2020.9

S33°19'E

N 65°-19'E

BOULTON - SURFACE
RAYMOND WITHEROW - COAL

2692.6

2714.2

POWER LINE

MARGARET M^cGLYNN - SURFACE
RAYMOND WITHEROW - MINERALS

JORDAN COAL CO.


Coal To Be Mined
Sept 15, 1967
To
Mar 15, 1968

Coal To Be Mined
Sept 15, 1967
To
Mar 15, 1968

J. JOHNSON

198.5

M 15 255 S

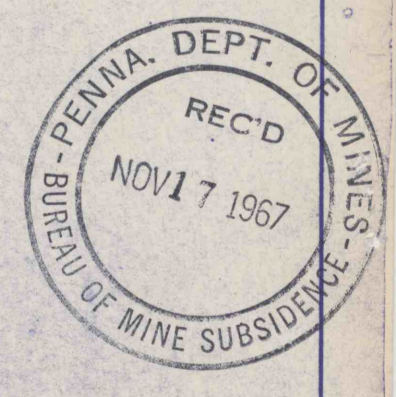

FIELD COPY

JOR-NOX COAL CO.
 RAYMOND WITHEROW
 NEW MILLPORT, PA.
 MAP OF MINE NO. 1
 JORDAN TWP CLFD. CO. PA.
 SCALE 1"=100'
 CLEARFIELD, PA.
 JULY 18, 1966
 Map Revised Nov. 13, 1967

ROY C. KINDIG
 REG. ENGR.
 LEX W. CURRY
 REG. SURVEYOR

ADDED TO
 BY ROY C. KINDIG P.E.

PORTIONS TRACED FROM OLD MAP
 MADE BY J. D. HAINES JR. P.E.