


Sheet of Work

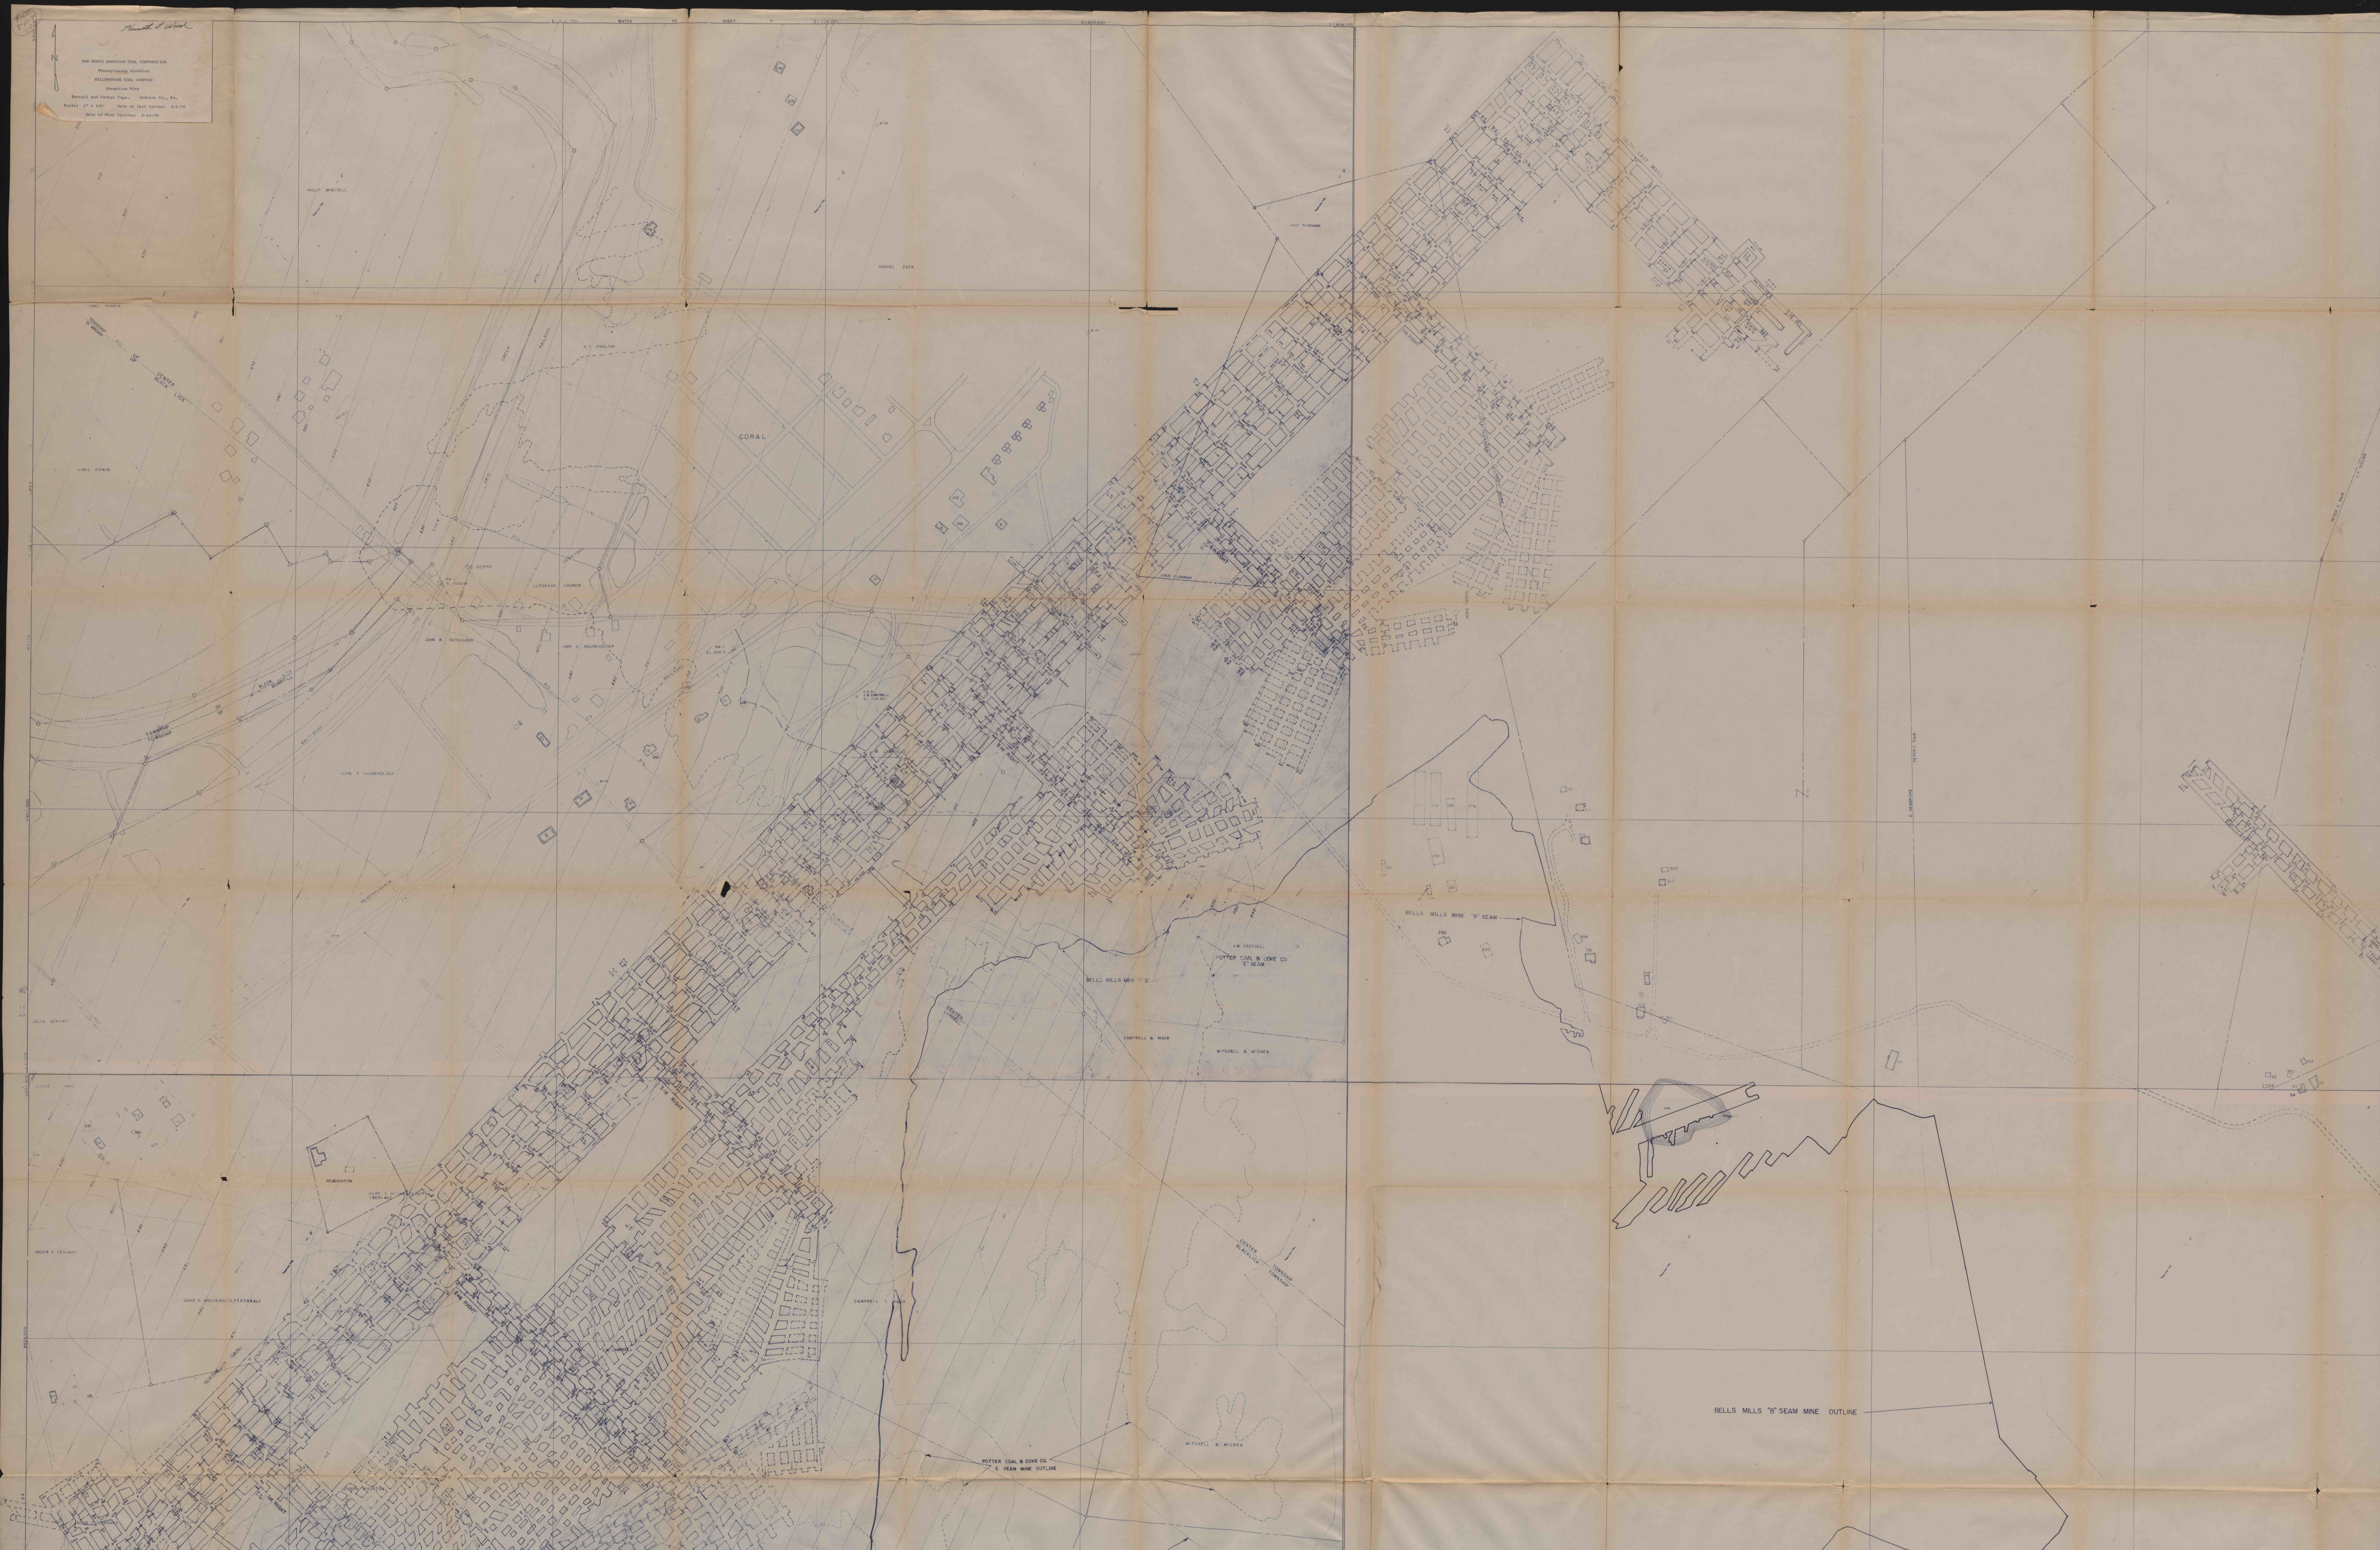

BELL'S MILLS "B" SEAM MINE OUTLINE

POTTER COAL & COKE CO. "E" SEAM MINE OUTLINE

BELL'S MILLS MINE "B" SEAM

POTTER COAL & COKE CO. "E" SEAM

CAMPBELL & MACK

MITCHELL & WISNER

CORAL

JOHN H. HODGENS

LUTHERAN CHURCH

CAMPBELL & MACK

MITCHELL & WISNER

SEWER

BELLEVILLE

BRASS

TOWNSHIP

RESERVATION

JOHN H. HODGENS

JOHN H. HODGENS

