

WASHINGTON BRANCH P.C. & S.T. R.R.

MINED OUT
MARY ALEXANDER

MINED OUT

MINED OUT

MINED OUT

BOUNDARY LINE

MINED OUT

BOUNDARY LINE

MINED OUT

W. J. HITCHMAN

MINED OUT

MINED OUT

MINED OUT

MINED OUT


15 FT CROP LINE

15 FT CROP LINE

15 FT CROP LINE

JOYCE MINE (BOONE)
CONEY BROS. COAL CO.
JOHN J. SEILER PROF. ENG. 9922
SCALE 1"=100'

1-28-52

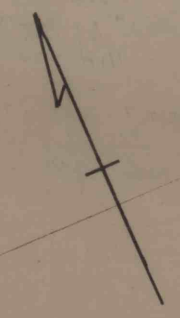

#1408
3-11-99
C.C.

MINED OUT

MINED OUT