
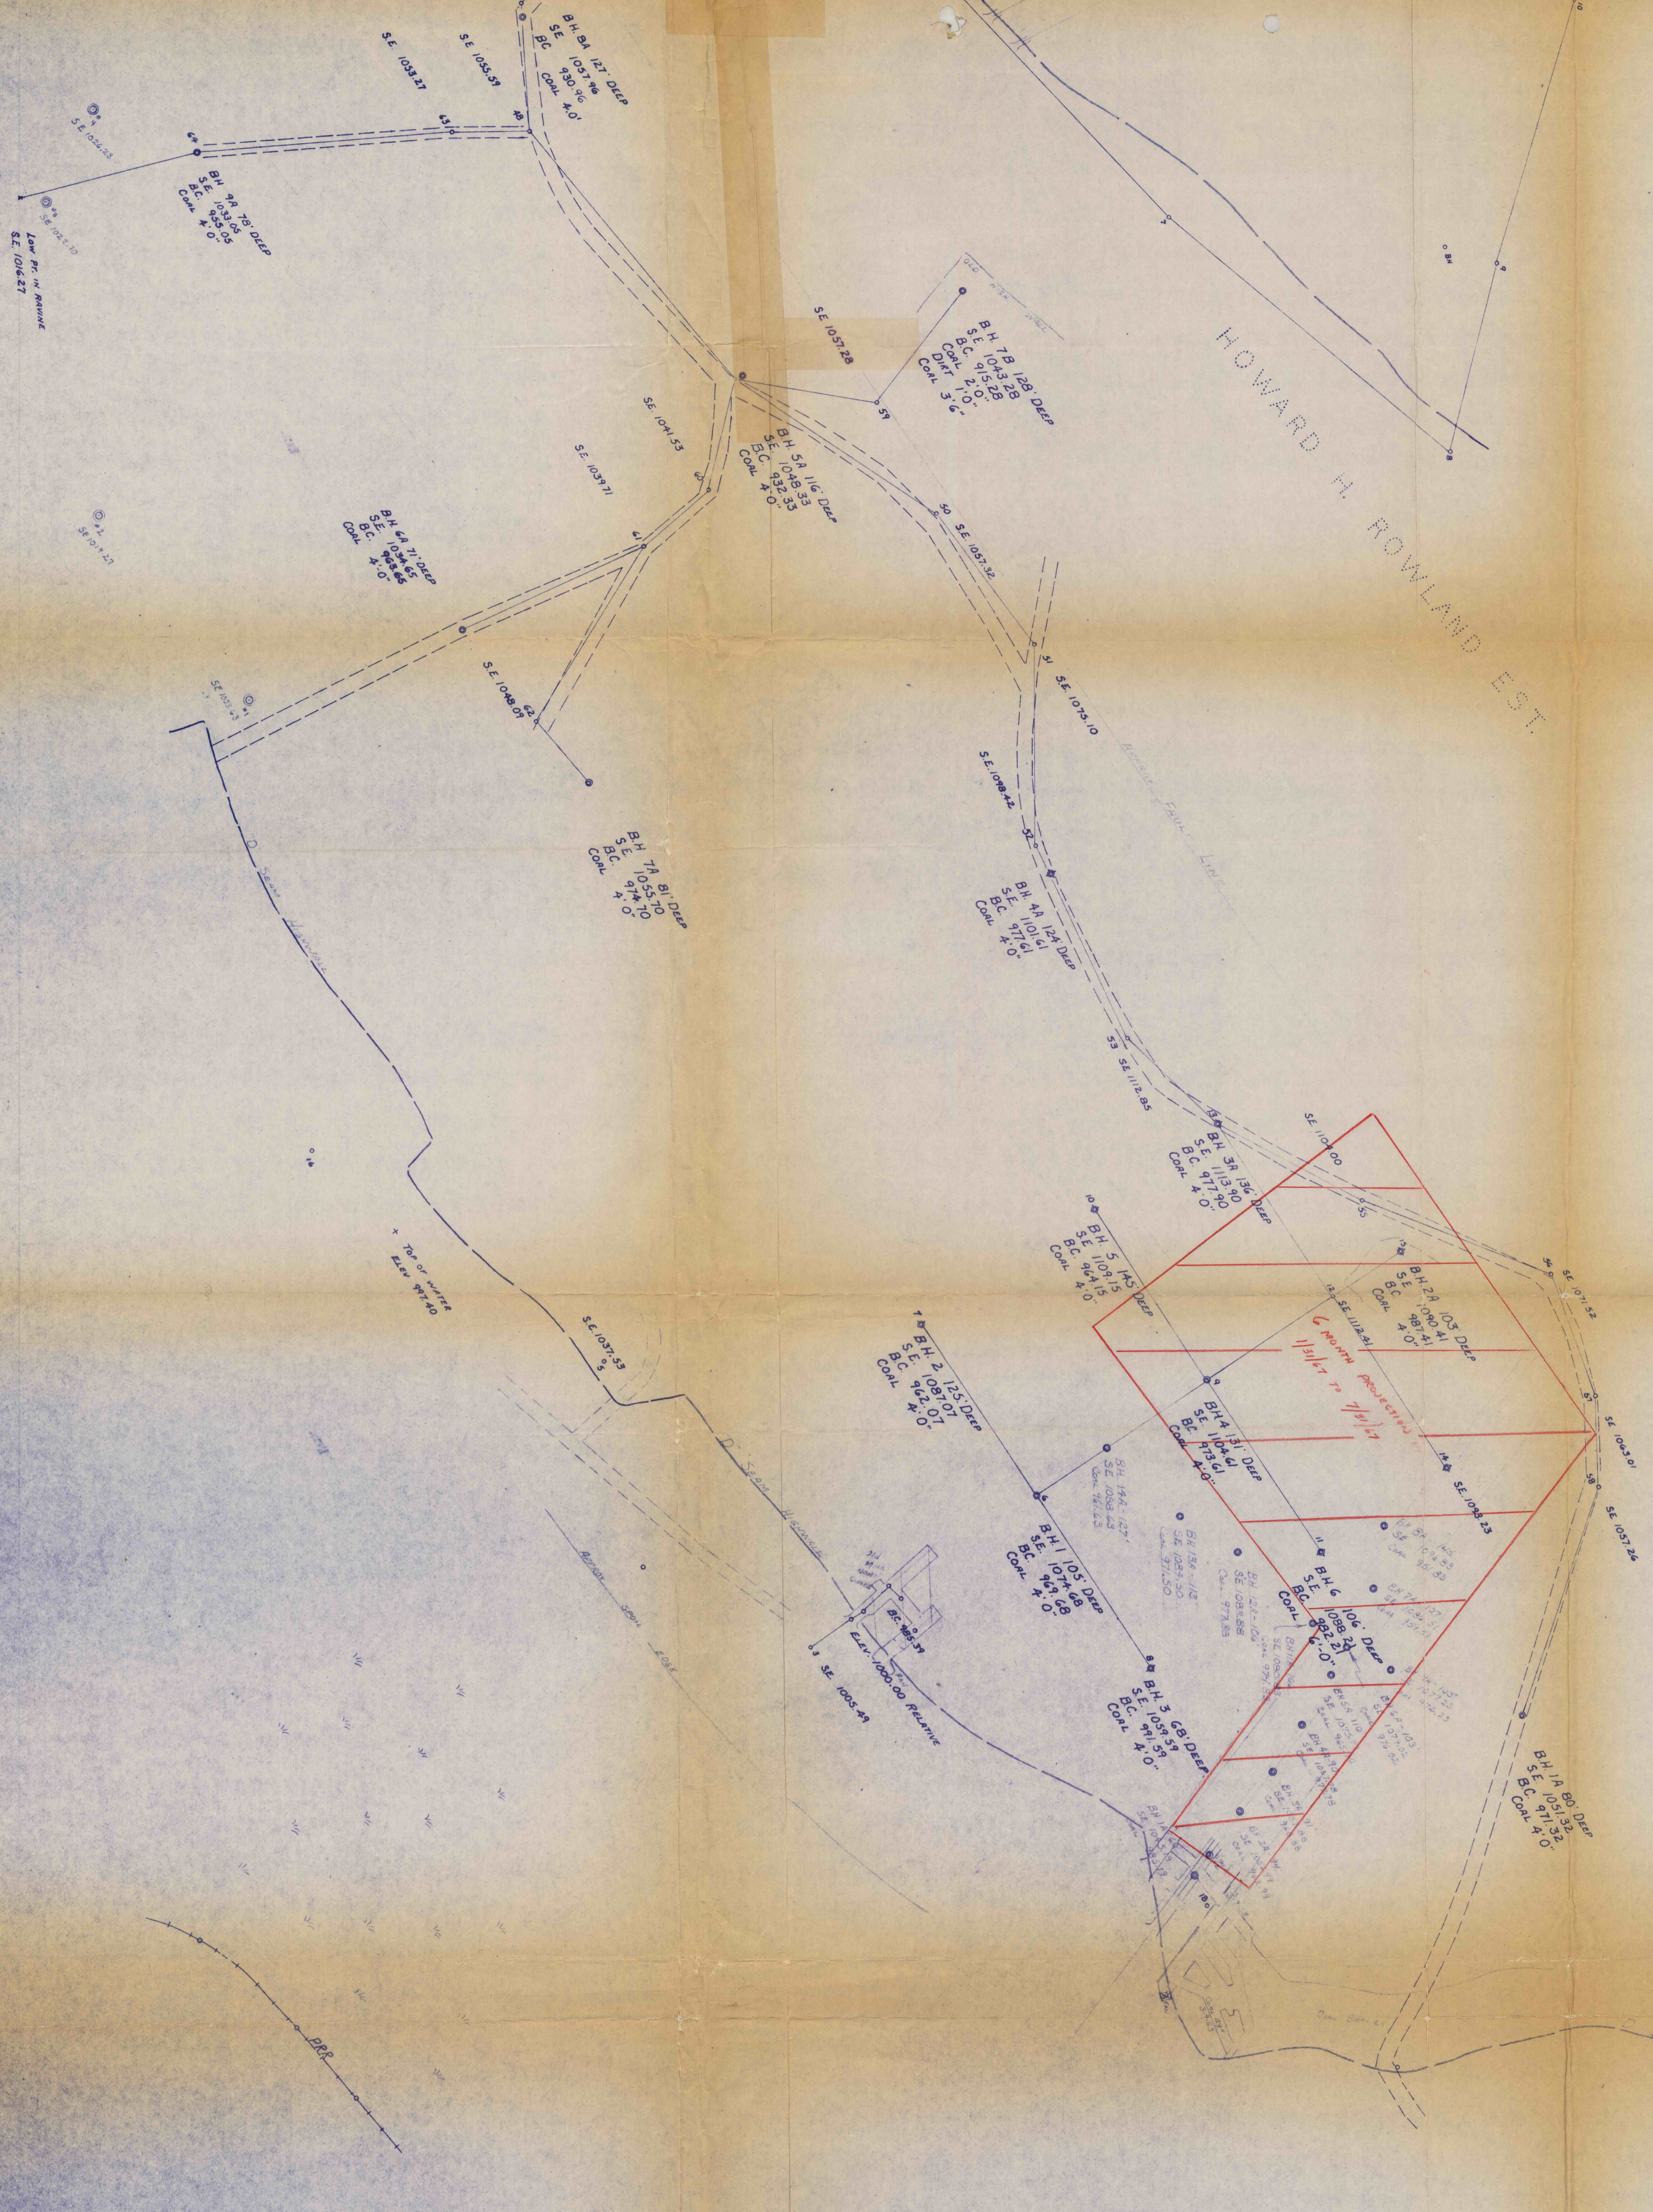


HOWARD H. ROWLAND EST.

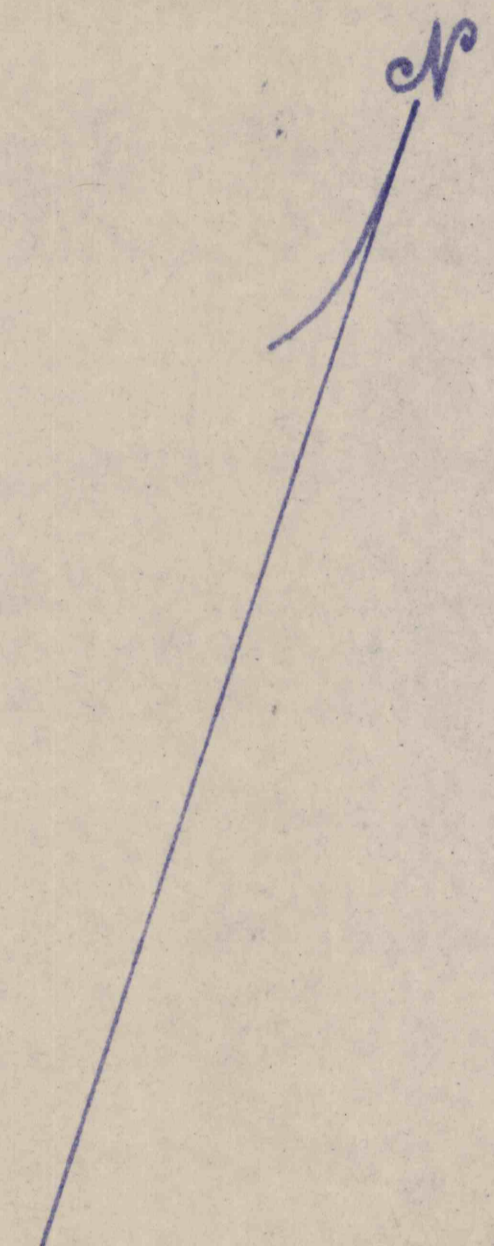

NOTE: SURVEYS MADE TO 1-1-66
BY DENNARD LUCAS JR.


Scale: 1/4" = 100' Date: 1-1-66
E. ROWLAND 1088
17th Dist. No. 1000

FIELD COPY