


Note - Workings in dotted lines
are old exhausted workings
in 'B' Seam.

MAP OF WORKINGS IN "B RIDER" SEAM
OPERATED BY
JUNIATA COAL COMPANY

ON LANDS OF
CAMBRIA MINING & MFG CO.
PORTAGE TOWNSHIP, CAMBRIA COUNTY, PA.

SCALE 1"=100'

ENGINEERS.

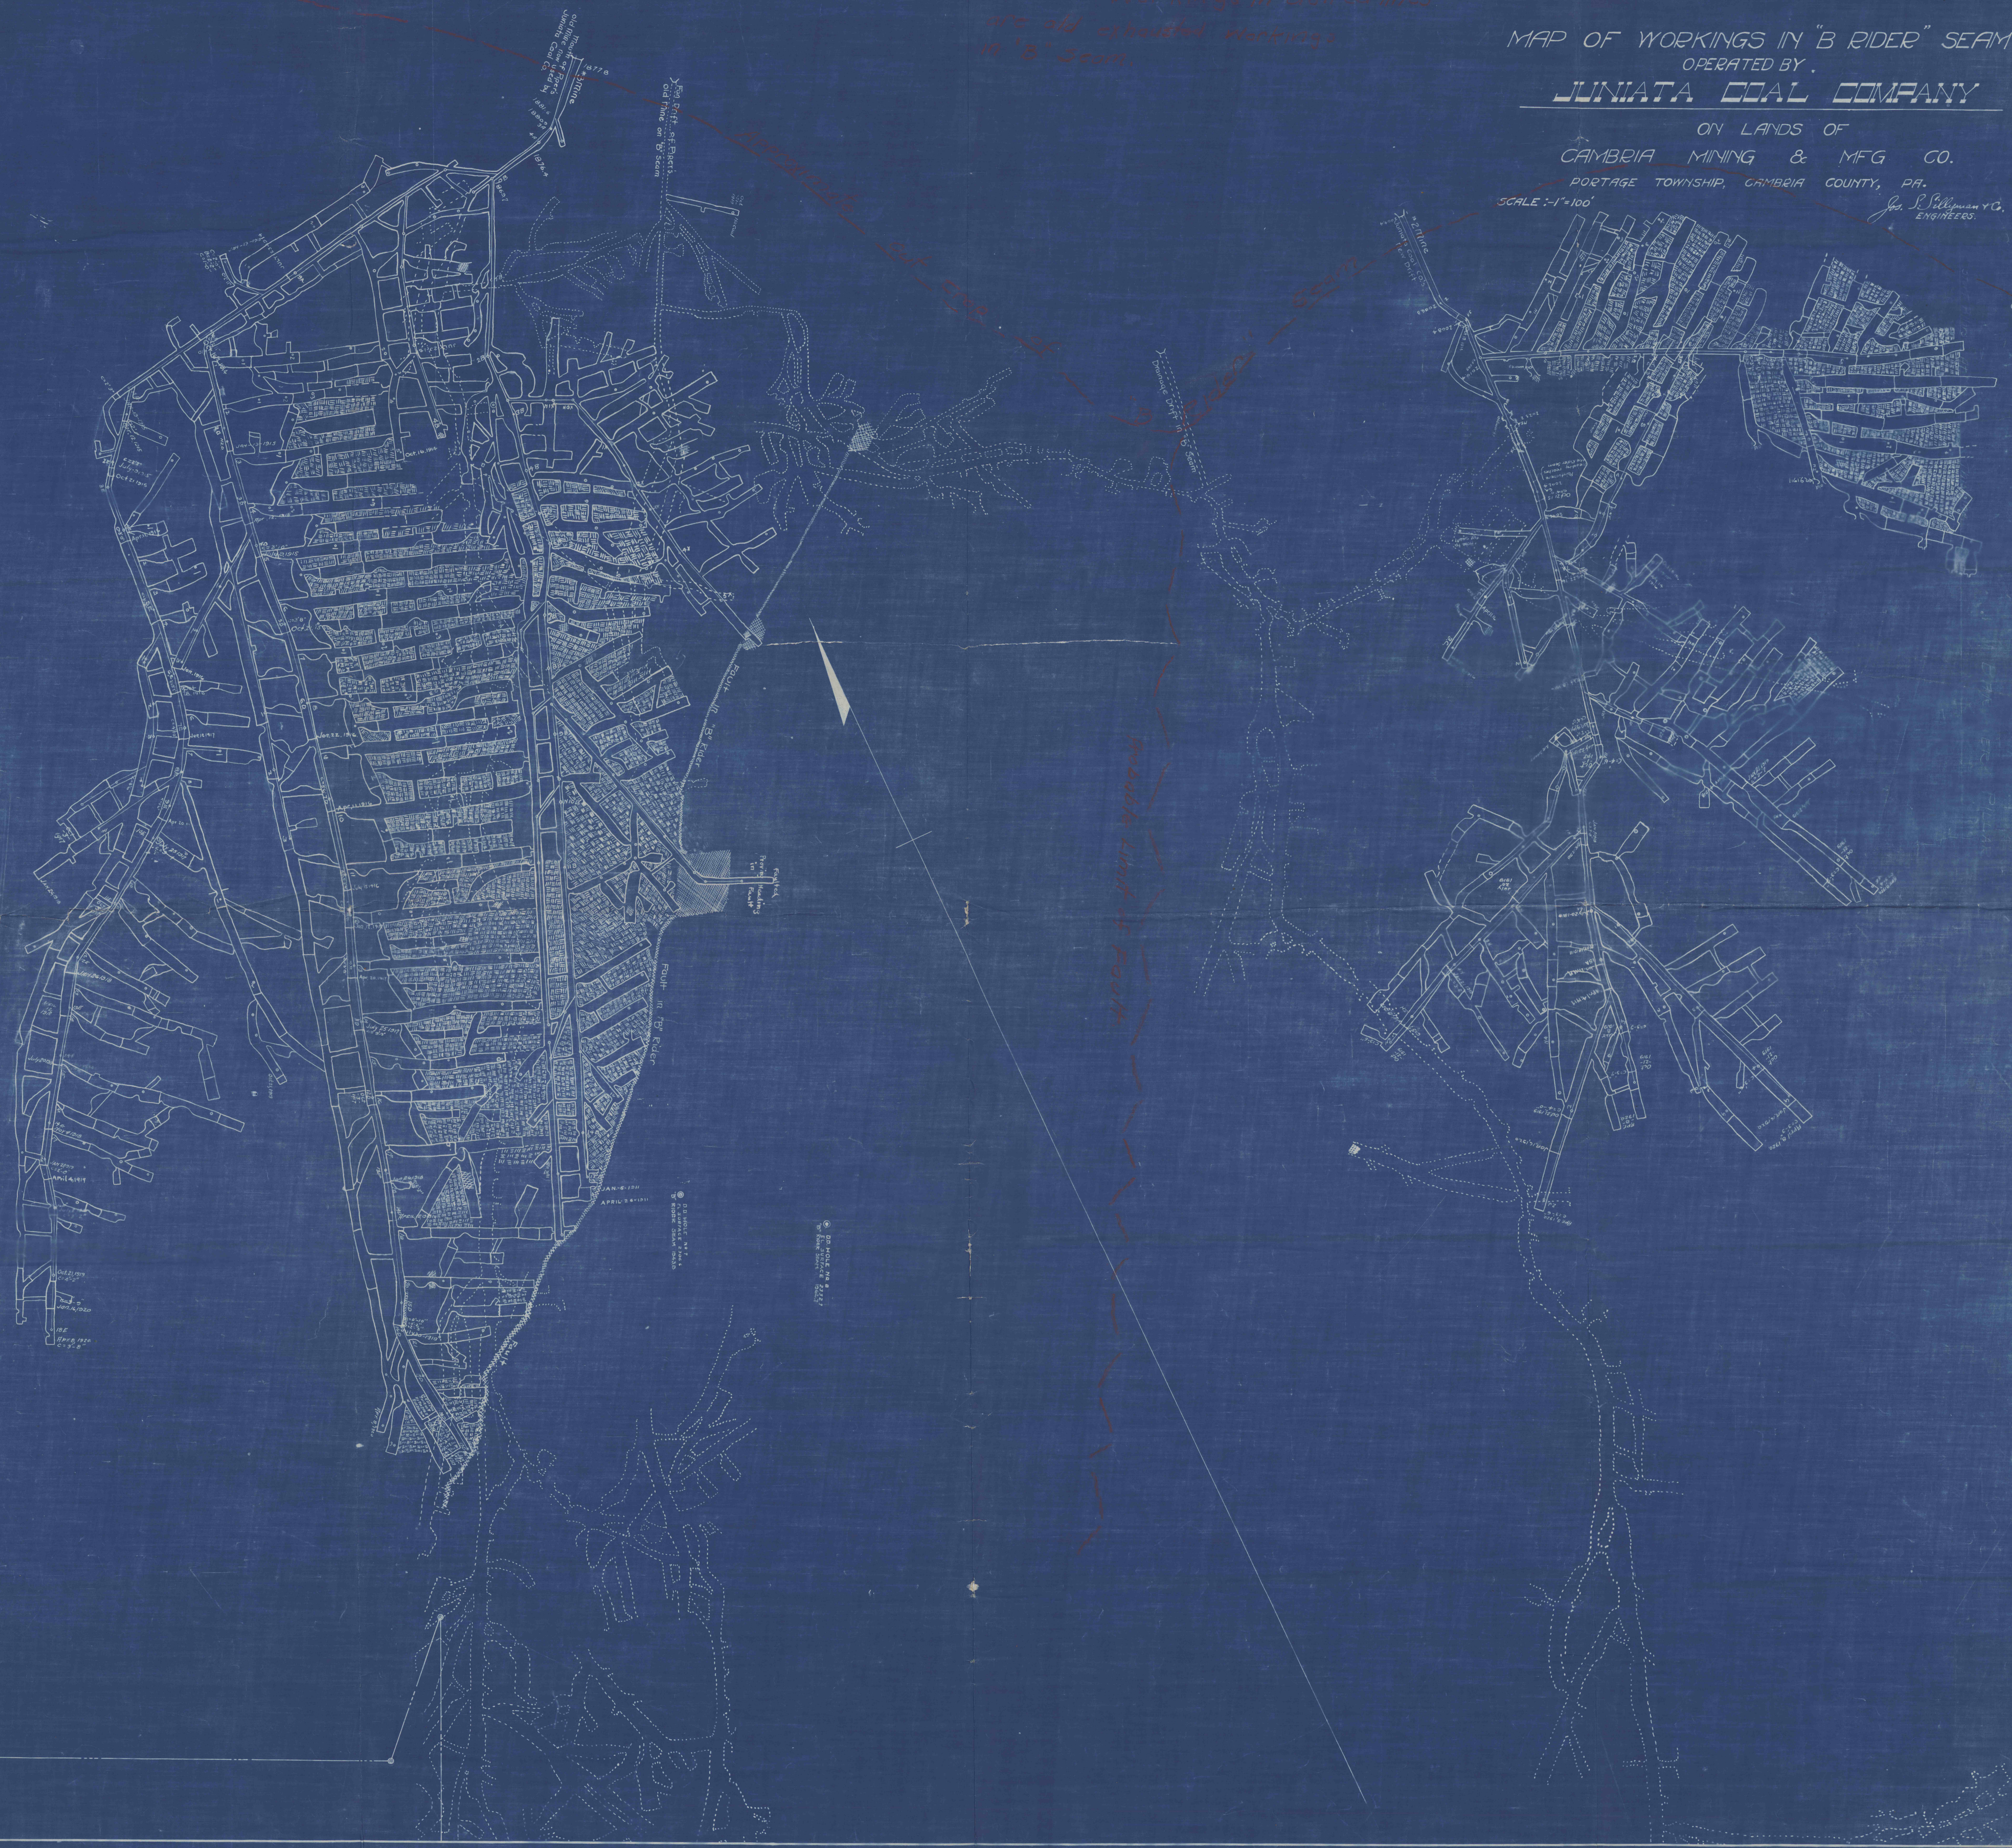



