


GEORGE GILLELAND
AREA 13.405 ACS.

NOTE: COAL ALONG THE OUTCROP
TO BE TESTED BEFORE RETREATING
GENUINE

NOTE: COAL ALONG THE OUTCROP
TO BE TESTED BEFORE RETREATING

NOTE: COAL ALONG OUTCROP IS
TO BE TESTED BEFORE RETREATING

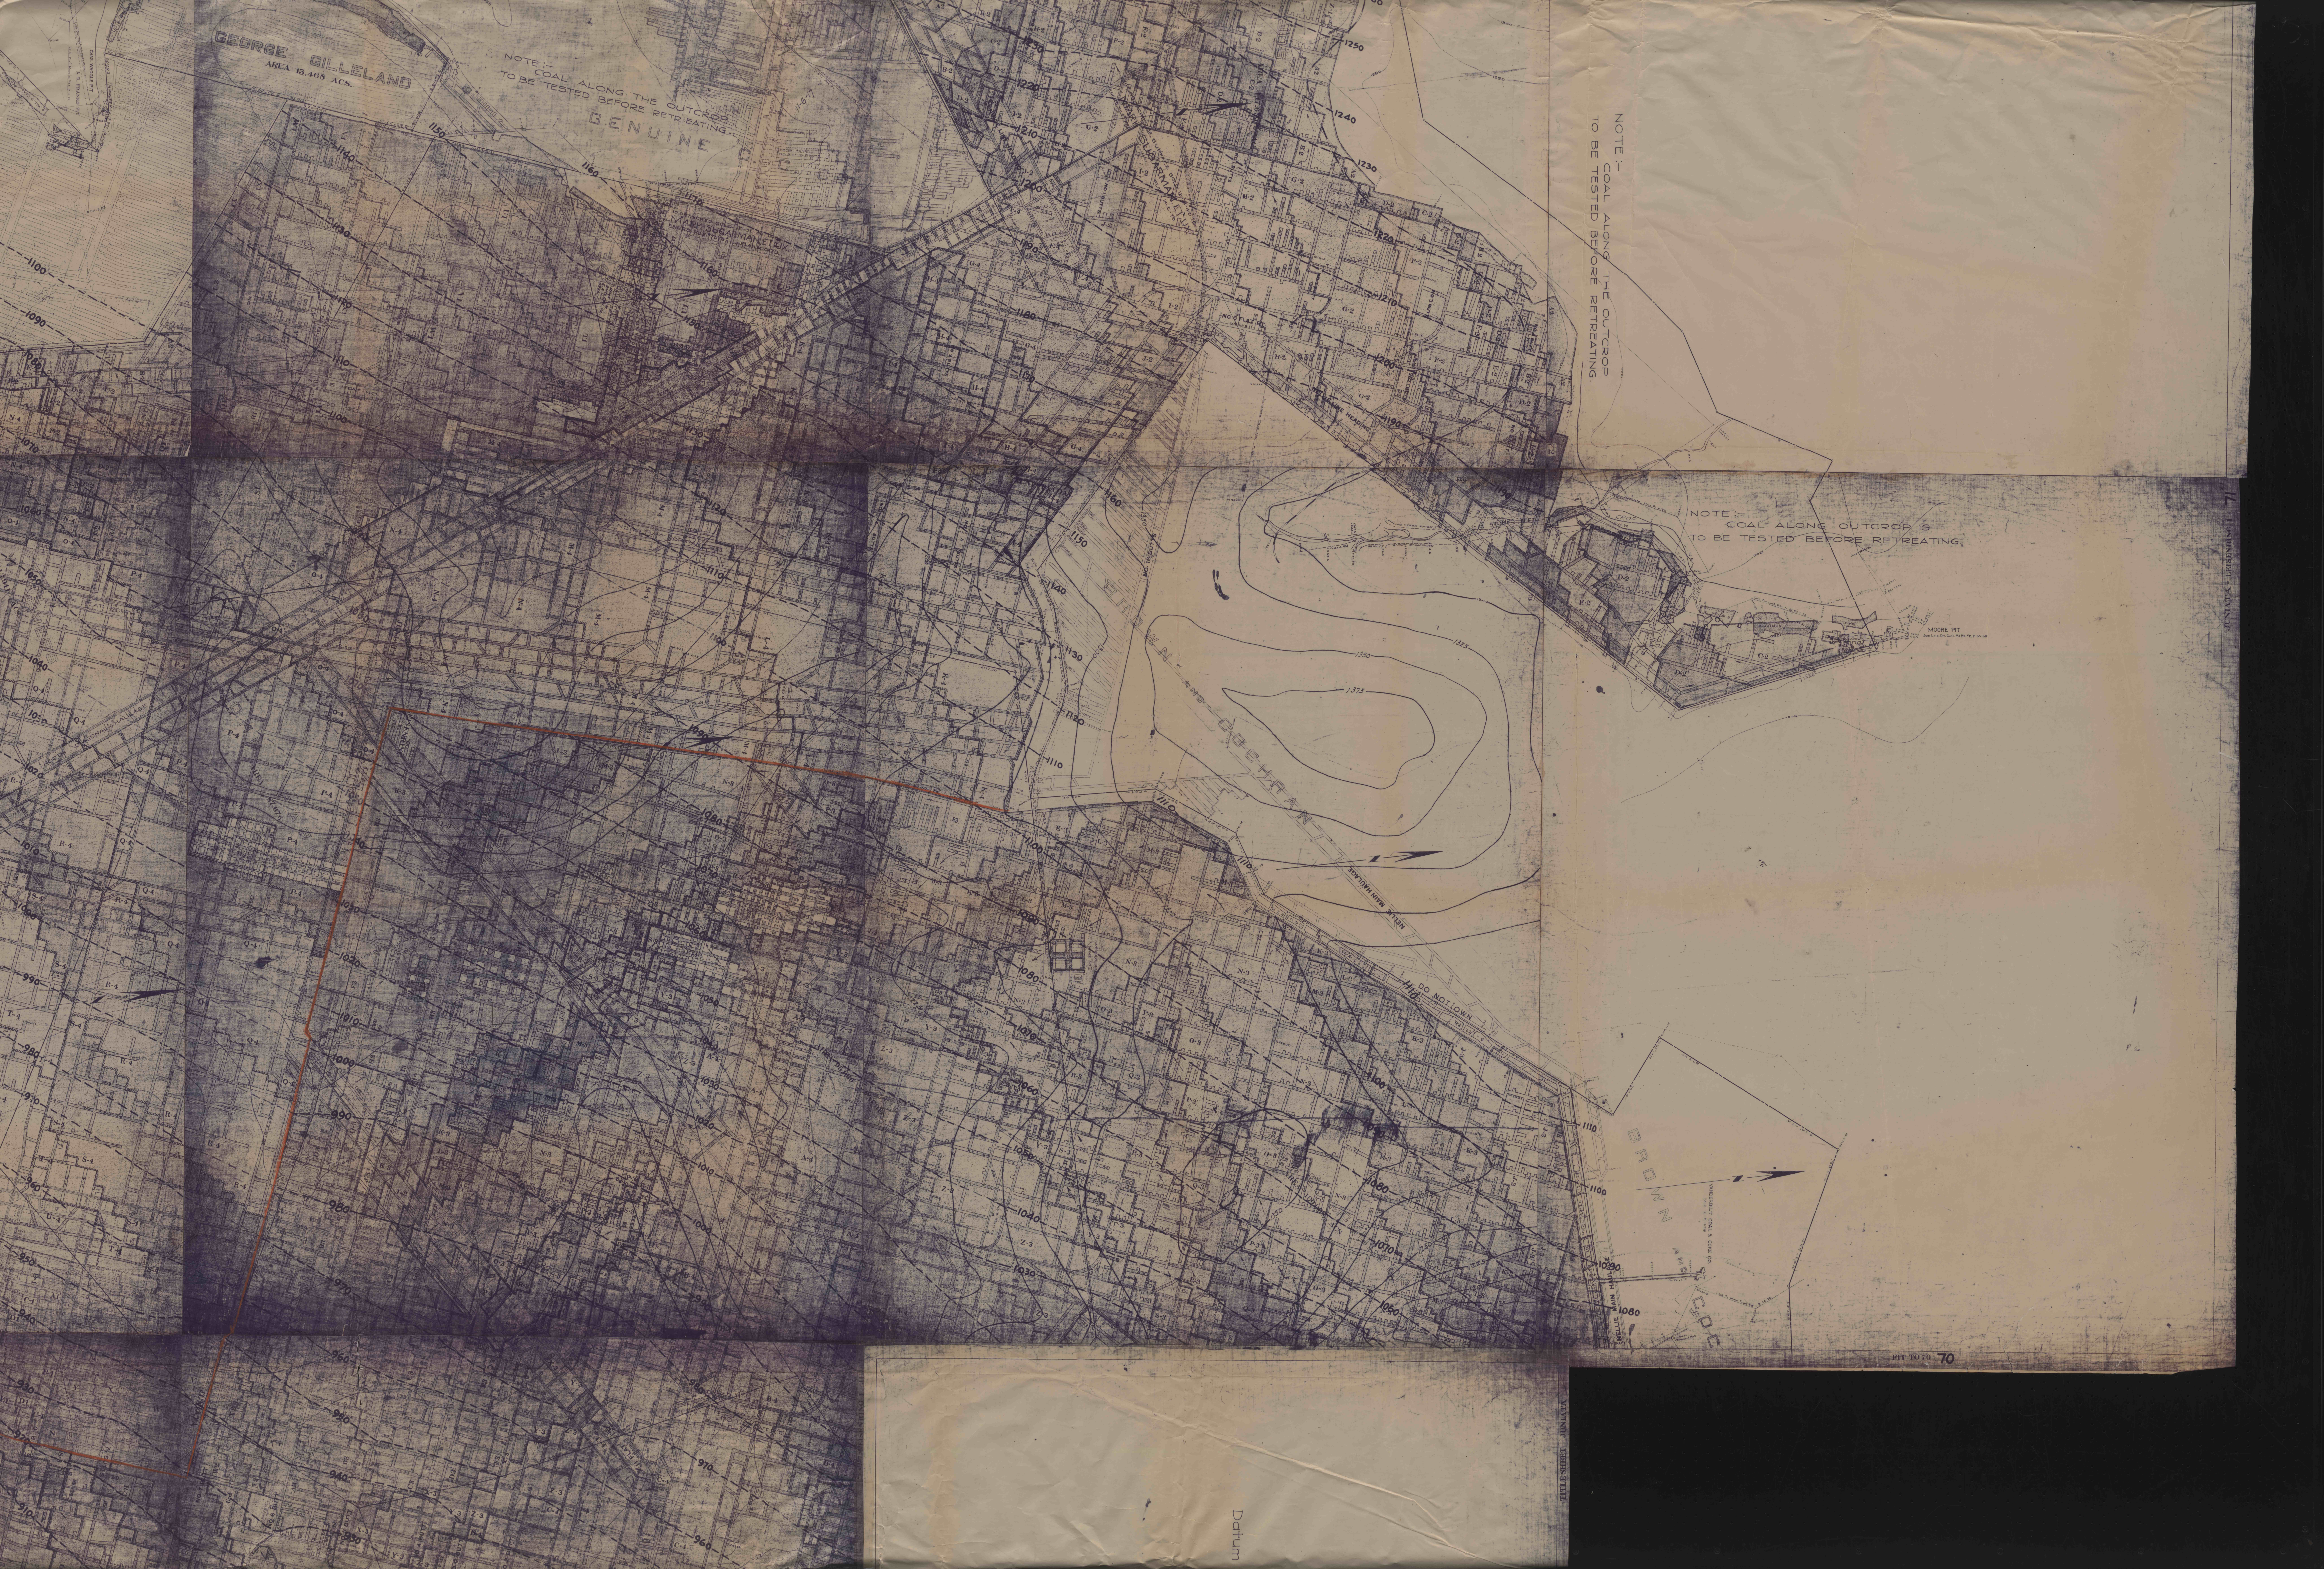

Datum

LITTLE SHEET, JUNIATA