



MAPLE GLEN

FOR DEVELOPMENT ONLY

NOTE: THIS EXCEPTION TO BLEEDER POLICY IS APPROVED ONLY FOR THIS LOCATION.

FROM THIS LOCATION LINE START TO DRILL TEST HOLES TOWARD ADJACENT MINE IN ACCORDANCE WITH MINING LAW.

FROM THIS LOCATION LINE START TO DRILL TEST HOLES IN ACCORDANCE WITH MINING LAW.

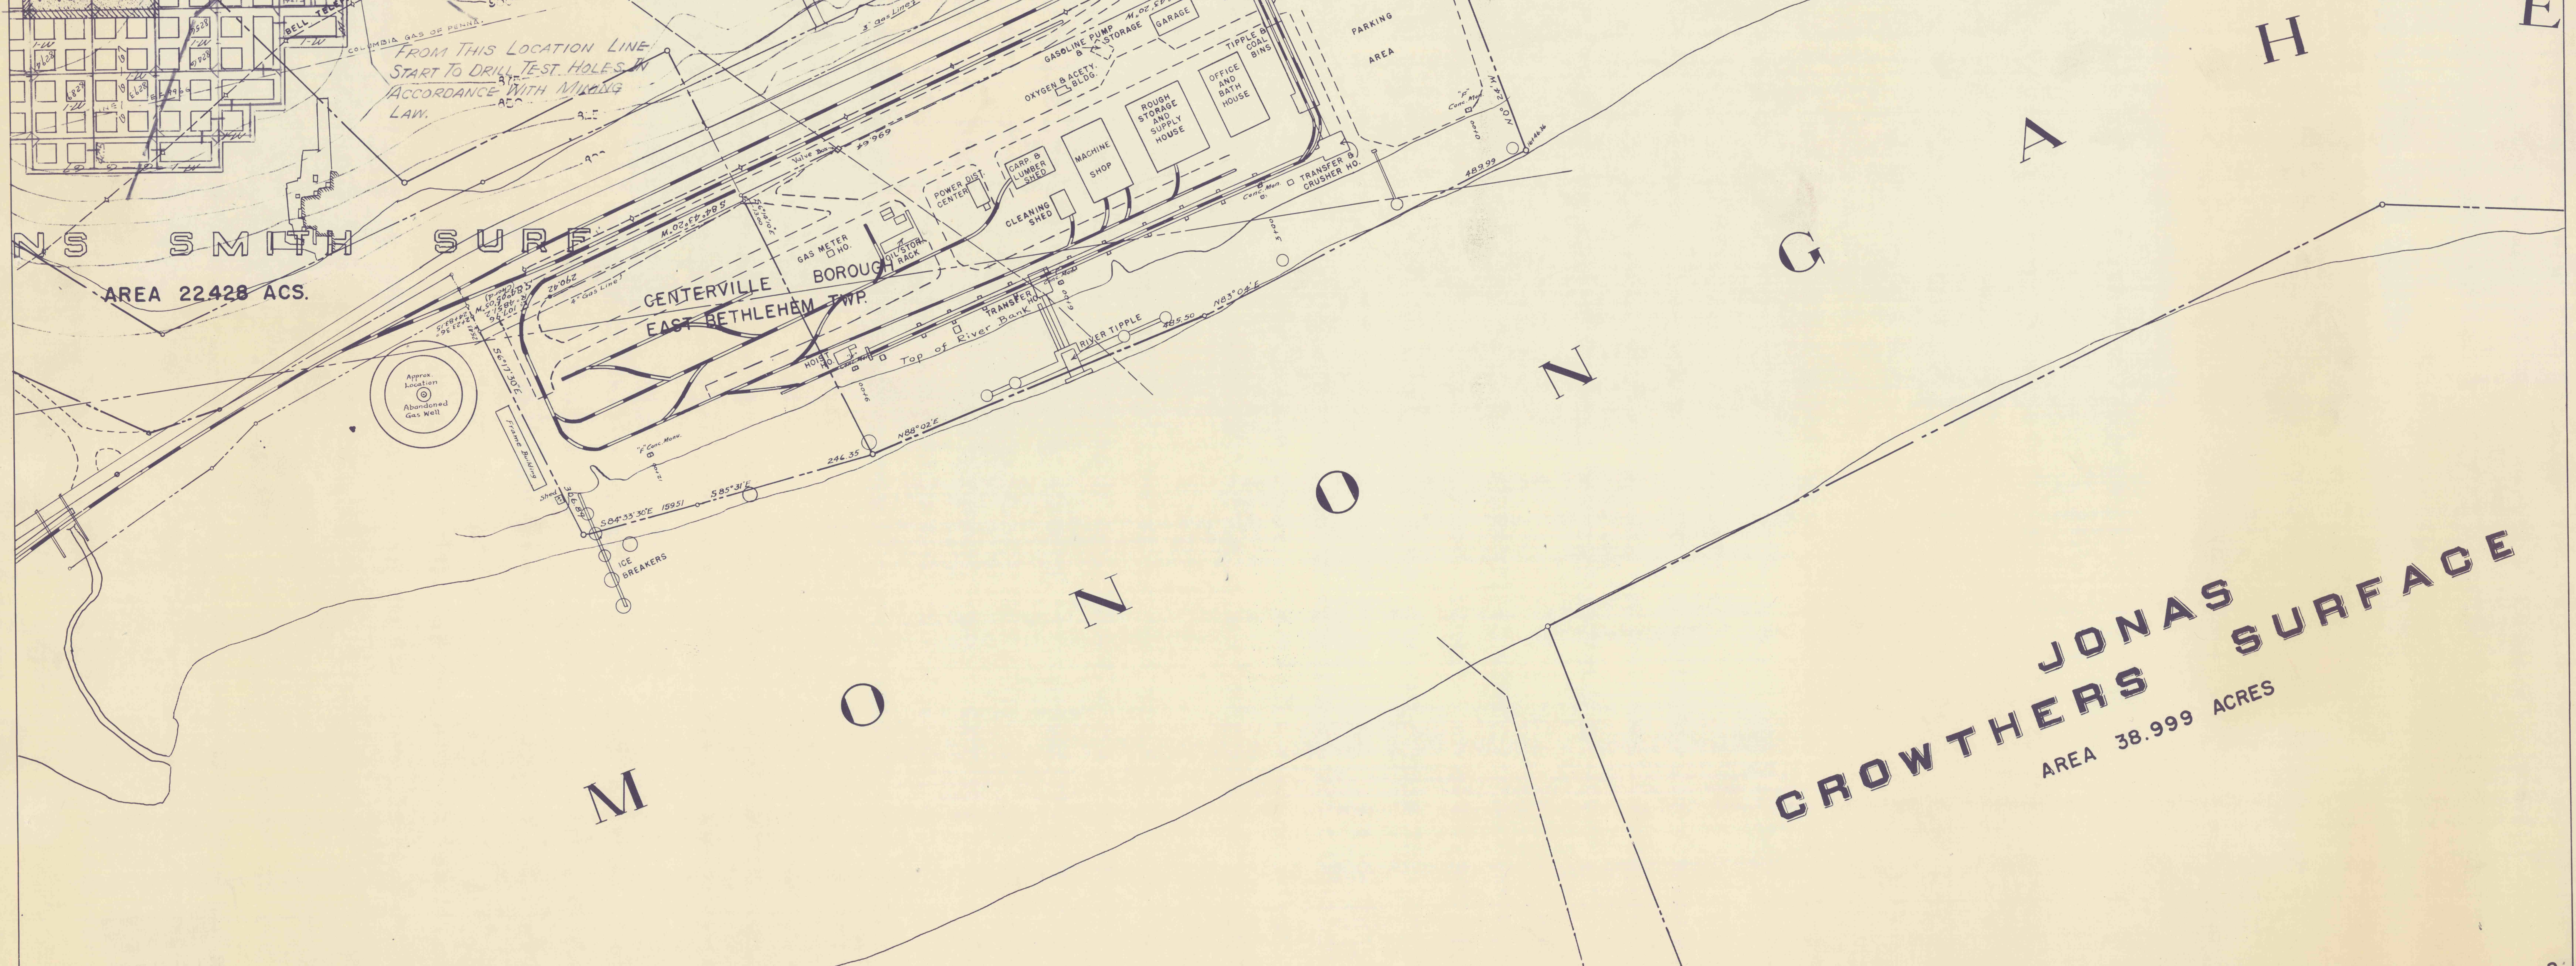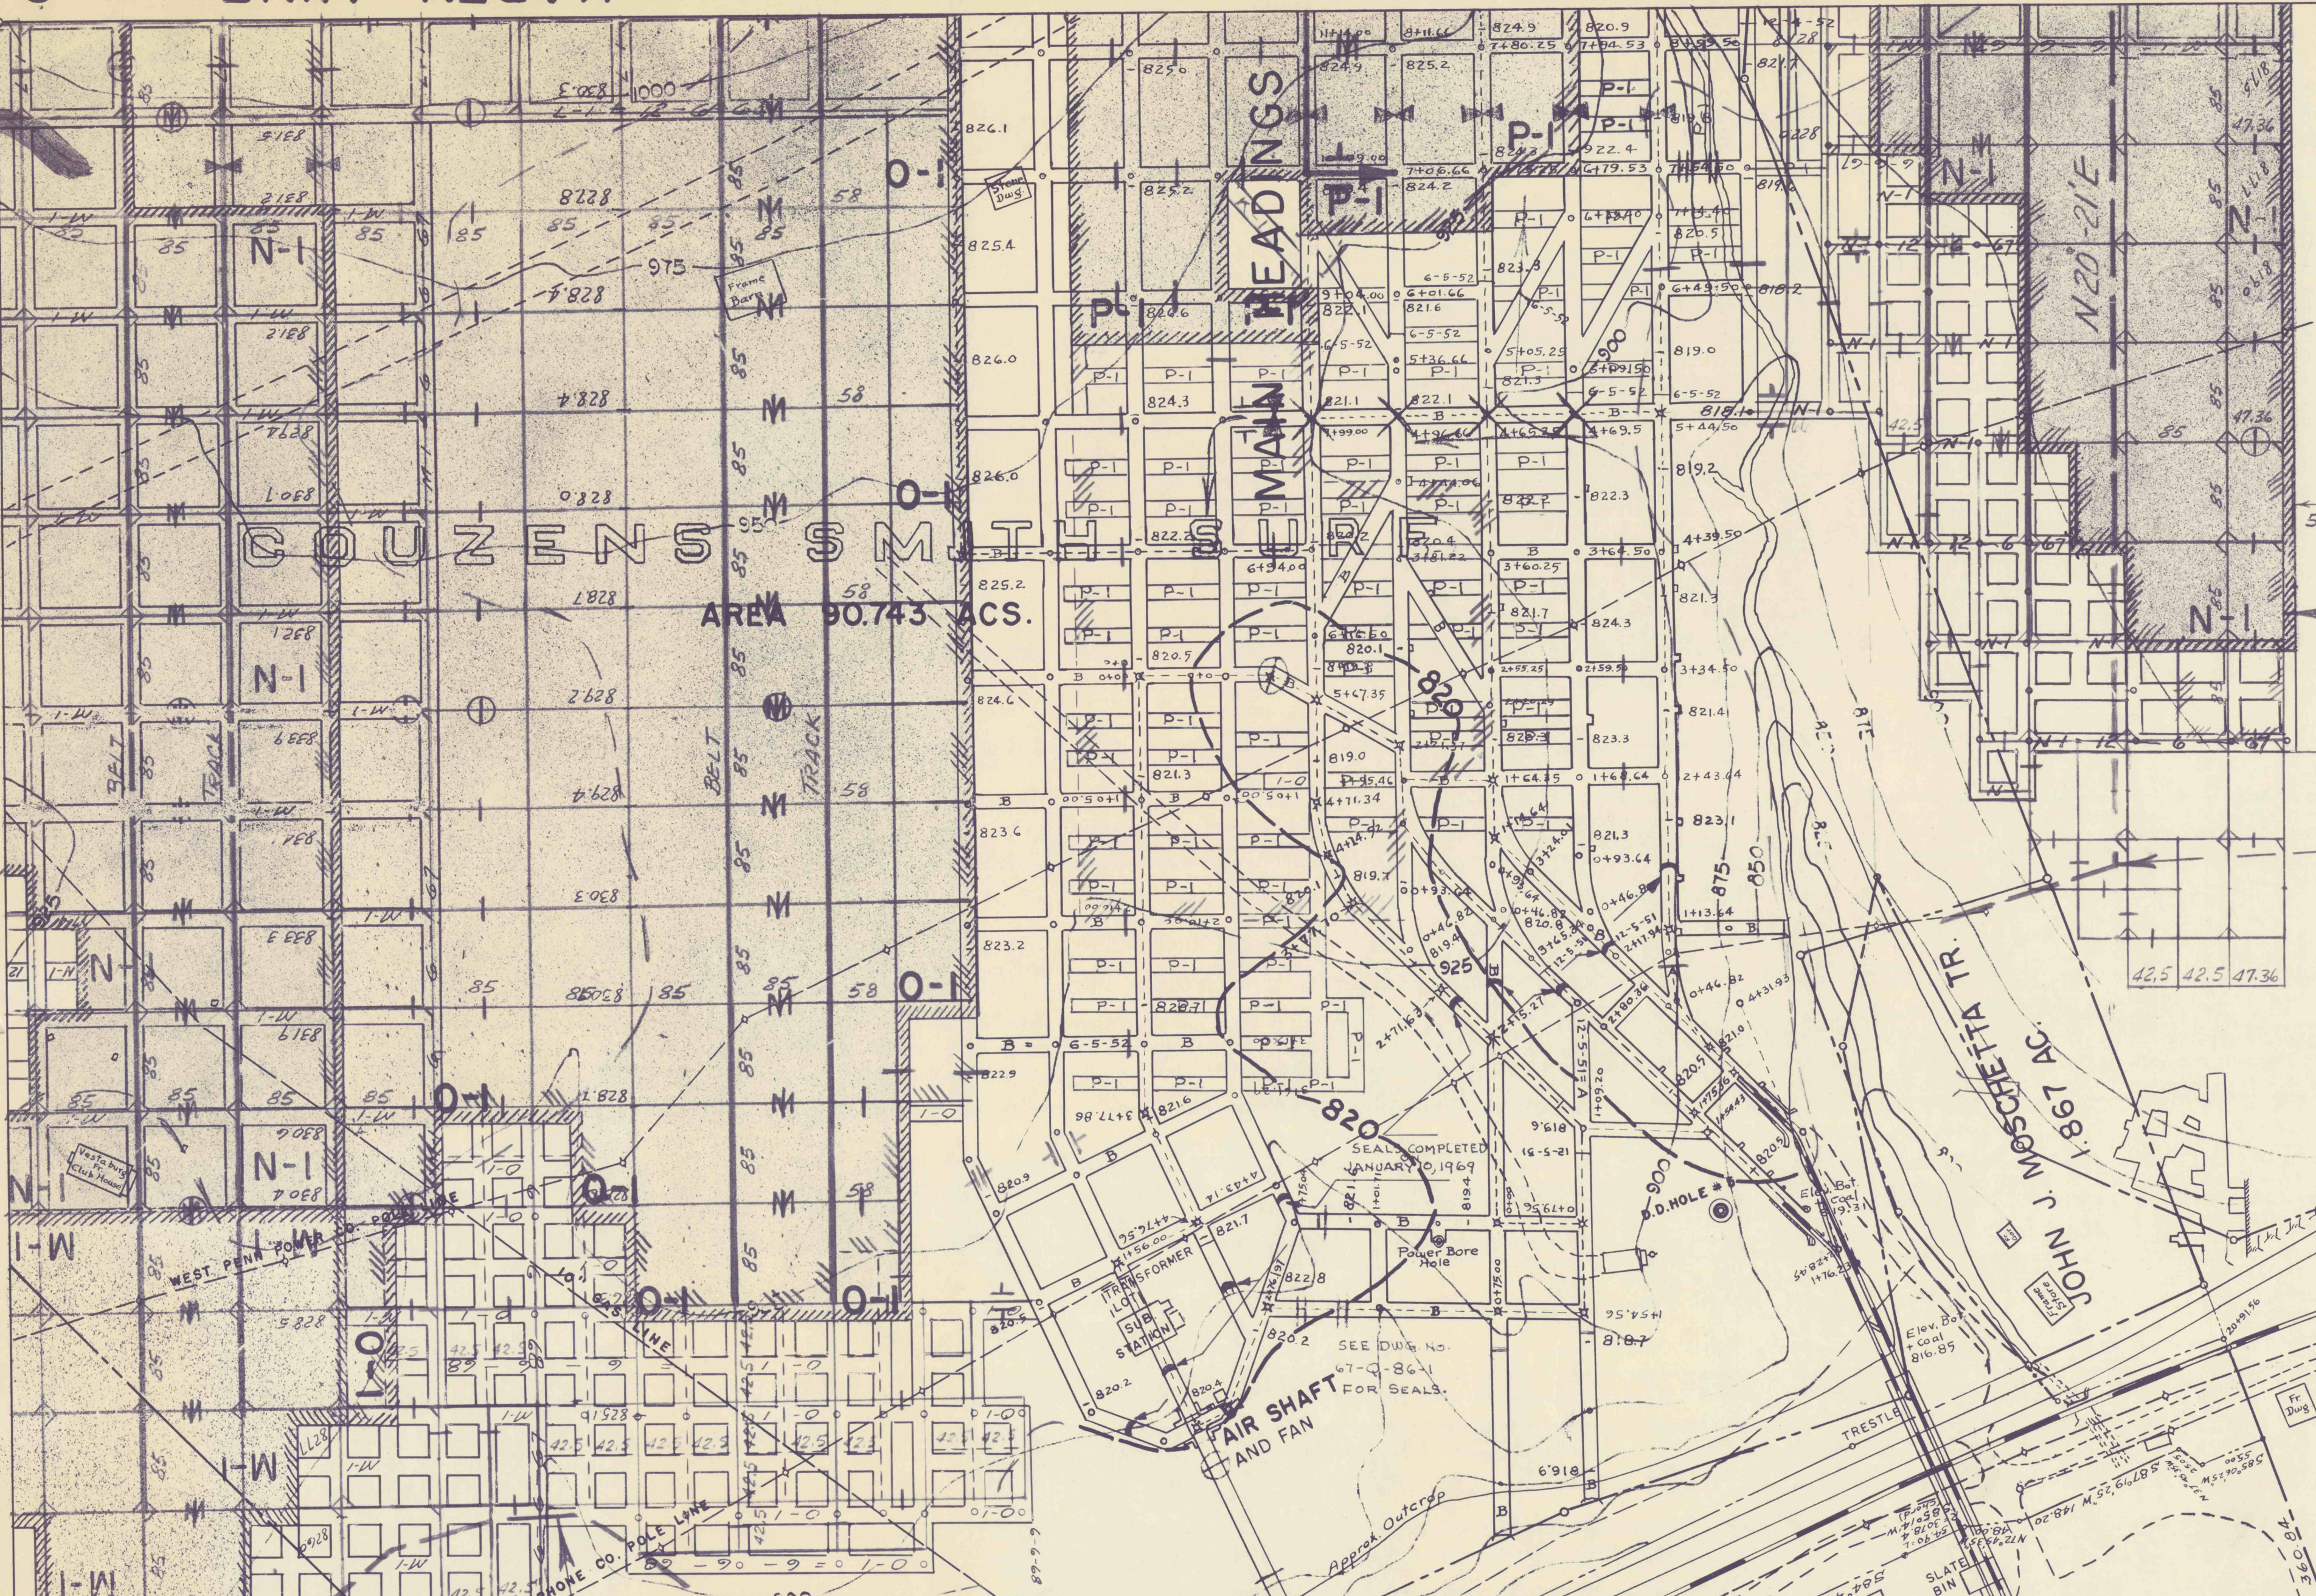

COUZENS SMITH AREA 90.743 ACS.

NS SMITH SURF AREA 22428 ACS.

GENERVILLE BOROUGH EAST BETHLEHEM TWP.

JONAS CROWTHERS SURFACE AREA 38.999 ACRES

FIT TO 1

FIT TO 3