


COAL CO.

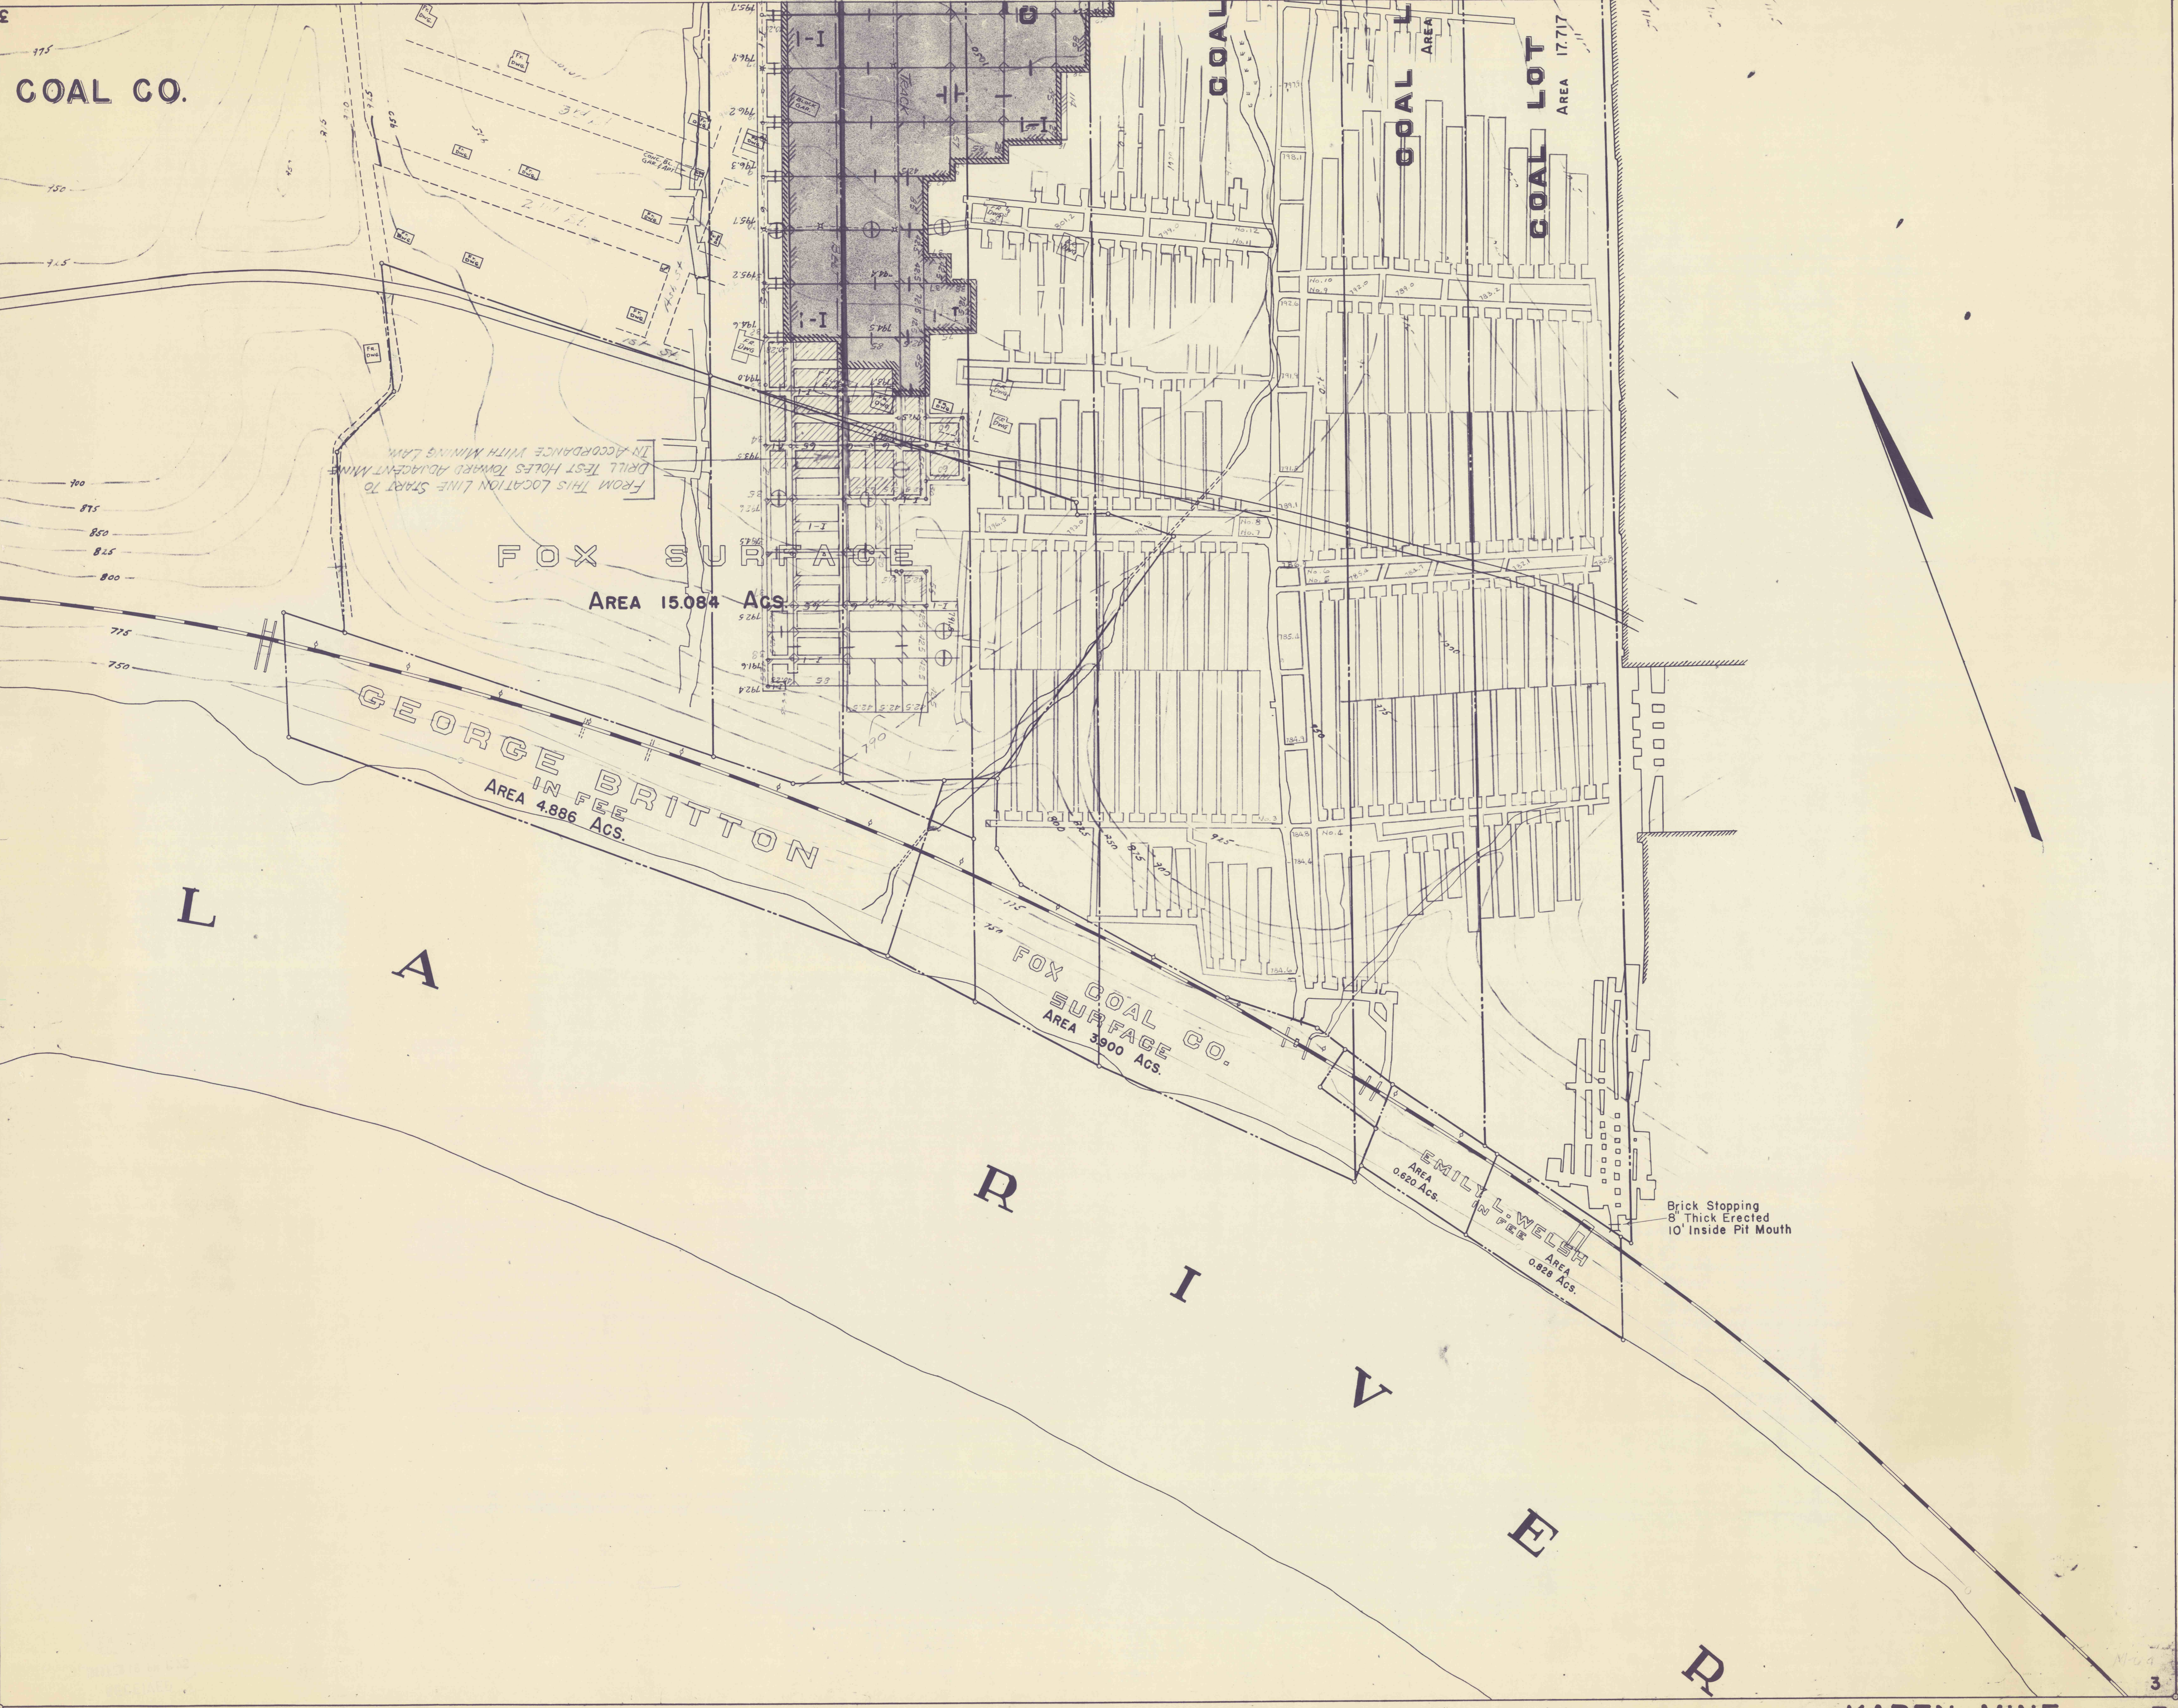

FROM THIS LOCATION LINE START TO
 DRILL TEST HOLES TOWARD ADJACENT MINE
 IN ACCORDANCE WITH MINING LAW

Brick Stopping
 8' Thick Erected
 10' Inside Pit Mouth