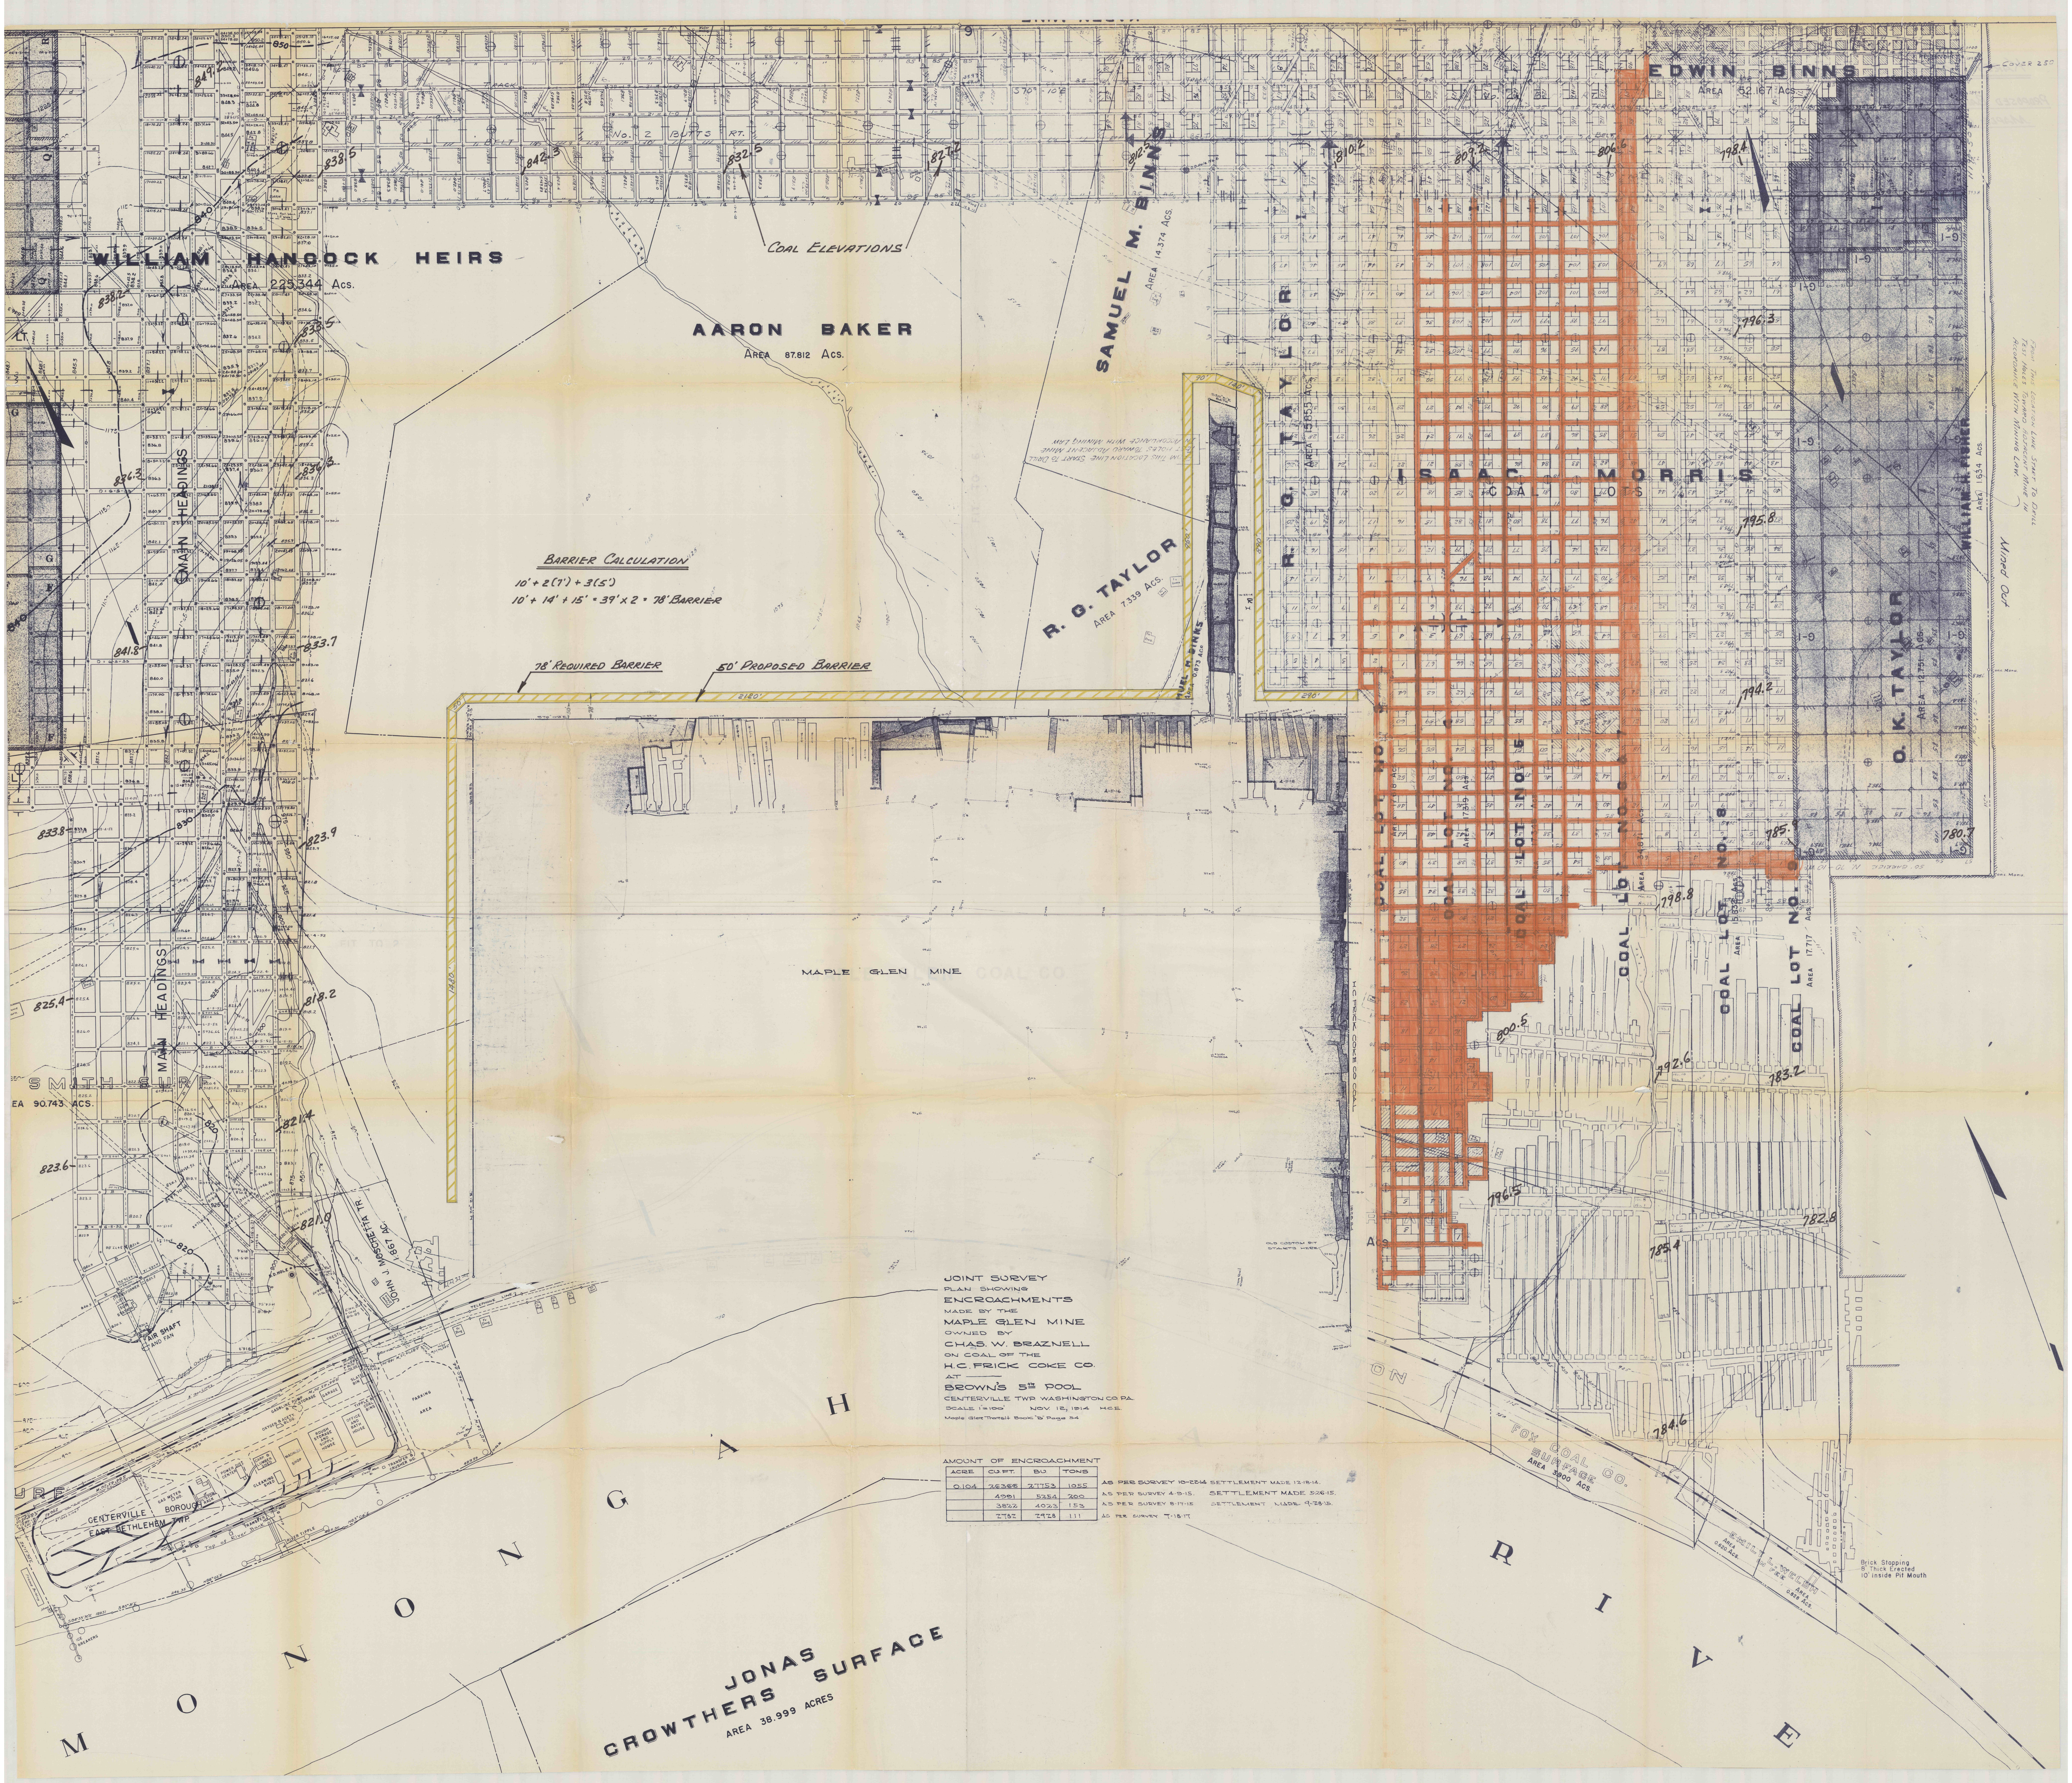
WILLIAM HANCOCK HEIRS
AREA 225.344 ACS.
AARON BAKER
AREA 87.812 ACS.
COAL ELEVATIONS
No. 2 BUTTS RT.
SAMUEL M. BINNS
AREA 14.374 ACS.
R. G. TAYLOR
AREA 15.855 ACS.
R. G. TAYLOR
AREA 7.339 ACS.
SAMUEL M. BINNS
AREA 0.873 ACS.
EDWIN BINNS
AREA 52.167 ACS.
ISAAC MORRIS
COAL LOTS
O. K. TAYLOR
AREA 12.751 ACS.
WILLIAM H. FISHER
AREA 1.634 ACS.
FROM THIS LOCATION LINE START TO DRILL TEST HOLES TOWARD ADJACENT MINE IN ACCORDANCE WITH MINING LAW.
Mined Out
COVER 250
BARRIER CALCULATION
10' + 2(7') + 3(5')
10' + 14' + 15' = 39' x 2 = 78' BARRIER
78' REQUIRED BARRIER
50' PROPOSED BARRIER
MAIN HEADINGS
MAIN HEADINGS
SMITH SURF.
AREA 90.743 ACS.
JOHN J. MOSCHETTA TR.
1.867 AC.
AIR SHAFT AND FAN
CENTERVILLE BOROUGH
EAST BETHLEHEM TWP.
PARKING AREA
MAPLE GLEN MINE
H.C. FRICK COKE CO. COAL
COAL LOT NO. 4
COAL LOT NO. 5
COAL LOT NO. 6
COAL LOT NO. 7
COAL LOT NO. 8
COAL LOT NO. 9
AREA 17.717 ACS.
OLD CUSTOM PIT STARTS HERE
FOX COAL CO. SURFACE
AREA 3.900 ACS.
EMILY L. WELSH
Brick Stopping 8" Thick Erected 10' Inside Pit Mouth
JONAS CROWTHERS SURFACE
AREA 38.999 ACRES
MONONGAHELA RIVER
JOINT SURVEY
PLAN SHOWING
ENCROACHMENTS
MADE BY THE
MAPLE GLEN MINE
OWNED BY
CHAS. W. BRAZNELL
ON COAL OF THE
H.C. FRICK COKE CO.
AT
BROWN'S 5TH POOL
CENTERVILLE TWP WASHINGTON CO. PA.
SCALE 1"=100' NOV. 12, 1914 H.C.E.
Maple Glen Transit Book "B" Page 34
AMOUNT OF ENCROACHMENT
ACRE | CU. FT. | BU. | TONS
0.104 | 26366 | 27753 | 1055 | AS PER SURVEY 10-22-14 SETTLEMENT MADE 12-18-14.
| 4991 | 5254 | 200 | AS PER SURVEY 4-9-15. SETTLEMENT MADE 5-26-15.
| 3822 | 4023 | 153 | AS PER SURVEY 8-17-15 SETTLEMENT MADE 9-28-15.
| 2782 | 2928 | 111 | AS PER SURVEY 7-18-17