


Sheet 1 of 5
310 081

JANE M^cELROY

JANE M^cELROY

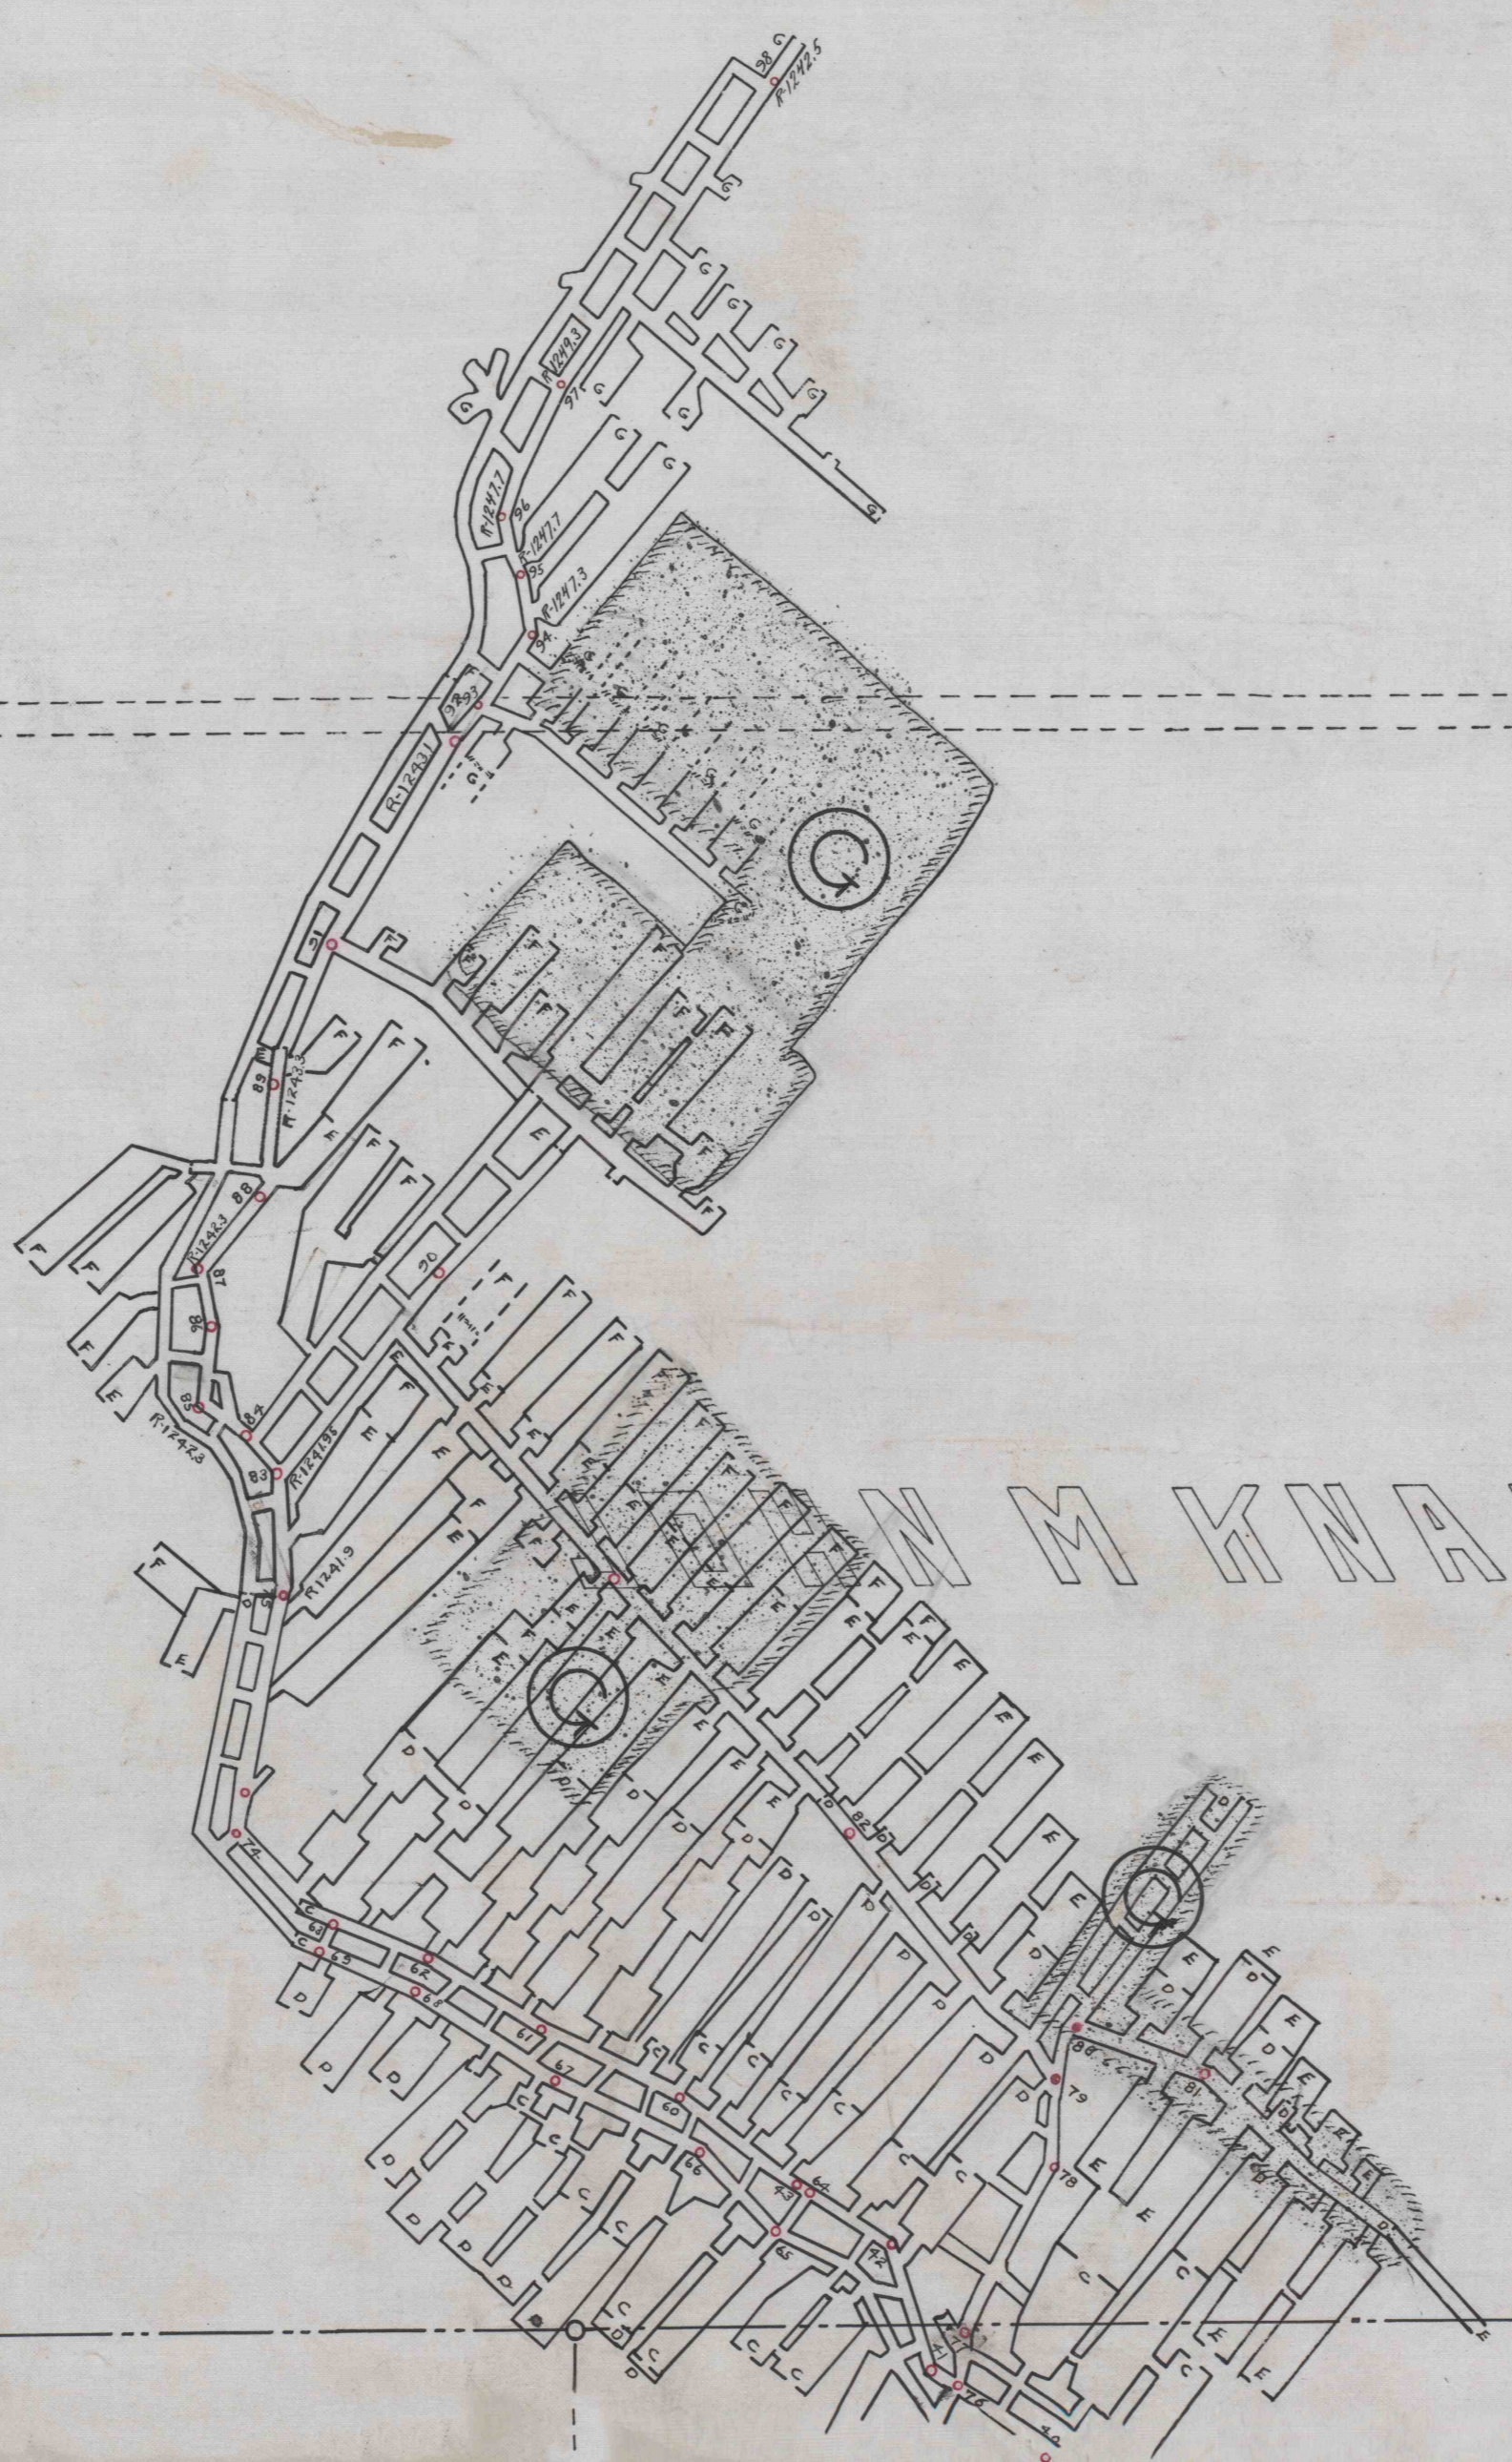

N M KNAUFF

*
F17