

Geo. Keisling


# H.A. KEISLING COAL

Collier Twp., Alleg. Co., Pa. #1

Scale: 1" = 100' Sept. 1934. O.B. Higley, Engr.

June 19<sup>th</sup> 20<sup>th</sup> 1935 O.B. Higley, Engr. *Christ's Keisling*

I hereby certify this Plan to be correct.  
O.B. Higley.

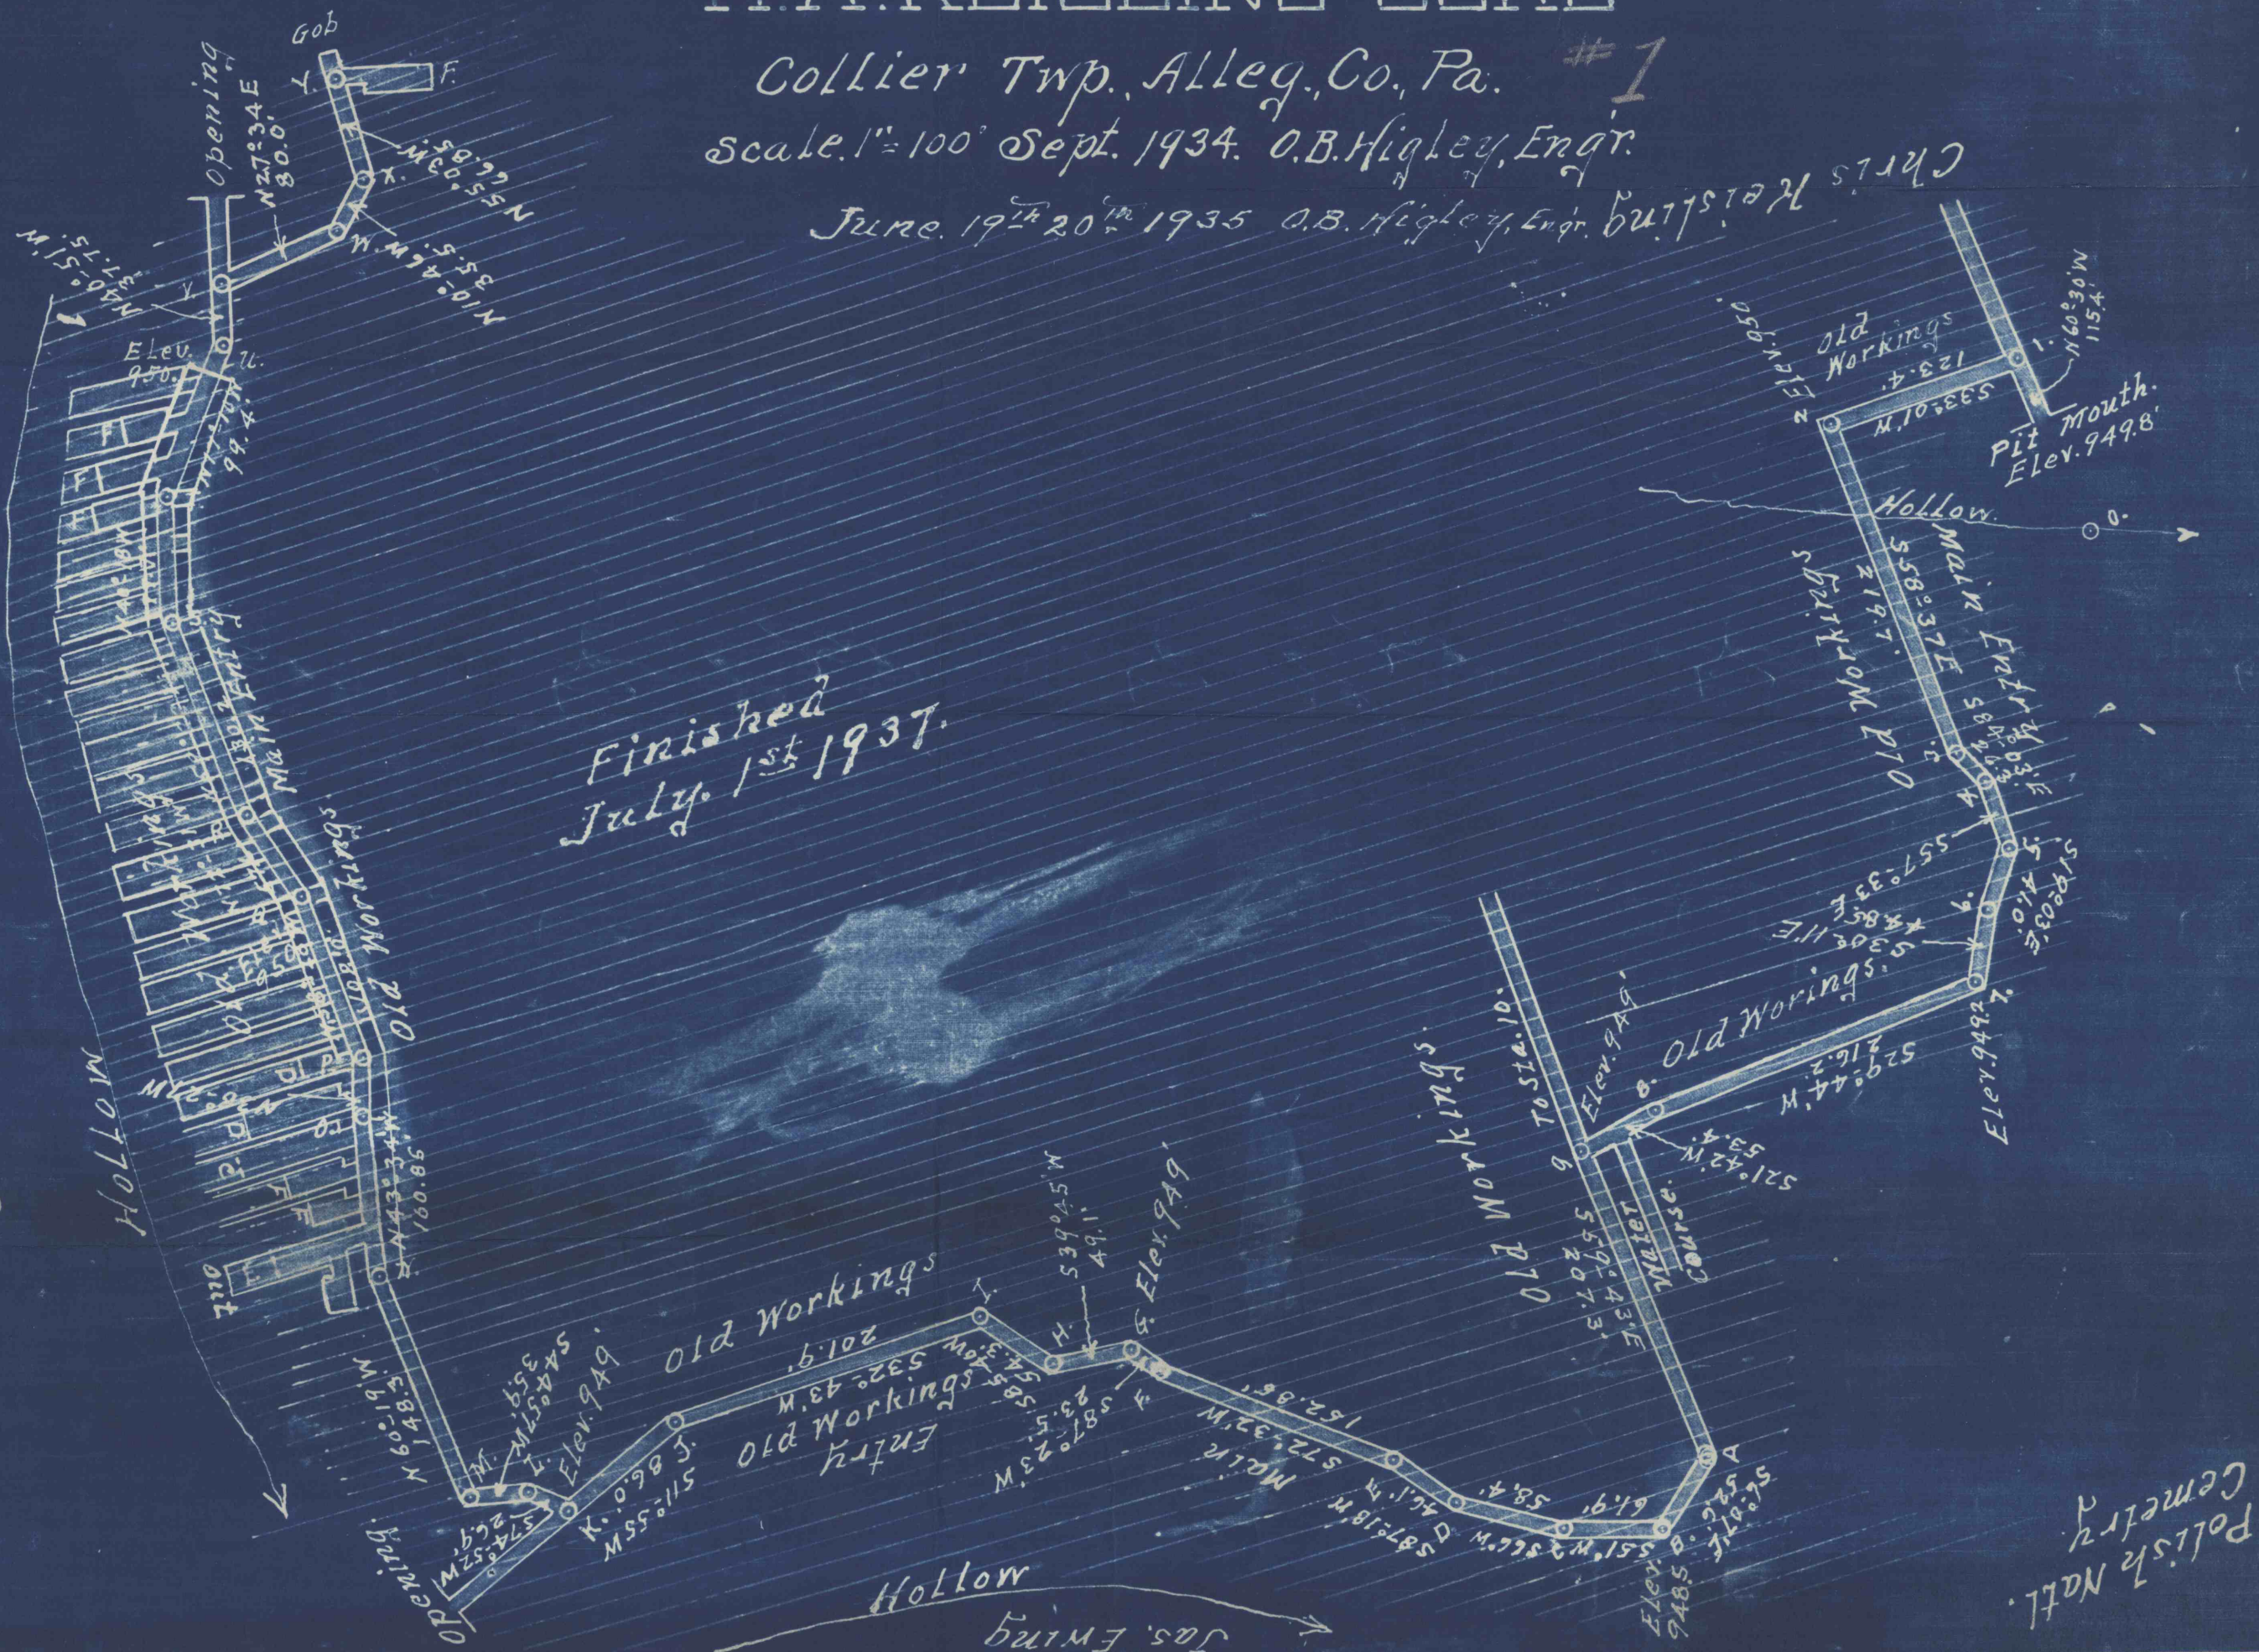

Finished July 1st 1937.

Geo. Keisling

Public Road

Polish Natl. Cemetery