

AND NEW
**MAP
OLD WORKINGS ON KELLY SEAM
E. EICHELBERGER & CO.**

BROADTOP TOWNSHIP — BEDFORD COUNTY

Scale: 1" = 100'

— 1944 —

Guy C. Askey, Min. Engr.
Bedford, Pa.


AND NEW WORKINGS OF BACON No. 7
OPERATED BY: MARTIN, MCINTYRE & MCKNIGHT
Revised to _____

Note: Kelly Seam workings shown on this map
were traced from old maps by G. C. Lemon,
Aug. 1933, et al., furnished by George Eichelberger
Bedford, Pa.

RIDDLESBURG MATERIALS CORP.

E. EICHELBERGER & CO.
Wigton Tract

LANGDON COAL CO.

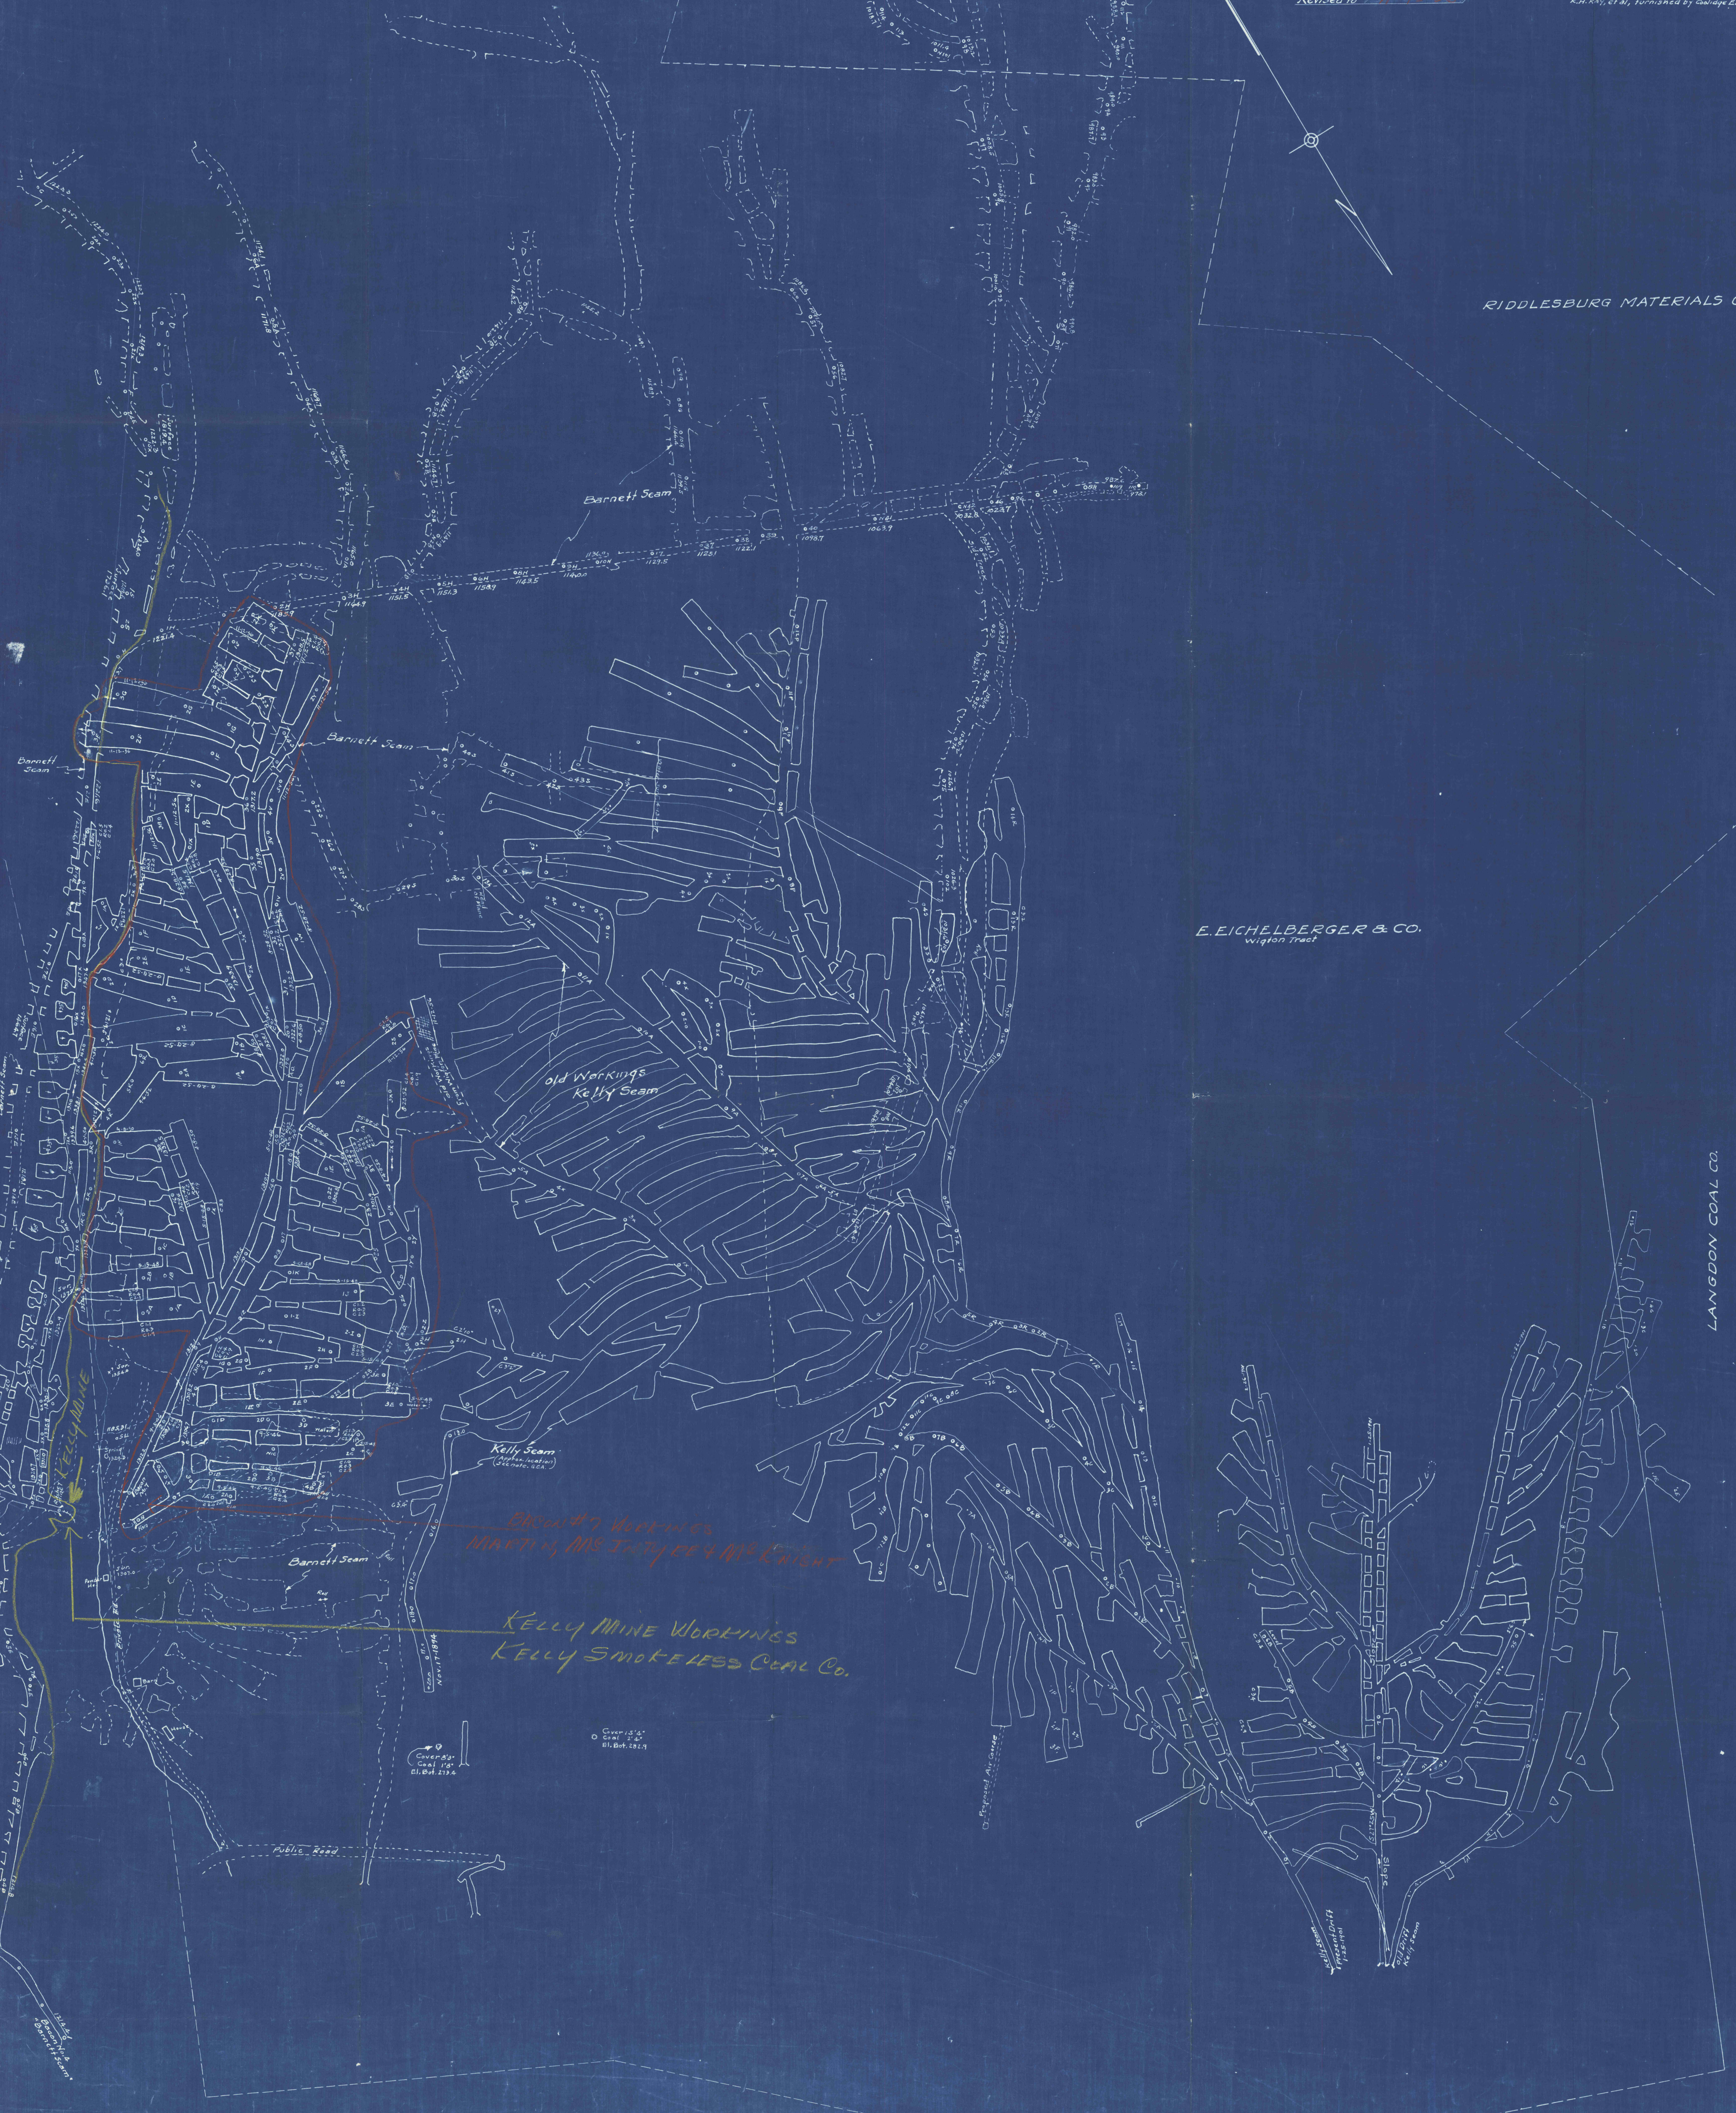

Bacon #7 Workings
Martin, McIntyre & McKnight

Kelly Mine Workings
Kelly Smokeless Coal Co.

Survey
1917-1918
1920-1921
1922-1923

