


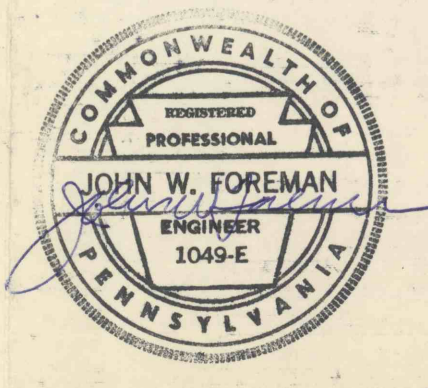

MAP SHOWING
KENNER COAL CO.
 SITUATE IN
 GALLITZIN TWP., CAMBRIA CO., PA.
 SCALE: 1 IN. = 100 FT.

*Final map
 Not sealed*

NOTE:
 ORIGINAL MAP PREPARED BY
 SILIMAN ENGINEERS, ALTOONA, PA.
 SURVEYS OF THE FOLLOWING DATES
 BY JOHN W. FOREMAN, MINING ENGINEER,
 LEWIS L. GWIN - CONSULTING ENGINEERS,
 ALTOONA, PA.
 DATE OF SURVEY
 MARCH 16, 1957
 JUNE 19, 1961
 MAY 24, 1968 RETREAT MINING INFORMATION FURNISHED BY MR. H.C. KENNER



#1462
 8-12-99
 C.C.