


A.R. KINTER

W.C. MEARS

D. KIRKLAND

C.E. MEARS

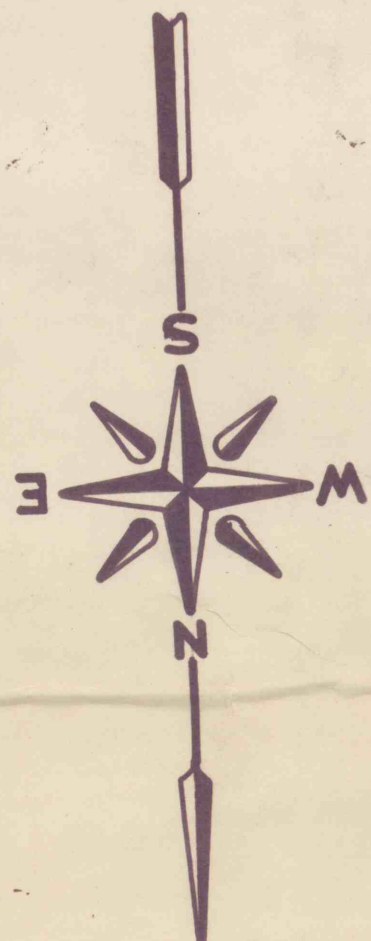

ABANDONED MINE

CROOKED CREEK COAL COMPANY  
KERRY NO. 1 MINE  
LOWER FREEPORT COAL SEAM  
RAYNE TOWNSHIP-INDIANA COUNTY-PENNSYLVANIA  
SCALE 1" = 100'  
SURVEY DATE 2-15-72

CONTEMPLATED MINING \_\_\_\_\_ TO \_\_\_\_\_  
 SIX MONTH EXTRACTION \_\_\_\_\_ TO \_\_\_\_\_  
 REVISED ADDITIONS \_\_\_\_\_ TO \_\_\_\_\_

JOHN C. PASSMORE - SURVEYOR

SEAL

Signed John C. Passmore

I CERTIFY THAT THIS MAP IS A TRUE AND CORRECT COPY OF THE ORIGINAL MINE TRACING AND THAT THE WORKINGS HERE ARE MADE FROM CORRECT SURVEYS MADE BY JOHN C. PASSMORE COMPANY.  
*John C. Passmore*

