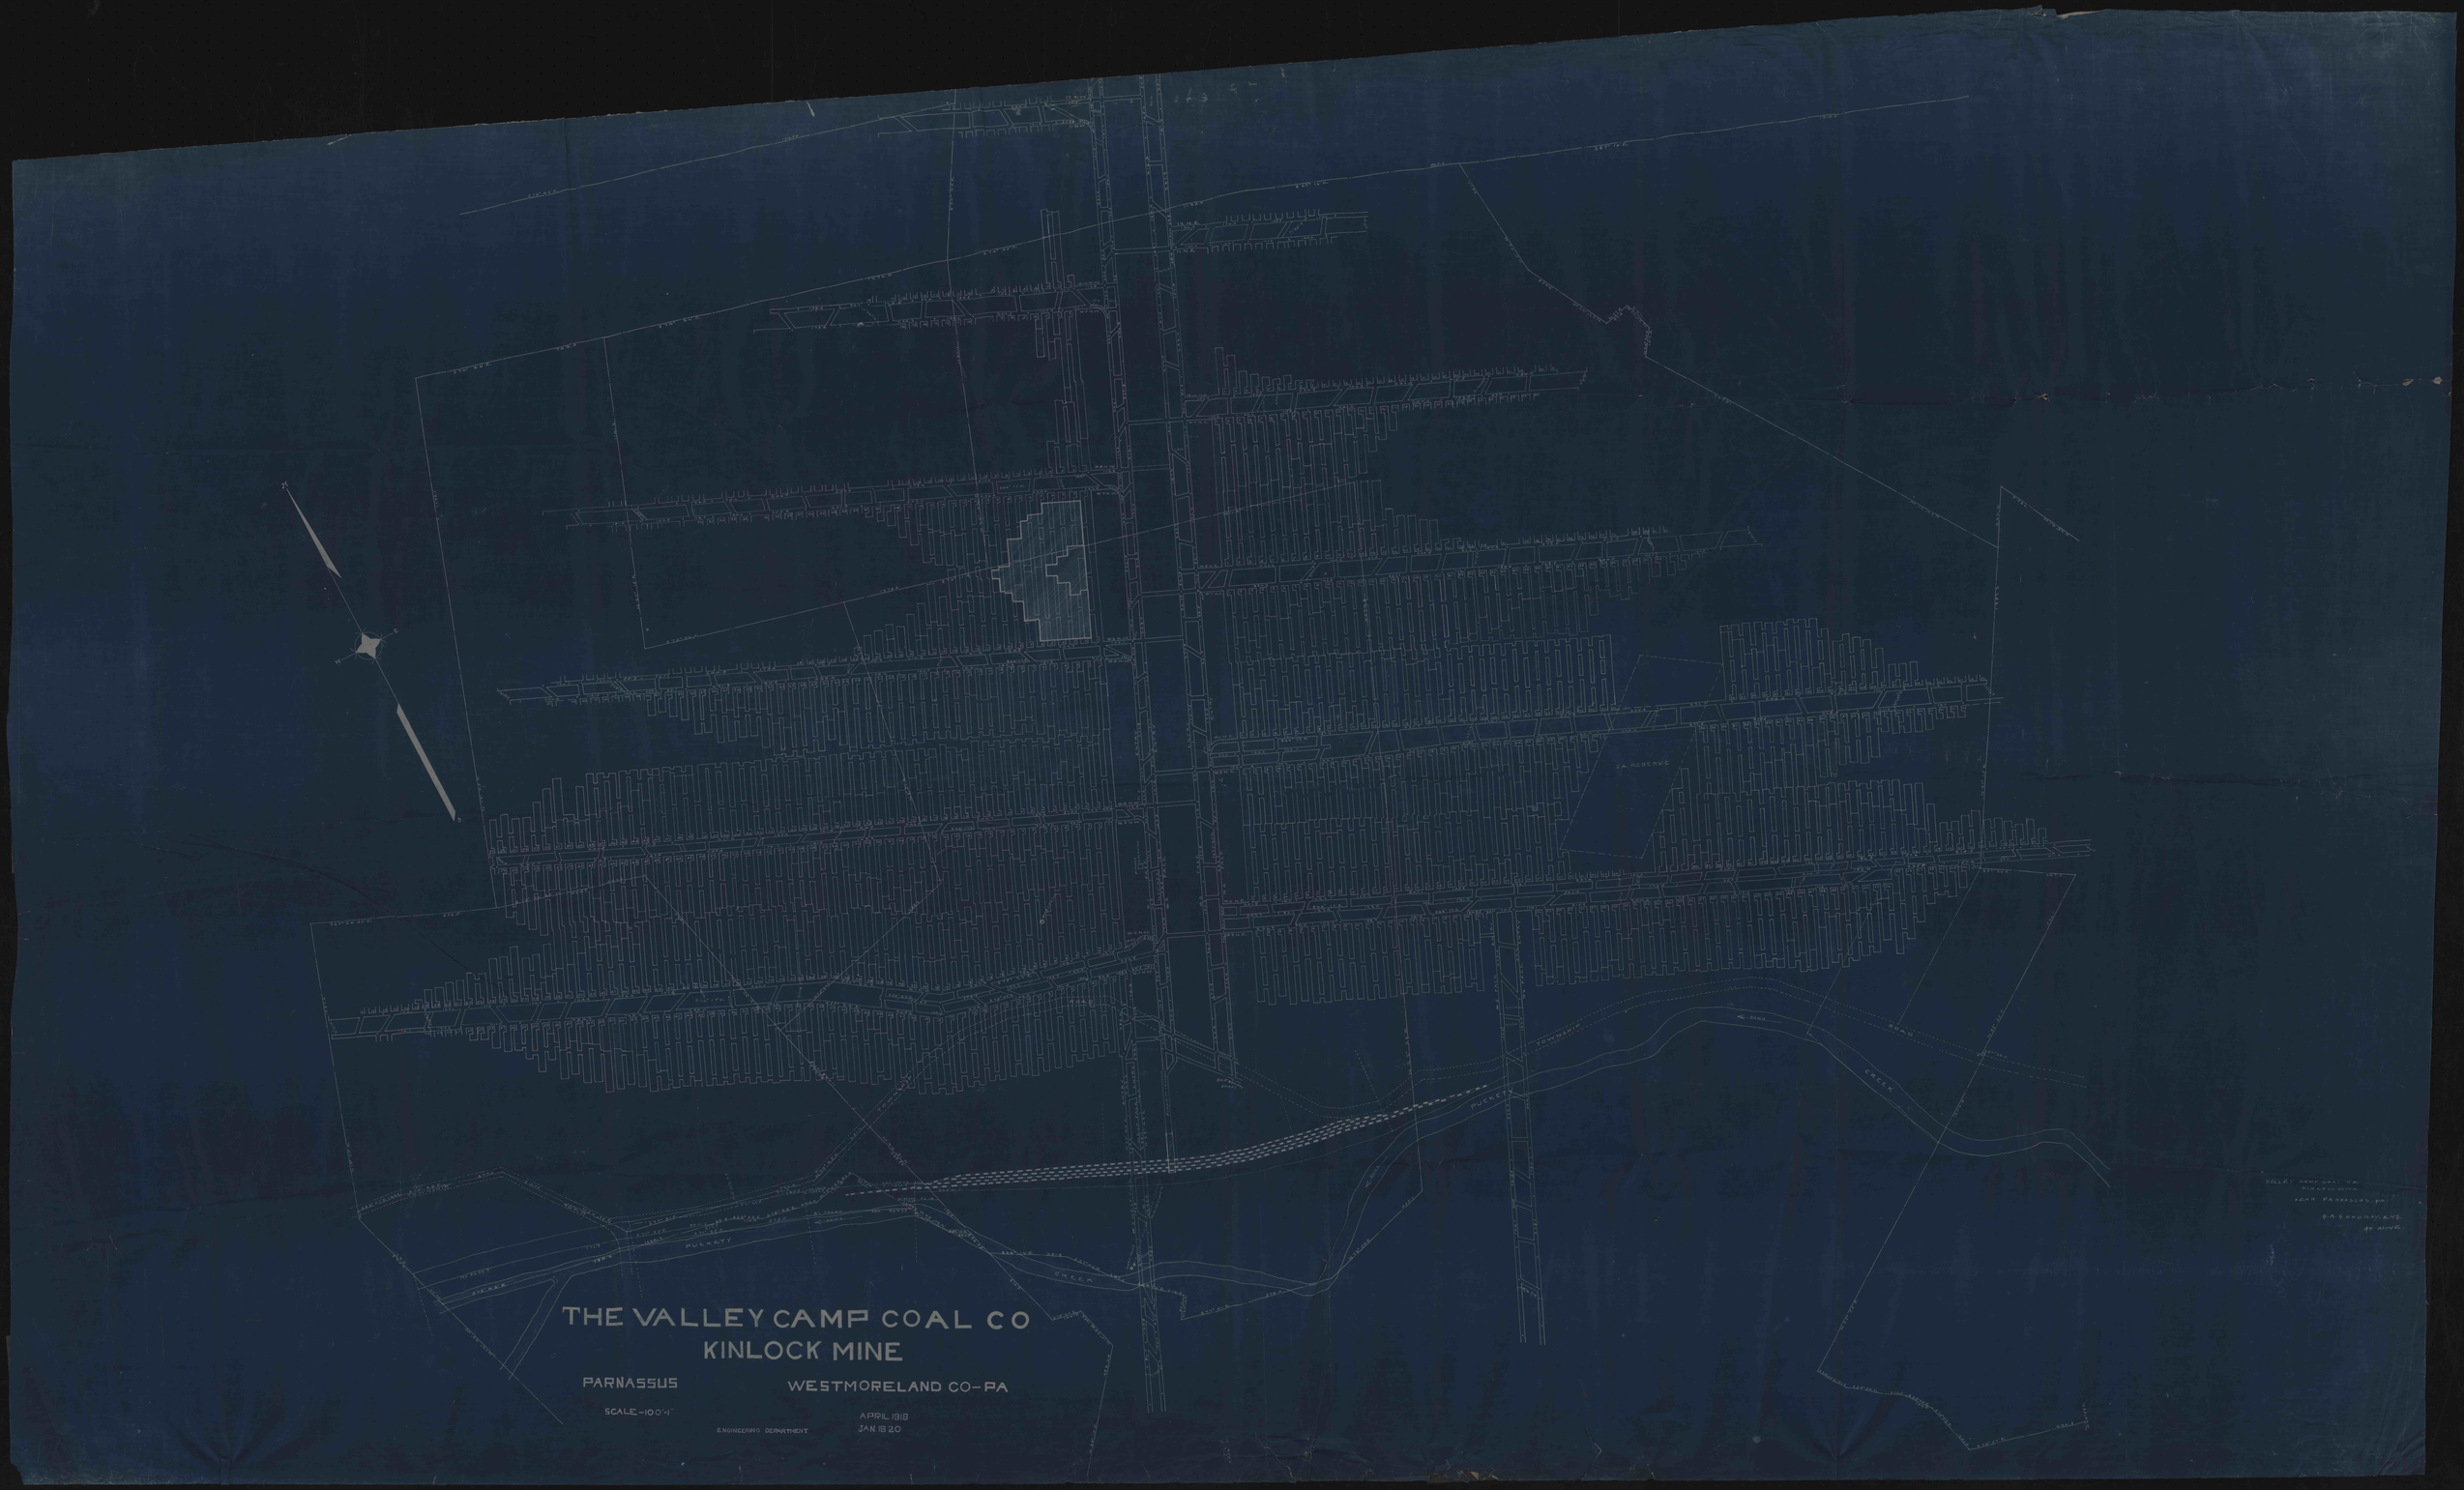
THE VALLEY CAMP COAL CO
KINLOCK MINE
PARNASSUS
WESTMORELAND CO-PA
SCALE-100'=1"
ENGINEERING DEPARTMENT
APRIL 1918
JAN 1920
PUCKETY
CREEK
ROAD
S.A. RESERVE