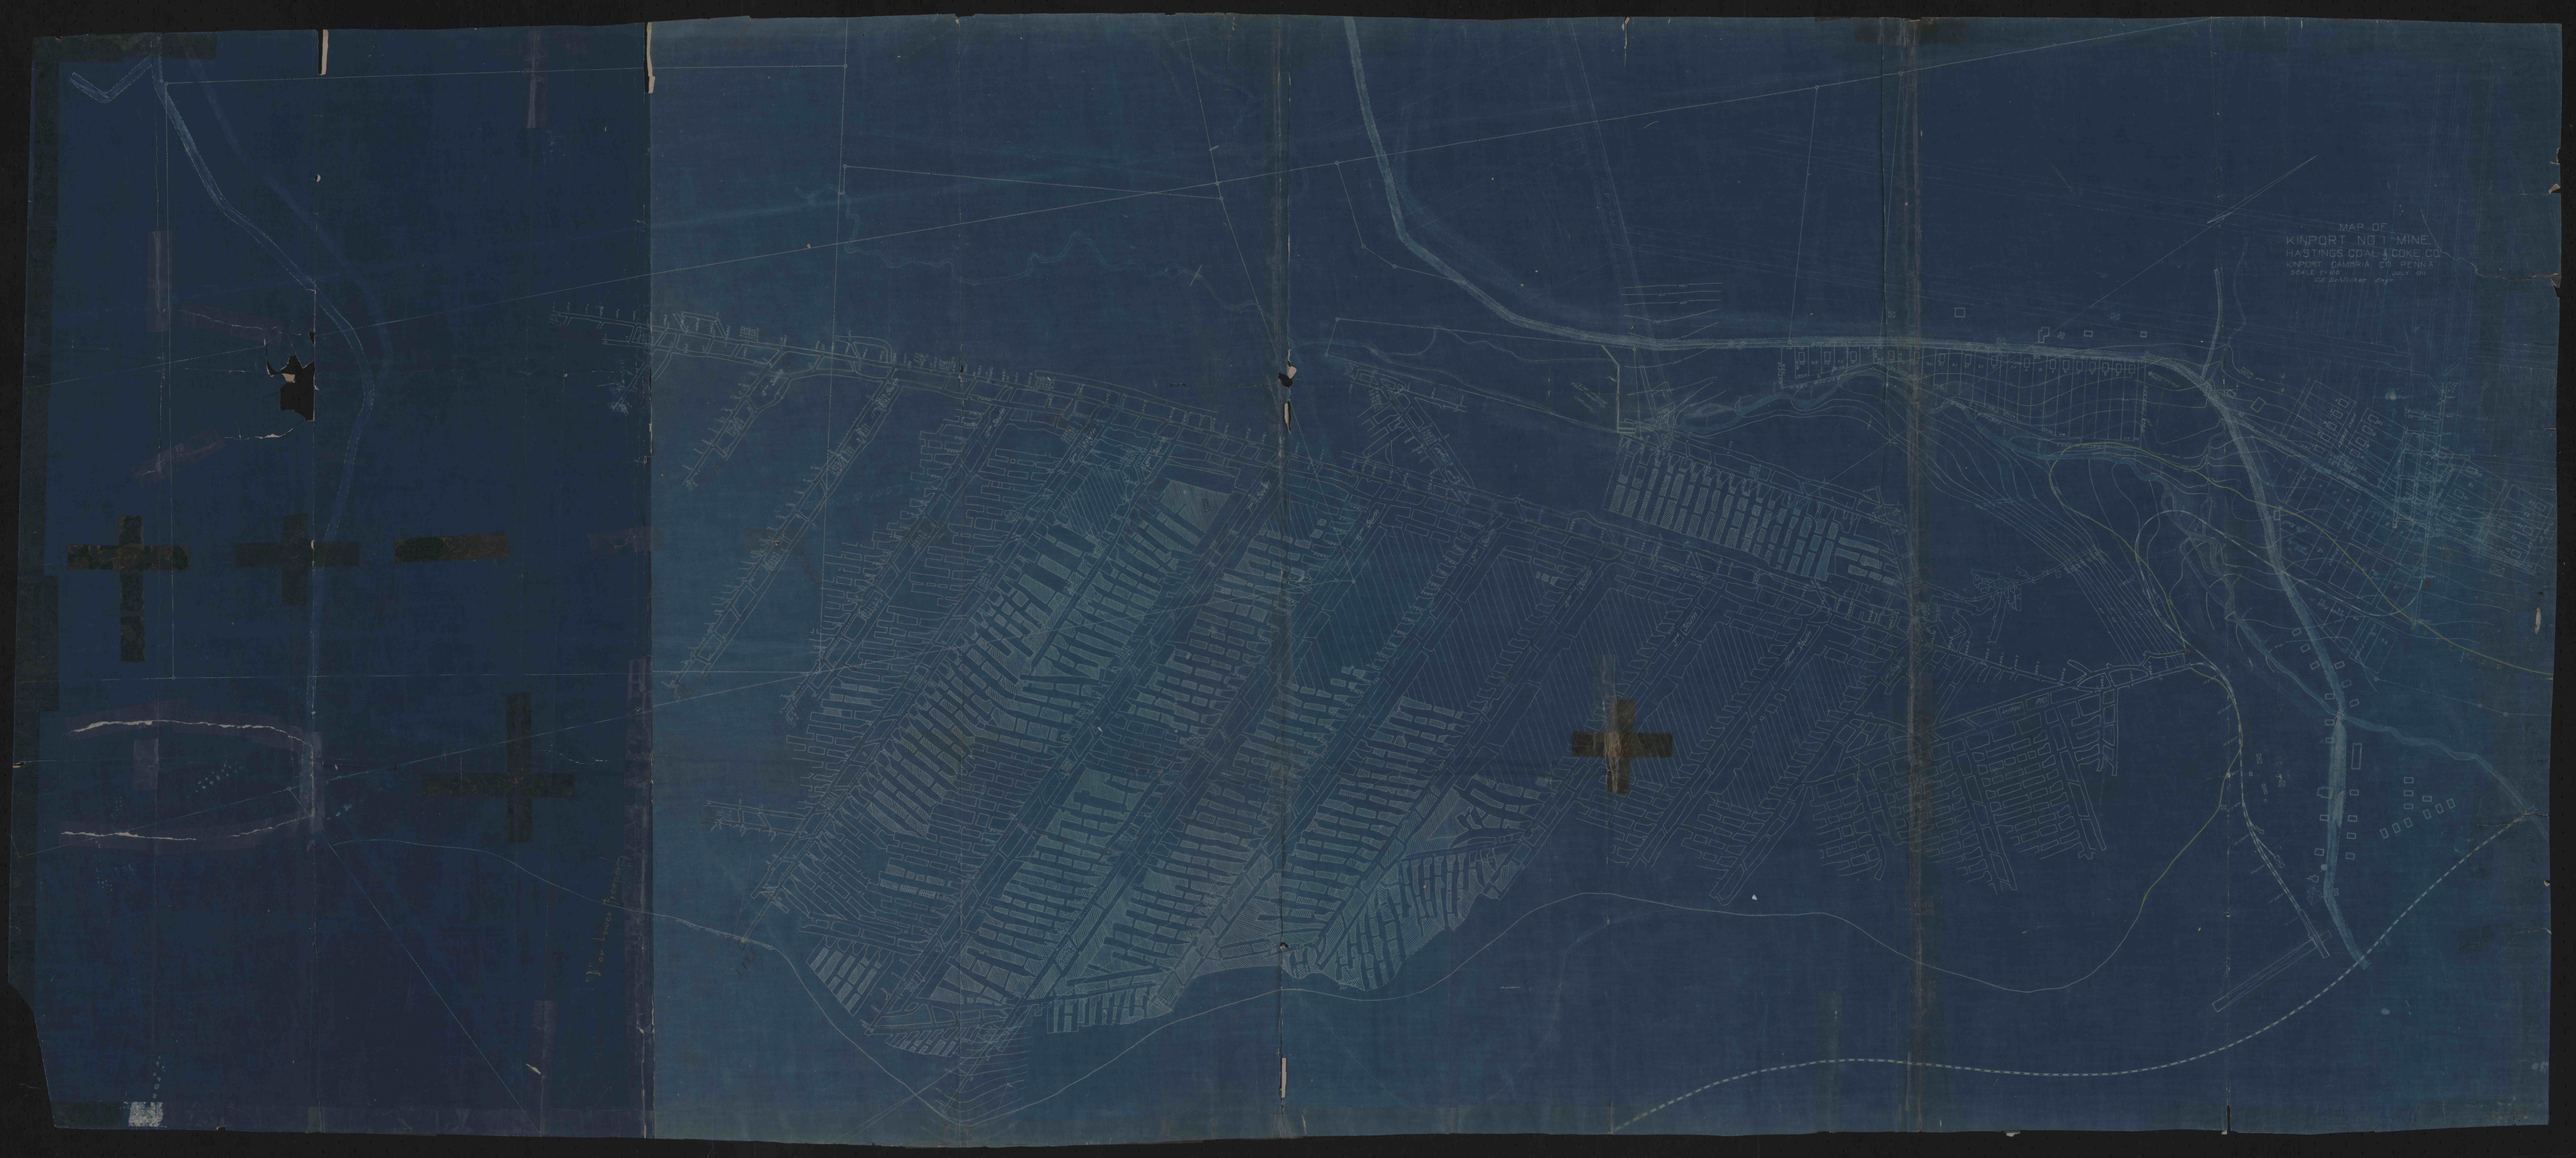
MAP OF
KINPORT NO 1 MINE
HASTINGS COAL & COKE CO.
KINPORT, CAMBRIA CO., PENN'A
SCALE 1"=200'