


1826.62

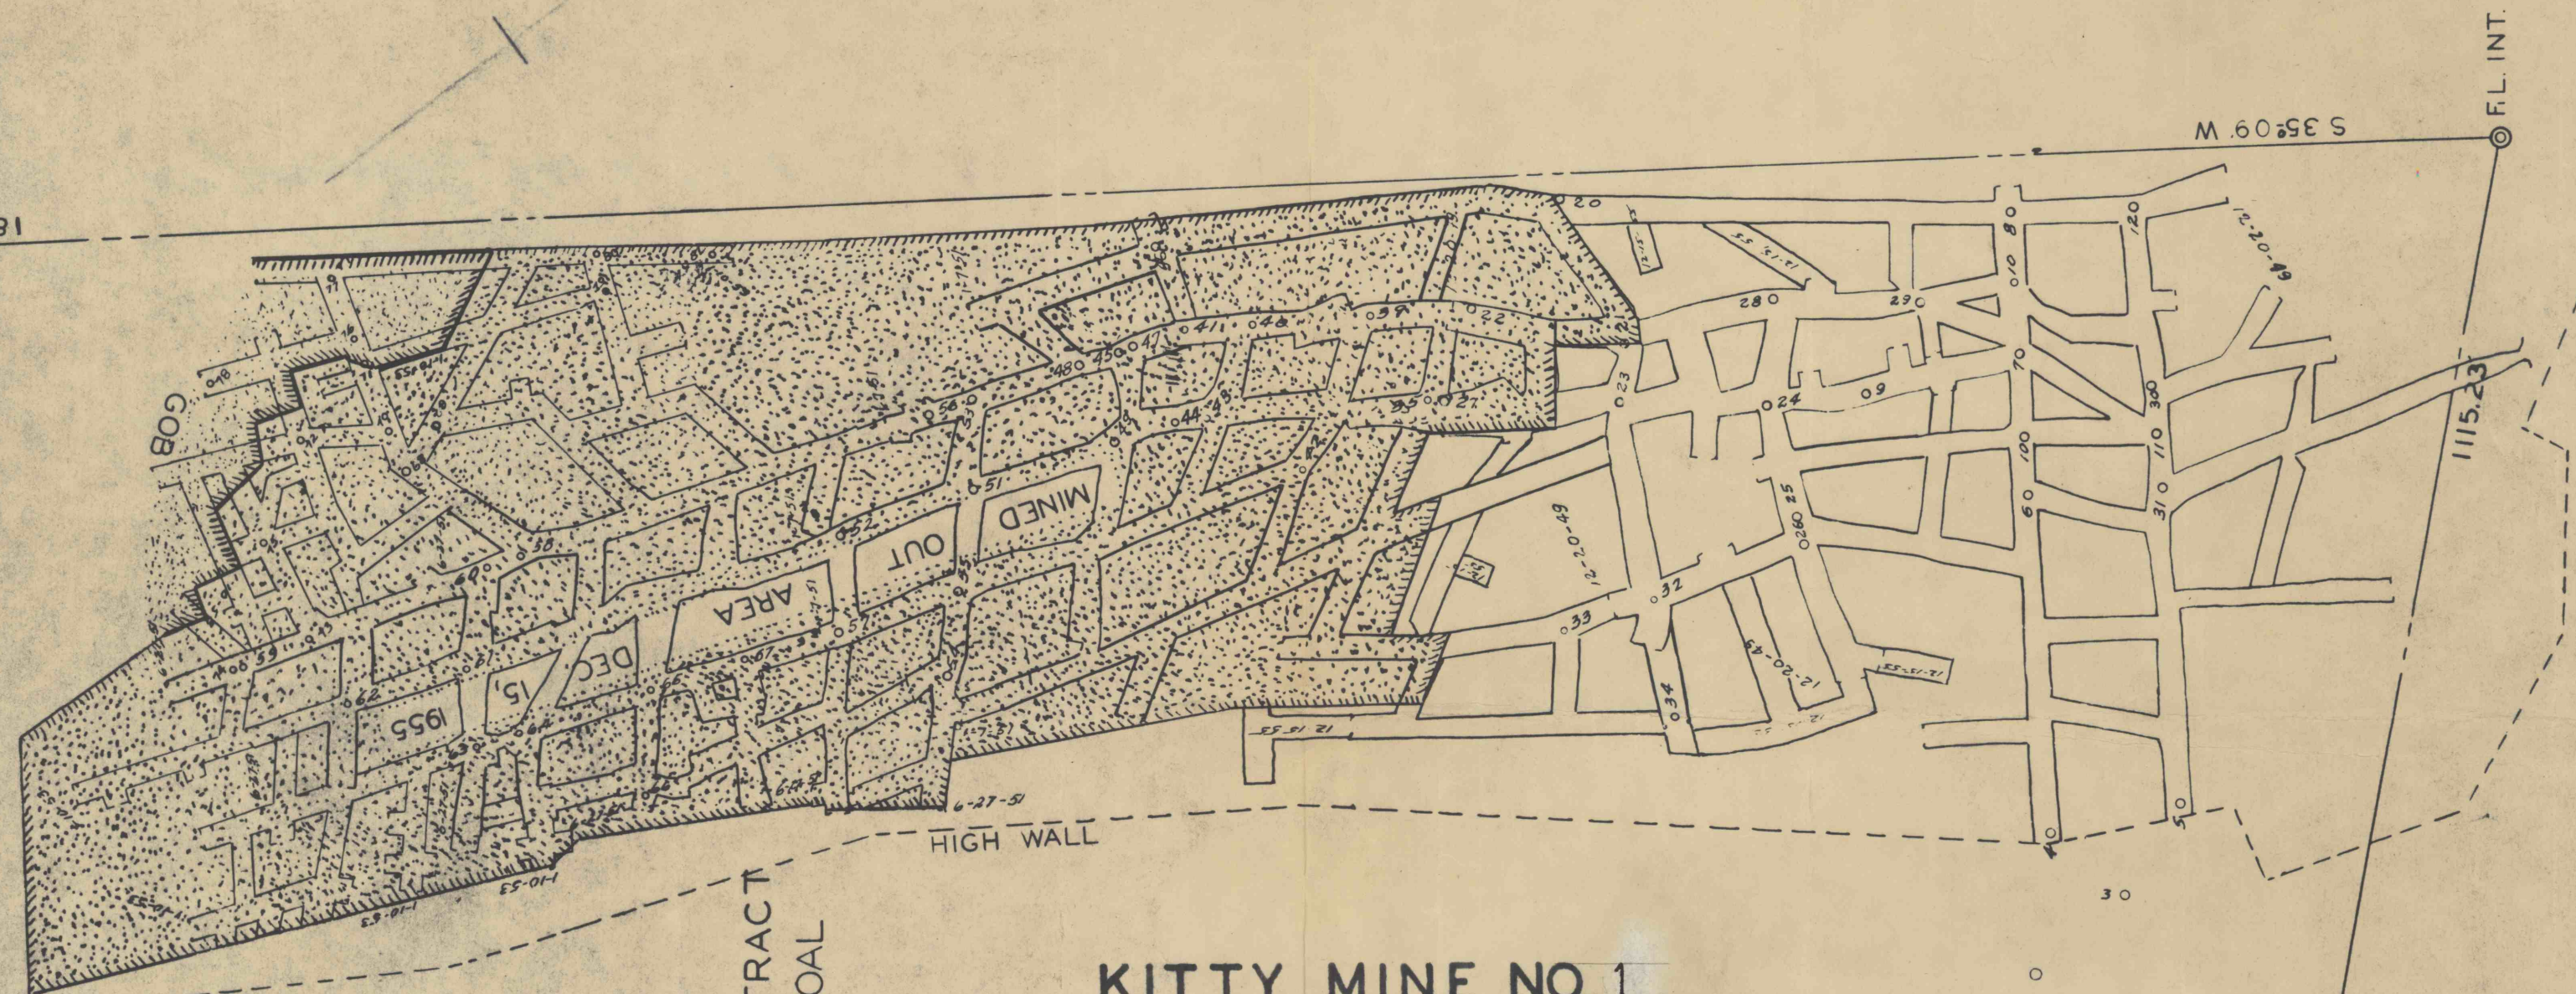

S 35° 09' W

FL. INT.

WARREN ROSS - TRACT

IDA L. MILLER - TRACT
27 ACRES COAL

KITTY MINE NO. 1.
NICHOLSON-MARSHALL COAL CO.

DUNKARD TOWNSHIP, GREENE CO., PA.

SCALE 100' TO 1"

MARCH 6, 1956

Albert P. Hood
P.S. 8572

#1495
8-13-99
C.C.