


8-13-99
CC.

MINE MAP *Dist. 4*
OF
JOSEPH KLEBACHA MINE
SOUTHEAST OF WESTVILLE
WASHINGTON TWP. JEFFERSON CO.
PENNSYLVANIA
LOWER FREEPORT SEAM
SCALE 1"=100' OCTOBER 8, 1955
SURVEYED BY: R.L. HAAS

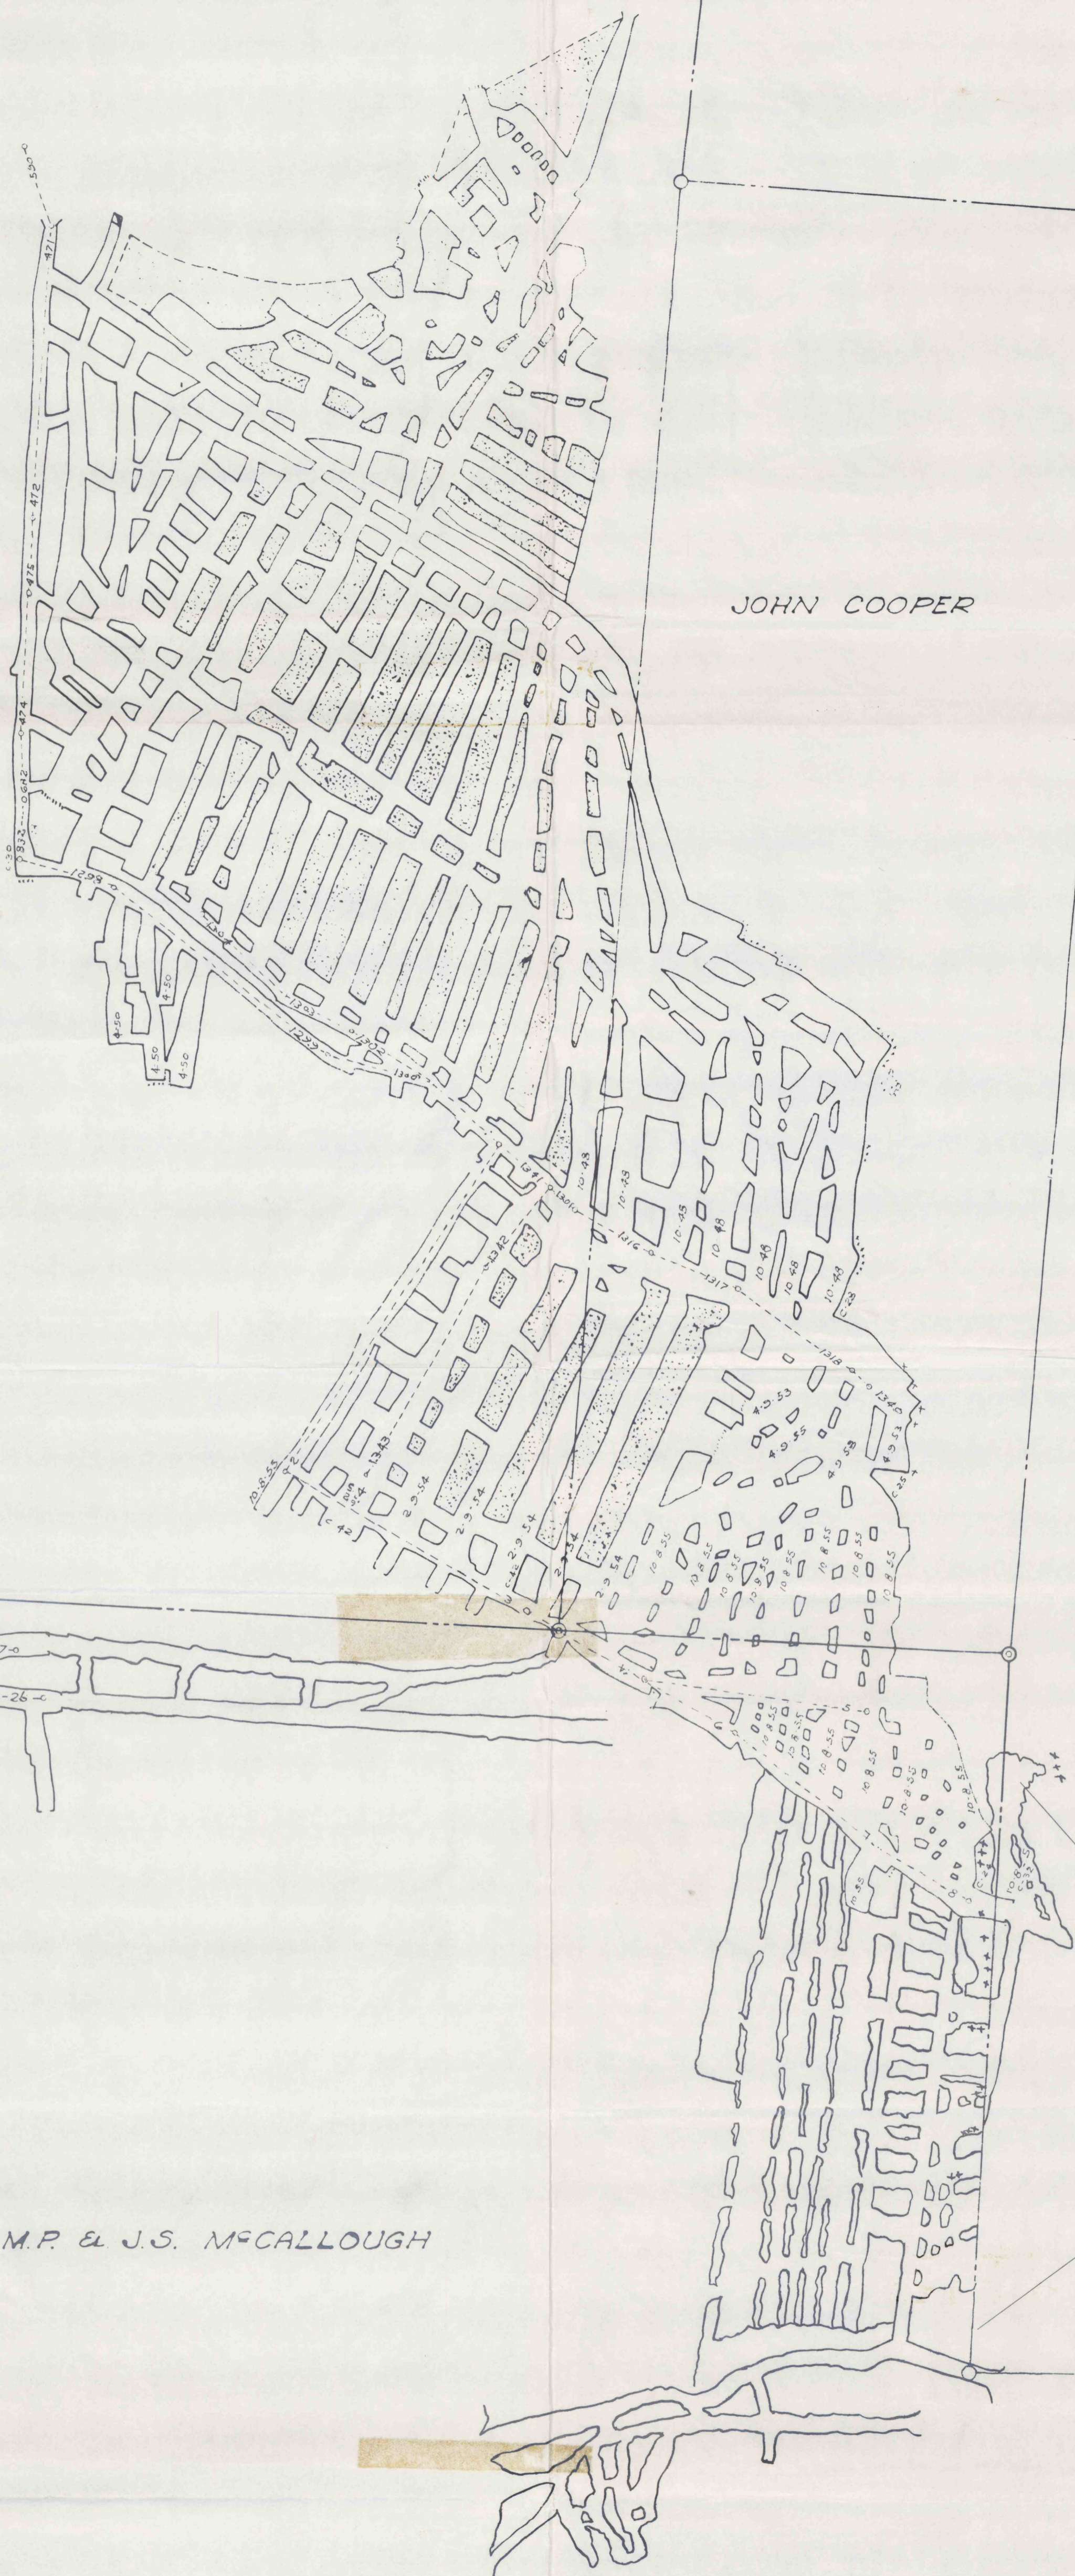

H. GROVES

JOHN COOPER

W. J. CALHOUN

JOHN COOPER

M.P. & J.S. McCALLOUGH

M.P. & J.S. McCALLOUGH

REVISED	
OCT. 8, 1955	

100
100
100