



T. P. BRECK

JACKSON


HEIRS

W. L. DAWSON

DANIEL

HUEY

SYMBOL	DATE	ENGINEER
A	8-4-1944	A. J. LUCAS
B	MAR. 1944	"
C	JUN. 1944	"
D	SEP. 1949	"
E	1-2-50	M. E. SCUDERS
F	10-28-52	A. J. LUCAS
G	2-25-54	"
H	5-18-54	"
I	5-9-54	"
J	3-15-57	"
K	12-15-57	"
L	5-2-58	"
M	8-1-58	"
N	10-24-58	W. L. DAWSON
O	9-12-60	"

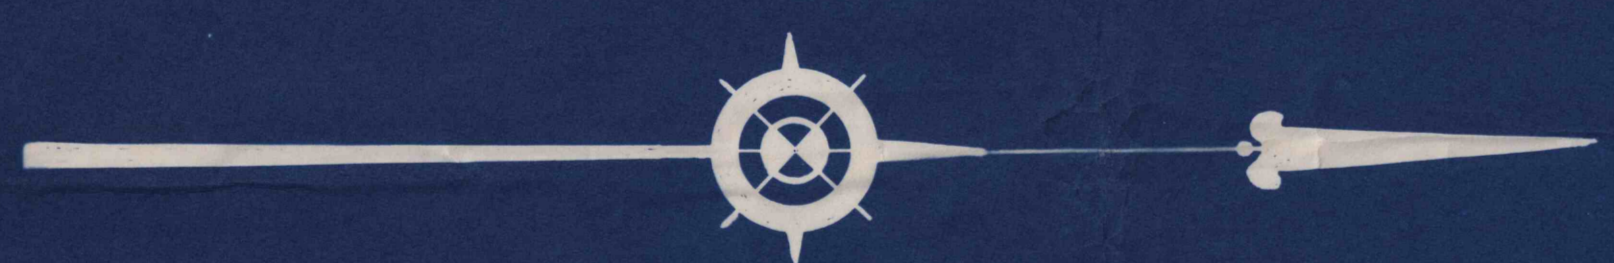

MINE MAP
 FRANK KOLEN COAL
 FAWN-TWP. ALLEGHENY-CO. PA.
 SCALE 1 INCH = 100 FEET
 AUG 1944 BY A. J. LUCAS E.M.

