

ORVILLE MARSHALL

EVERETT HANNAWELL

J. I. KORB

J. I. KORB

HOWARD G. SHUCKER


BRYCE HARTZFELD

RONALD SWOOPE

FIELD COPY

J. I. KORB
 LUTHERSBURG, PA.
 MAP SHOWING
 COALLAND AND MINE WORKS
 BRADY TWP. CLFD. CO., PA.
 SCALE 1"=100'
 CLEARFIELD, PA. NOV 21, 1966
 ROY C. KINDIG
 REG. ENGR.

- Boundary of Tract
- Proposed Ultimate Extent of Mining
- Proposed 1st 6 Mo. 12/1/66 - 6/1/67
- Mining Completed

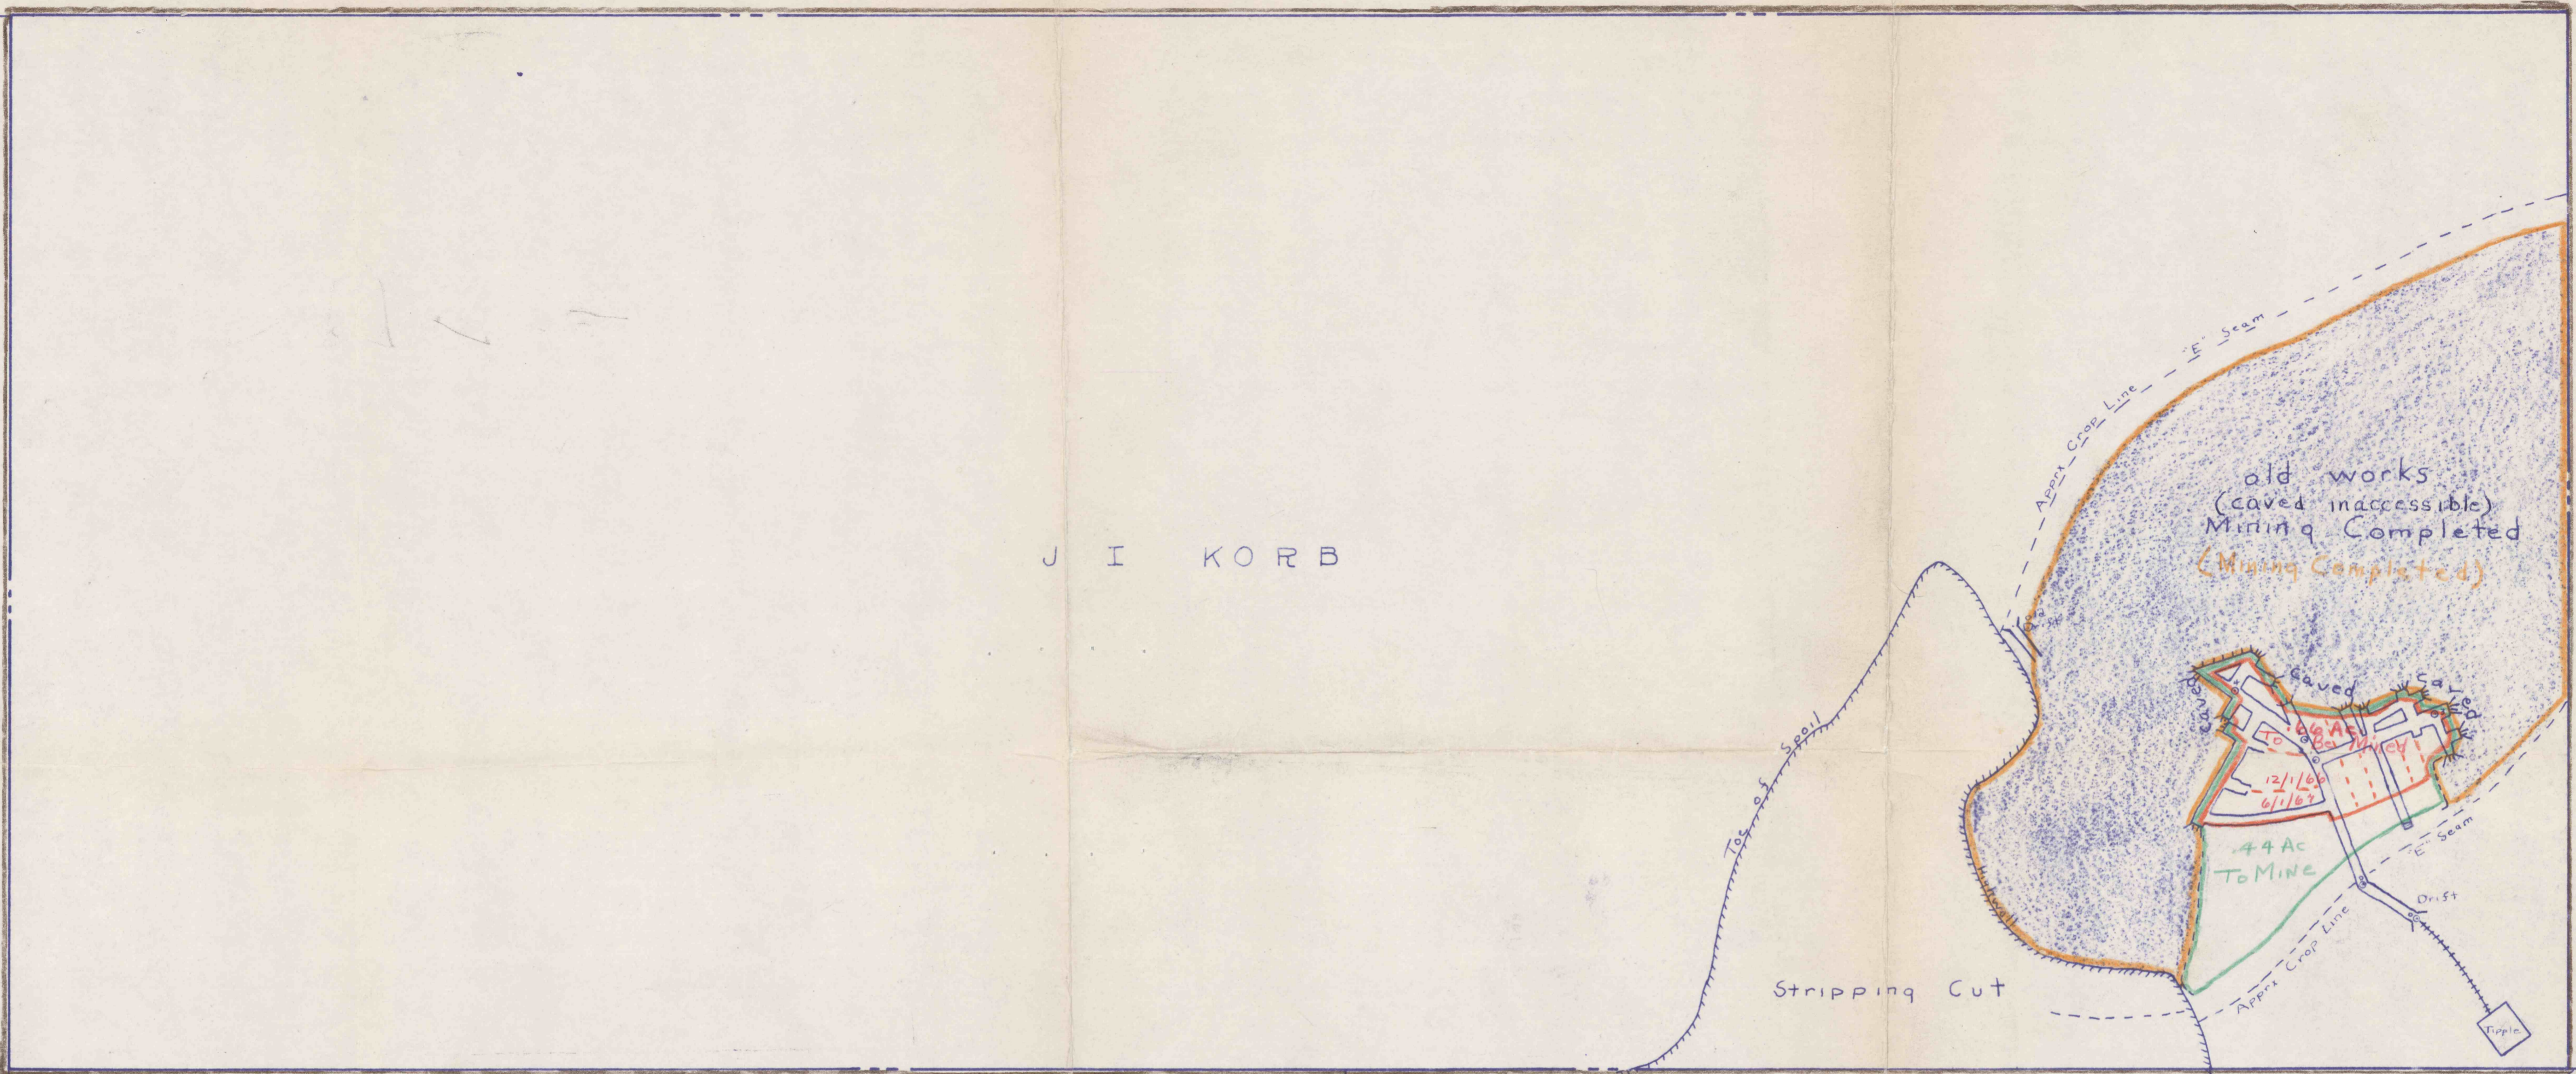

To Rt. 322
 & Chestnut Grove
 Penns. State Highway Route No. 17000