
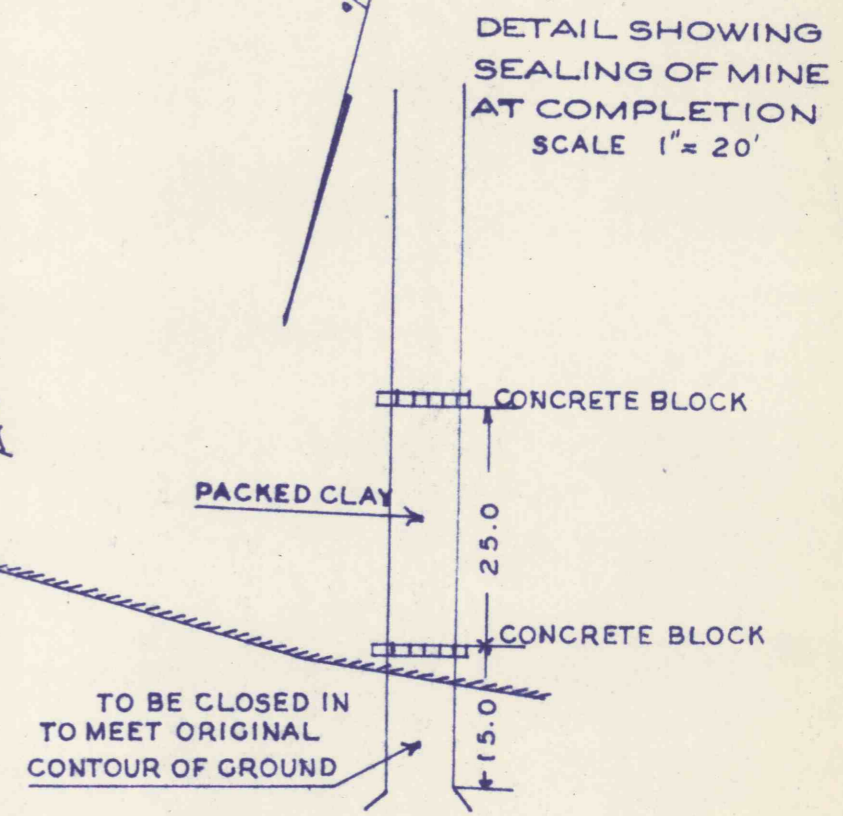


LEGEND

LIMIT OF MINING
 MINING TO DATE
 TO BE MINED NEXT 6 MONTHS

PERMIT NO. 383-1, MAY 15, 1969.

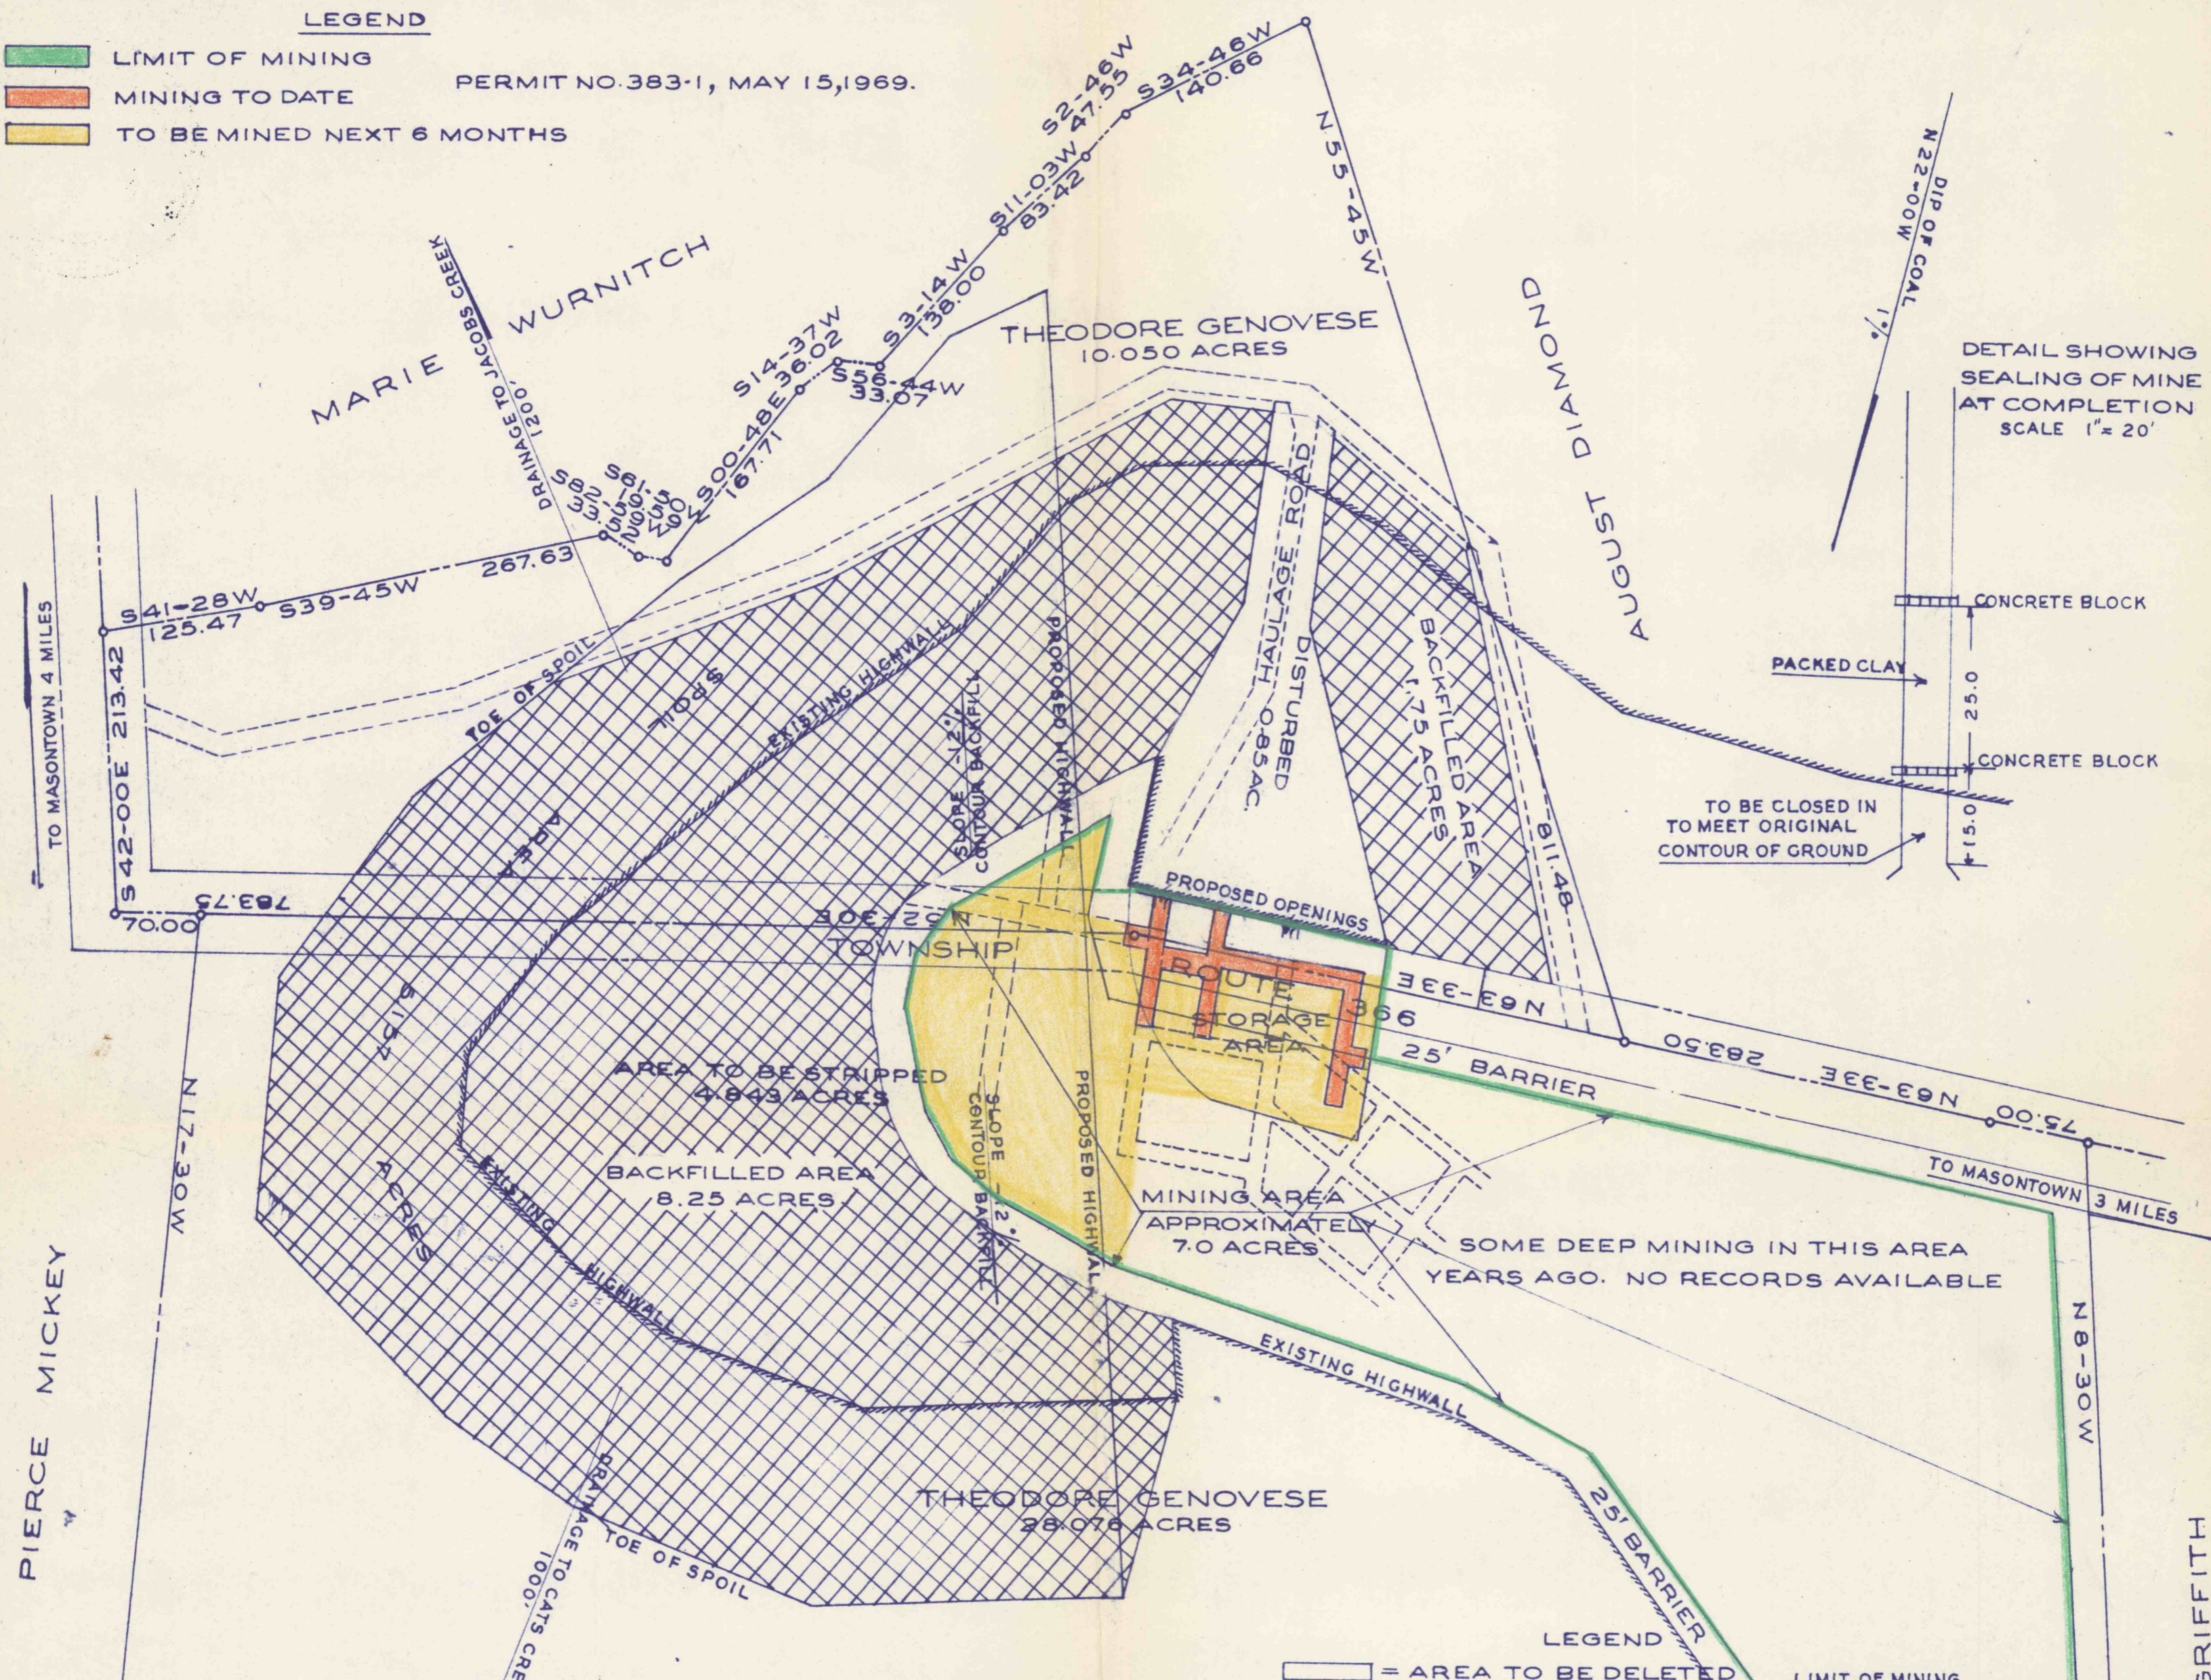

LEGEND

= AREA TO BE DELETED
 = CORRECTED PERMIT 10.85 ACRES
 = BACKFILLED AREA 10.0 ACRES
 = STORAGE AREA
 = DISTURBED AREA MINE OPENING 0.85 ACRES
 = LIMIT OF MINING

KOVACH DEEP MINE
 OPERATED BY
ALEX KOVACH, MASONTOWN, PA.


STRIP MINE OPERATION
GENOVESE COAL CO

PROPERTY OF
THEODORE GENOVESE
 NICHOLSON TOWNSHIP, FAYETTE COUNTY, PA.

SCALE 1" = 100' MARCH 17, 1966.
 F. B. GOSNELL, R.P.E. 9837.

UNIONTOWN, PA.
 REVISED APRIL 2, 1968.
 REVISED MAY 10, 1969.
 REVISED SEPT. 19, 1969.

OPEN PIT PERMIT NO. 244-7
 U. S. TREASURY BOND NO. 150712B 5,000

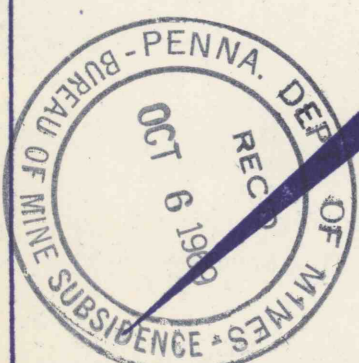

MINE DRAINAGE PERMIT NO. 2966BSM25

PIERCE MICKEY

RUTH GRIFFITH