

KAZOLA BROS. COAL CO. — "C" COAL SEAM

SITUATE — QUEMAMONING TOWNSHIP, SOMERSET COUNTY, PENNA.

SCALE — 1" = 100'

SURVEYED — 24 OCT. 1955
TO
22 NOV. 1961

COAL OWNED BY DEERFIELD COAL CO. — FORMERLY — QUEMAMONING COAL CO.
BY — GEORGE P. JONES, R.R.E.
NEW FLORENCE, PENNA.


RALPHTON FIELD
MINES — *1 — *3 — *4 — *5

NOTE:

FIRST LEFT
OF FIRST NORTH MAIN
WILL DRIVE OUTSIDE
NEAR END OF STRIP PIT.
EXACT LOCATION TO BE
DETERMINED AT A LATER DATE

TO
JENNERTOWN

APPROX. MEASUREMENT
RALPHTON MINE

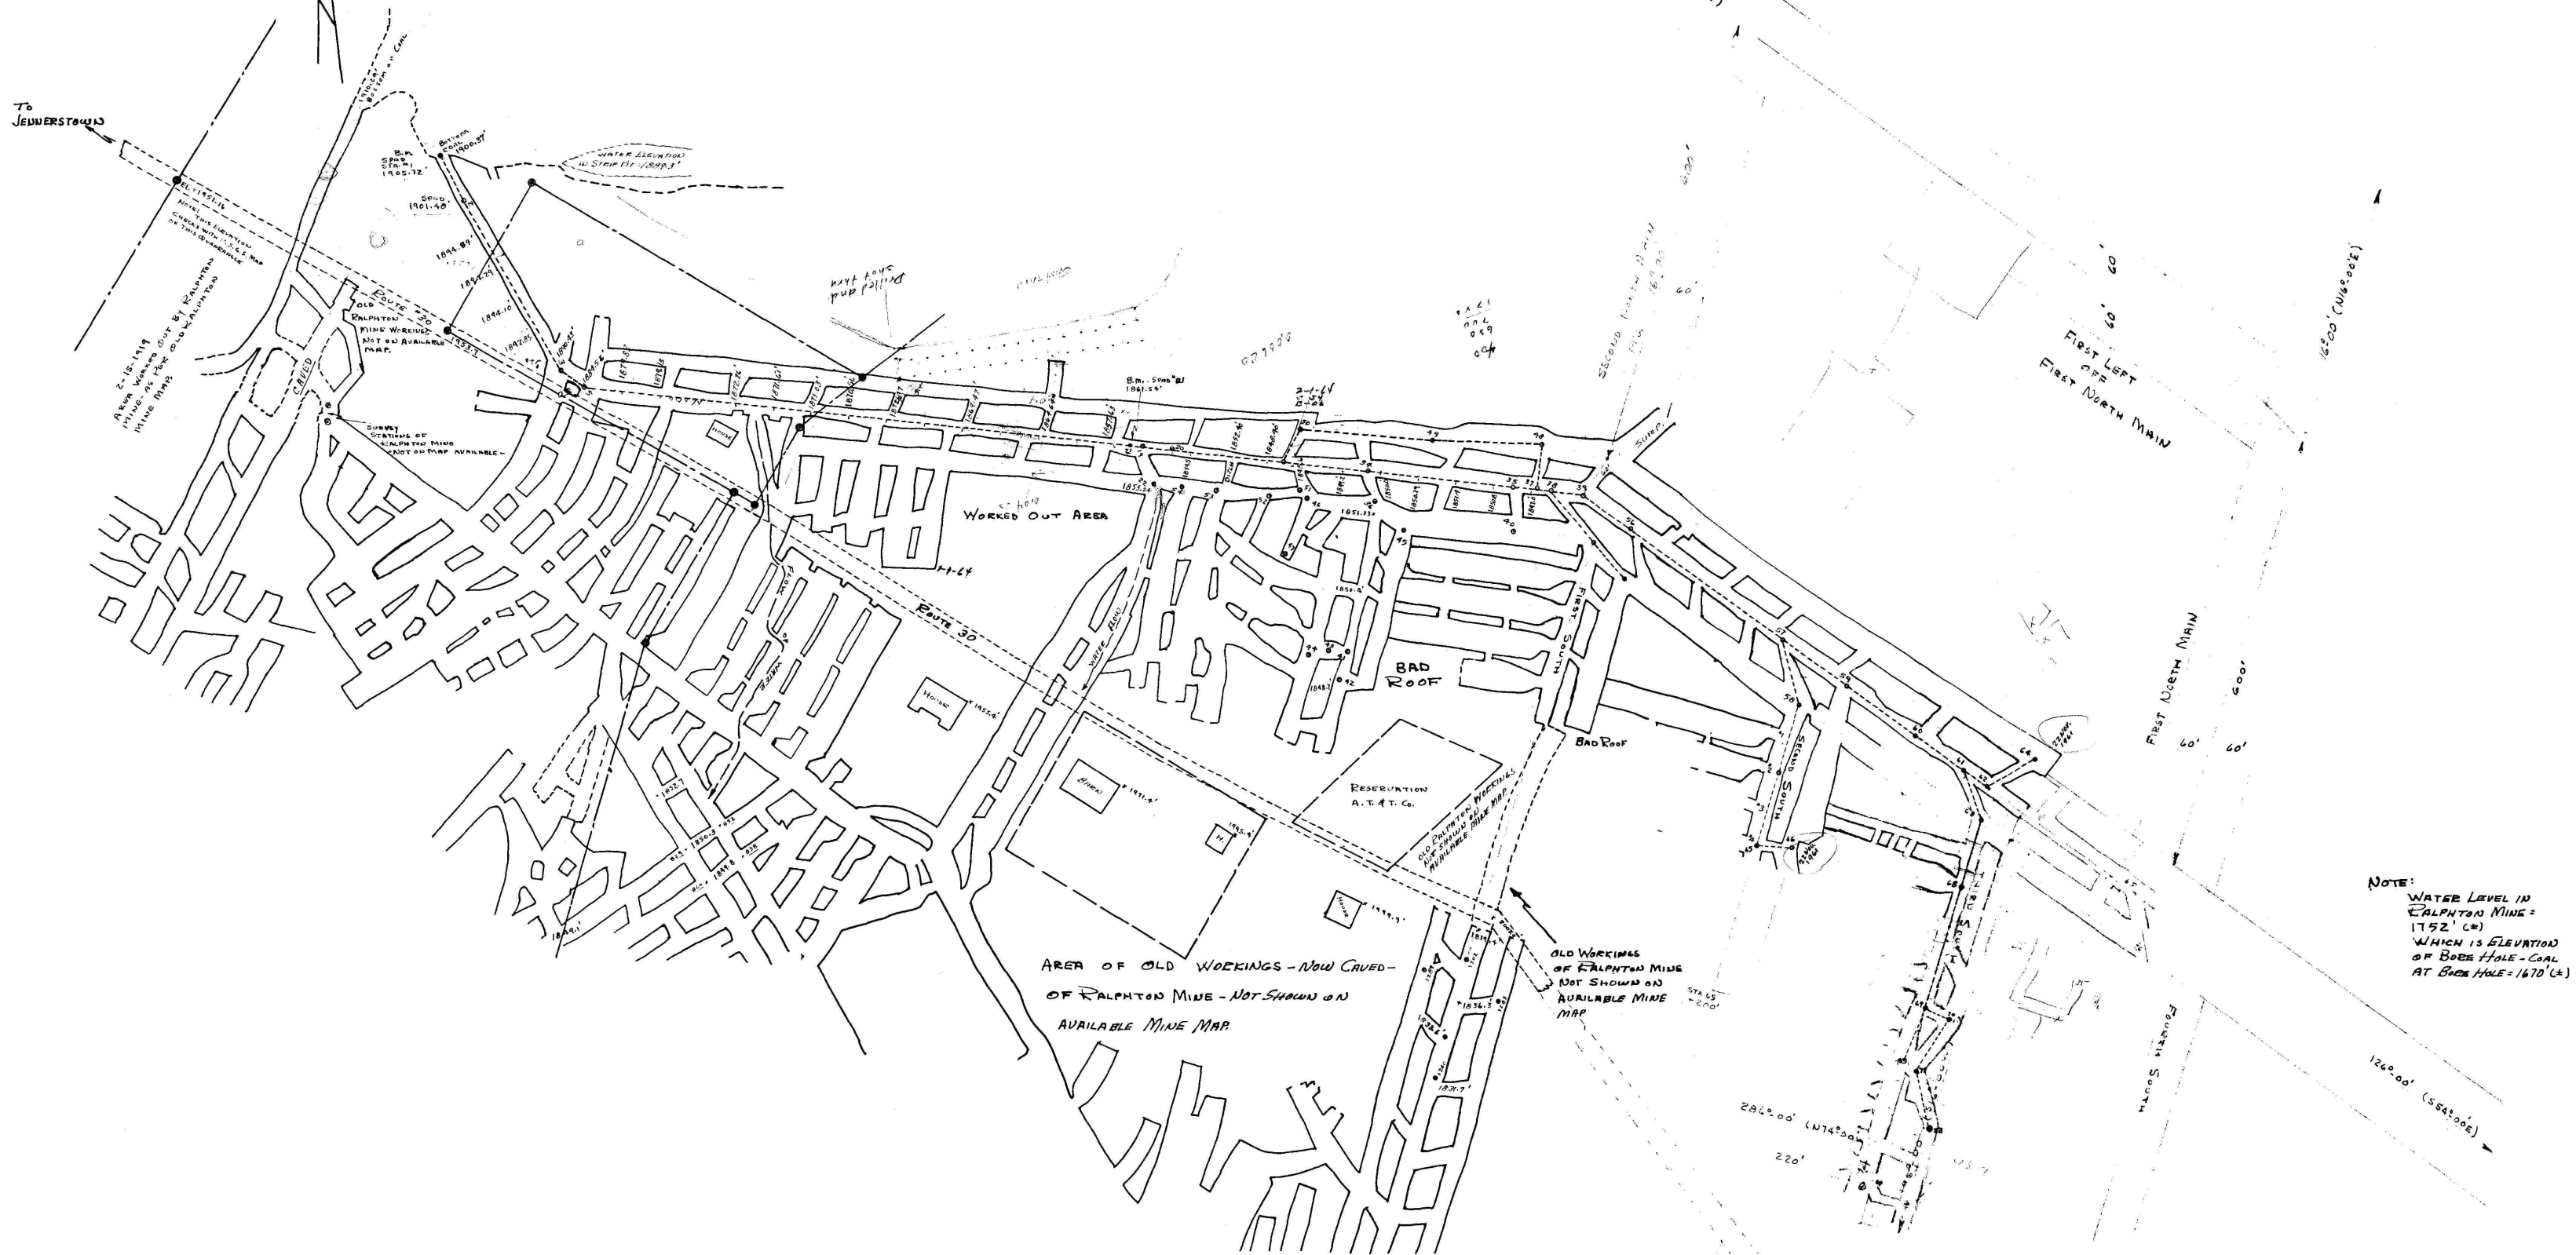

NOTE:

WATER LEVEL IN
RALPHTON MINE =
1752' (+)
WHICH IS ELEVATION
OF BOSS HOLE - COAL
AT BOSS HOLE = 1670' (+)