


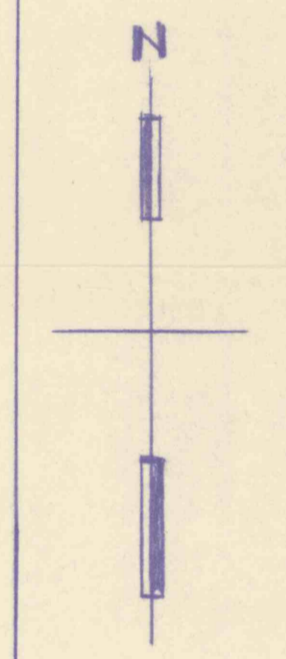

NOTE:
 Mine workings and features shown on this map were compiled from survey information provided by others.



□ Contemplated mining area 3-1-80 thru future
 Mine is currently inactive. When activated the appropriate officials shall be notified.

KRAYNAK COAL COMPANY
 KRAYNAK NO. 3 DEEP MINE
 GRANT and MONTGOMERY TWP, INDIANA CO., PENNA.
 SCALE: 1" = 100' DATE: 7-31-87

"D" Seam - Lower Freeport

FINAL MINE MAP

Rec'd 8-3-88
W.M. GARY

SHEET No. 1