





NOTE:
 Mine workings and features shown on this map were compiled from survey information provided by others.

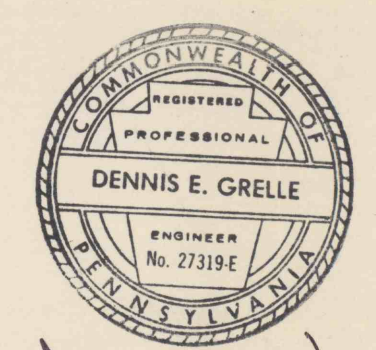

Dennis E. Grele

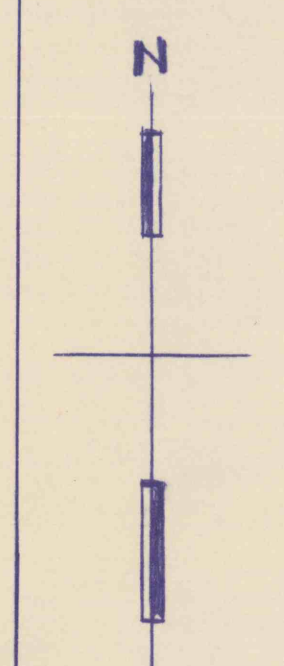

Contemplated mining area 3-1-80 thru future
 Mine is currently inactive. When activated the appropriate officials shall be notified.

RECEIVED
 AUG - 6 1987
 Dept. of Environmental Resources
 McMurray District Office

KRAYNAK COAL COMPANY
 KRAYNAK NO.3 DEEP MINE
 GRANT and MONTGOMERY TWP, INDIANA CO., PENNA.
 SCALE: 1" = 100' DATE: 7-31-87

FINAL MINE MAP

SHEET No. 1