



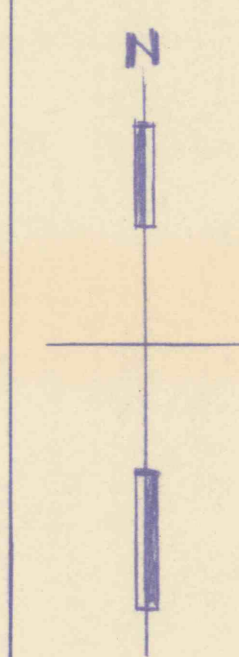

NOTE:  
 Mine workings and features shown on this map were compiled from survey information provided by others.

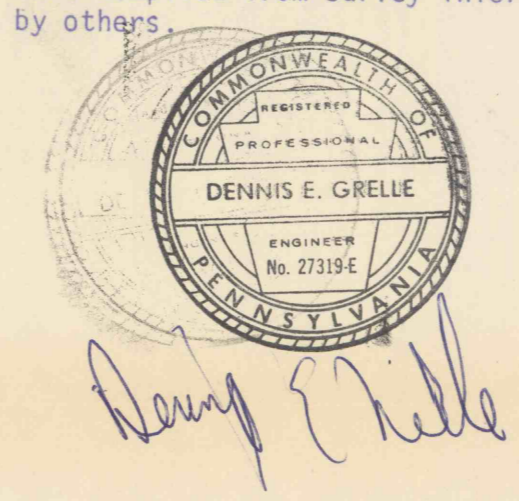

Contemplated mining area 3-1-80 thru future  
 Mine is currently inactive. When activated the appropriate officials shall be notified.

**KRAYNAK COAL COMPANY**  
 KRAYNAK NO.3 DEEP MINE  
 GRANT and MONTGOMERY TWP, INDIANA CO., PENNA.  
 SCALE: 1" = 100'      DATE 7-31-87

FINAL MINE MAP

*Revised 8-3-88  
 W.L.*

SHEET No. 1