

STEWART HRS

AREA 42.866 ACRES
IN FEEL

LOUIS SNYDER

0-3-46
9-8-45
9-8-45
16-46
28-47
2-28
3-46
4-46
SURFACE SOLD TO THOS. P. MARTIN W. & JAMES L. RUANE
AREA 5.584 AC.
ENG. FILE 828

FURNACE CO'S MINE
SURFACE SOLD TO
SAMUEL MCCOY
AREA 11.733 ACRES

WORKED OUT

SURFACE CONVEYED BY
RUANE COKE CO. TO
UNITED STATES STEEL CORP. TO
TOTAL AREA 14.253 ACRES.
DWG. 14-D-813

WORKED OUT

SURFACE SOLD 6-26-23
TO DOCK MICKENS
AREA 5.000 ACRES
Engg's File 84477

SOLD FEB 15, 1939 TO
GEORGE V. KUNTZ
AREA 3.833 ACRES
Engg's File 7860


FAIRCHANCE MINE

FAIRCHANCE BOROUGH

2-26-65

10-20-55
3-30-53

7-31-67
11-30-66
7-31-67

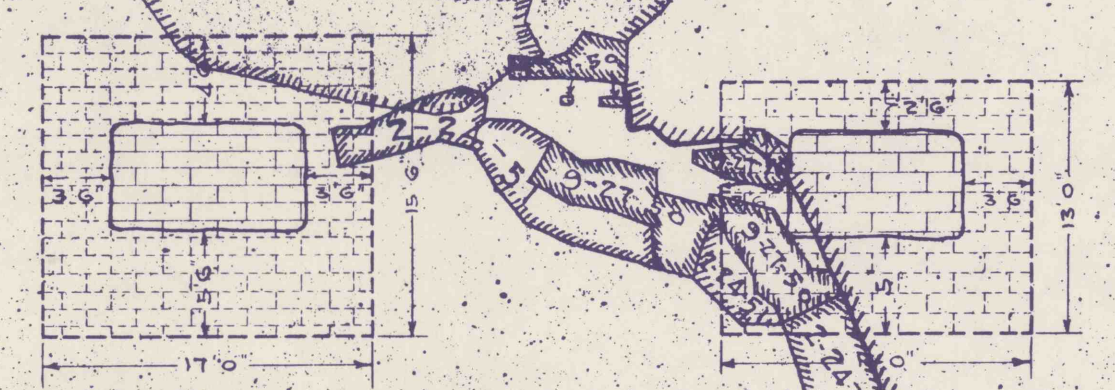

DAM NO. 2
LOCATION - MANWAY STA 215+62
THICKNESS AT TOP - 3 FT.
BOTTOM - 4 FT.
CONSTRUCTION - RED BRICK LAID IN CEMENT MORTAR.
COMPLETED - 2-21-12

DAM NO. 1
LOCATION - SLOP. HEADING STA 1492+7
THICKNESS AT TOP - 3 FT.
BOTTOM - 3 FT.
COMPLETED - 2-21-12

RIGHT OF WAY FOR 4" PIPE LINE GRANTED 10-20-16 TO STAR GAS CO.