


STOPPINGS & BACK FILL APPROVED BY
STATE MINE INSPECTOR
S.A. FREDERICK - 23RD DISTRICT.

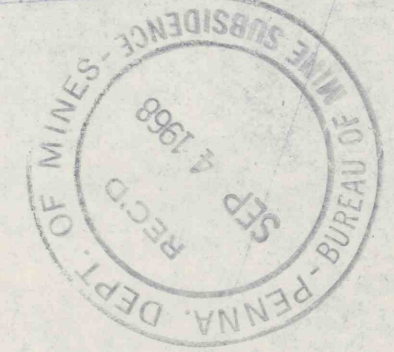

- LEGEND
- = PROPERTY LINE
 - = MINING COMPLETED 8-1-68
 - = OUTCROP LOWER FREEPORT SEAM
 - = 6 MONTH ADVANCE

THOMAS LUCE
&
WALTER KOWALESKI
MINE No. 4
LOWER FREEPORT SEAM
STONYPARK TWP. SOMERSET CO. PA.
SCALE - 1" = 100 FT. MARCH 4, 1967
VEERICKSON RPE No. 7074
J. E. Curran



FINAL MAP - MINE CLOSED