## DATE OF SURVEY.

| | | | |
|---|---|---|---|
| NOV. | 24, | 1903 | = A. |
| MAR. | 4, | 1904 | = B. |
| SEPT. | 4, | 1904 | = C. |
| DEC. | 22, | 1904 | = D. |
| MAR. | 16, | 1905 | = E. |
| JULY | 3, | 1905 | = F. |
| DEC. | 16, | 1905 | = G. |
| MAR. | 1, | 1906 | = H. |
| AUG. | 8, | 1906 | = I. |
| JAN. | 1, | 1907 | = J. |
| JUNE | " | " | = K. |
| SEPT. | " | " | = L. |
| DEC. | 16, | " | = M. |
| APR. | 1, | 1908 | = N. |
| AUG. | 20, | 1908 | = O. |
| JAN. | 20, | 1909 | = P. |
| AUG. | 27, | 1909 | = R. |
| NOV. | 20, | 1909 | = S. |
| APR. | 27, | 1910 | = T. |
| SEPT. | 14 | 1910 | = U. |
| APR. | 4 | 1912 | = V. |
| JULY | 1 | 1912 | = W. |
| OCT. | 1 | 1912 | = X. |
| JAN. | 1 | 1913 | = Y. |
| APR. | 1 | 1913 | = Z. |
| JULY | 1 | 1913 | = AA. |
| OCT. | 1 | 1913 | = AB. |
| JAN. | 1 | 1914 | = AC. |
| APR. | 1 | 1914 | = AD. |
| JULY | 1 | 1914 | = AE. |
| OCT. | 1 | 1914 | = AF. |
| JAN. | 1 | 1915 | = AG. |
| APR. | 1 | 1915 | = AH. |
| JULY | 1 | 1915 | = AI. |
| OCT. | 1 | 1915 | = AJ. |
| JAN. | 1 | 1916 | = AK. |
| APR. | 1, | 1916 | = AL. |
| JULY | 1, | 1916 | = AM. |
| JAN. | 1, | 1917 | = AN. |
| APR. | 9 | 1917 | = AO. |
| JULY | 2 | 1917 | = AP. |
| OCT. | 2 | 1917 | = AR. |
| JAN. | 1 | 1918 | = AS. |
| APRIL | 1 | 1918 | = AT. |
| JULY | 1 | 1918 | = AU. |
| OCT. | 8 | 1918 | = AV. |
| JAN. | 1, | 1919 | = AW. |
| APR. | 1 | 1919 | = AX. |
| JULY | 8 | 1919 | = AY. |
| OCT. | 3 | 1919 | = AZ. |
| JAN. | 6 | 1920 | = BA. |
| APR. | 6 | 1920 | = BB. |
| JULY | 1 | 1920 | = BC. |
| SEPT. | 28 | 1920 | = BD. |
| JAN. | 3 | 1921 | = BE. |
| FEB. | 25 | 1922 | = BF. |
| APR. | 3 | 1922 | = BG. |
| OCT. | 3, | 1922 | = BH. |
| JAN. | 4, | 1923 | = BI. |
| MARCH | 15, | 1923 | = BJ. |
| JULY | 2, | 1923 | = BK. |
| OCT. | 2, | 1923 | = BL. |
| JAN. | 1, | 1924 | = BM. |
| MARCH | 6, | 1924 | = BN. |
| JAN. | 7, | 1925 | = BO. |
| JAN. | 1, | 1926 | = BP. |
| MARCH | 1, | 1929 | = BR. |

## LEGEND OF ELECTRIC APPARATUS

- TROLLEY LINES
- CONDUCTORS
- SWITCHES
- MOTORS
- LIGHTS

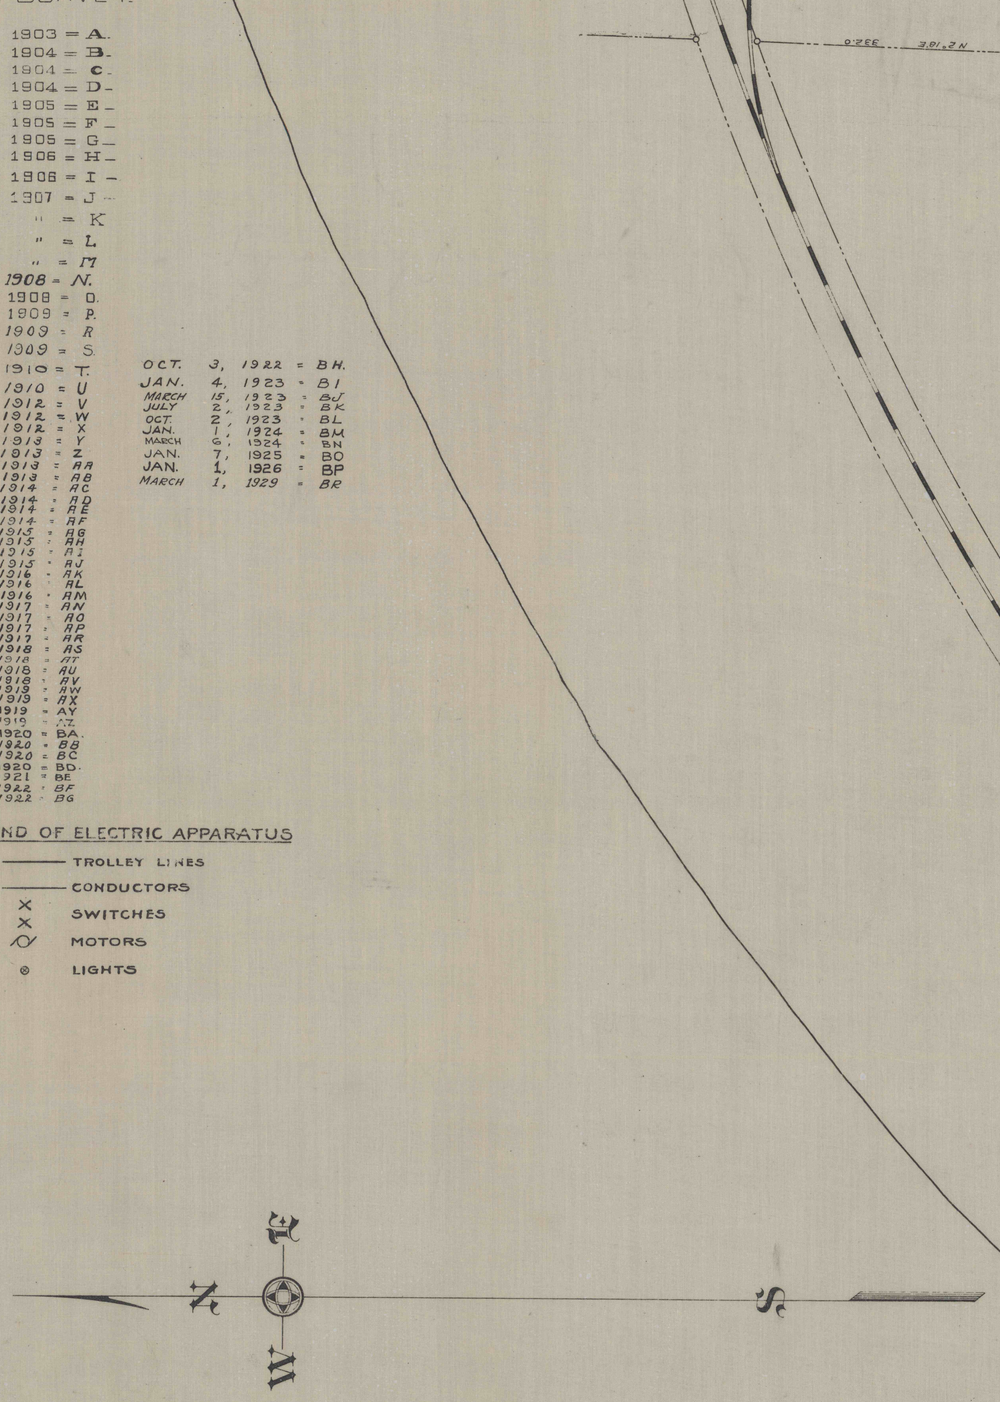


# MINE MAP

OF THE

# LABELLE COKE WORKS.

LUZERNE TOWNSHIP, FAYETTE COUNTY, PENNSYLVANIA.

SCALE, 1" = 100'. OCTOBER 1903.

FAYETTE ENGINEERING & CONTRACTING CO.,
UNIONTOWN, PA.

STATE OF WEST VIRGINIA )
) SS:
COUNTY OF OHIO )

Before me, the undersigned, a Notary Public of, in and for said County of said State, personally appeared J.C. GIBSON, who, being by me first duly sworn did depose and say that be is a Mining Engineer; that he has surveyed the La Belle Coke Company's Mine in Luzerne Township, Fayette County, Pennsylvania: that this tracing (Sheet No. 1 of Four (4) Sheets) and three (3) other tracings, marked respectively "Mine Map of the La Belle Coke Works, Luzerne Township, Fayette County, Pennsylvania. Sheet No. 2 of Four (4) Sheets."; "Mine Map of the La Belle Coke Works, Luzerne Township, Fayette County, Pennsylvania. Sheet No. 3 of Four (4) Sheets." and "Mine Map of the La Belle Coke Works, Luzerne Township, Fayette County, Pennsylvania. Sheet No. 4 of Four (4) Sheets.", comprise a true and correct copy of the original map of the La Belle Coke Company's Mine situate in Luzerne Township, Fayette County, Pennsylvania, and that the original map is a true, complete and correct map and survey of all the excavations made in said mine up to March 15, 1929, the date of the abandonment of said mine.

J. C. Gibson

Taken, Sworn and Subscribed before me this 1st day of April 1929.

J E Bruce

My commission expires:
March 12, 1935.

Mine Map of the La Belle Coke Works, Luzerne Township,
Fayette County, Pennsylvania, Sheet No. 1 of Four (4) Sheets.

31HL15 Sheet 1 of 4