


1" = 100 FT
Oct. 15, 1934

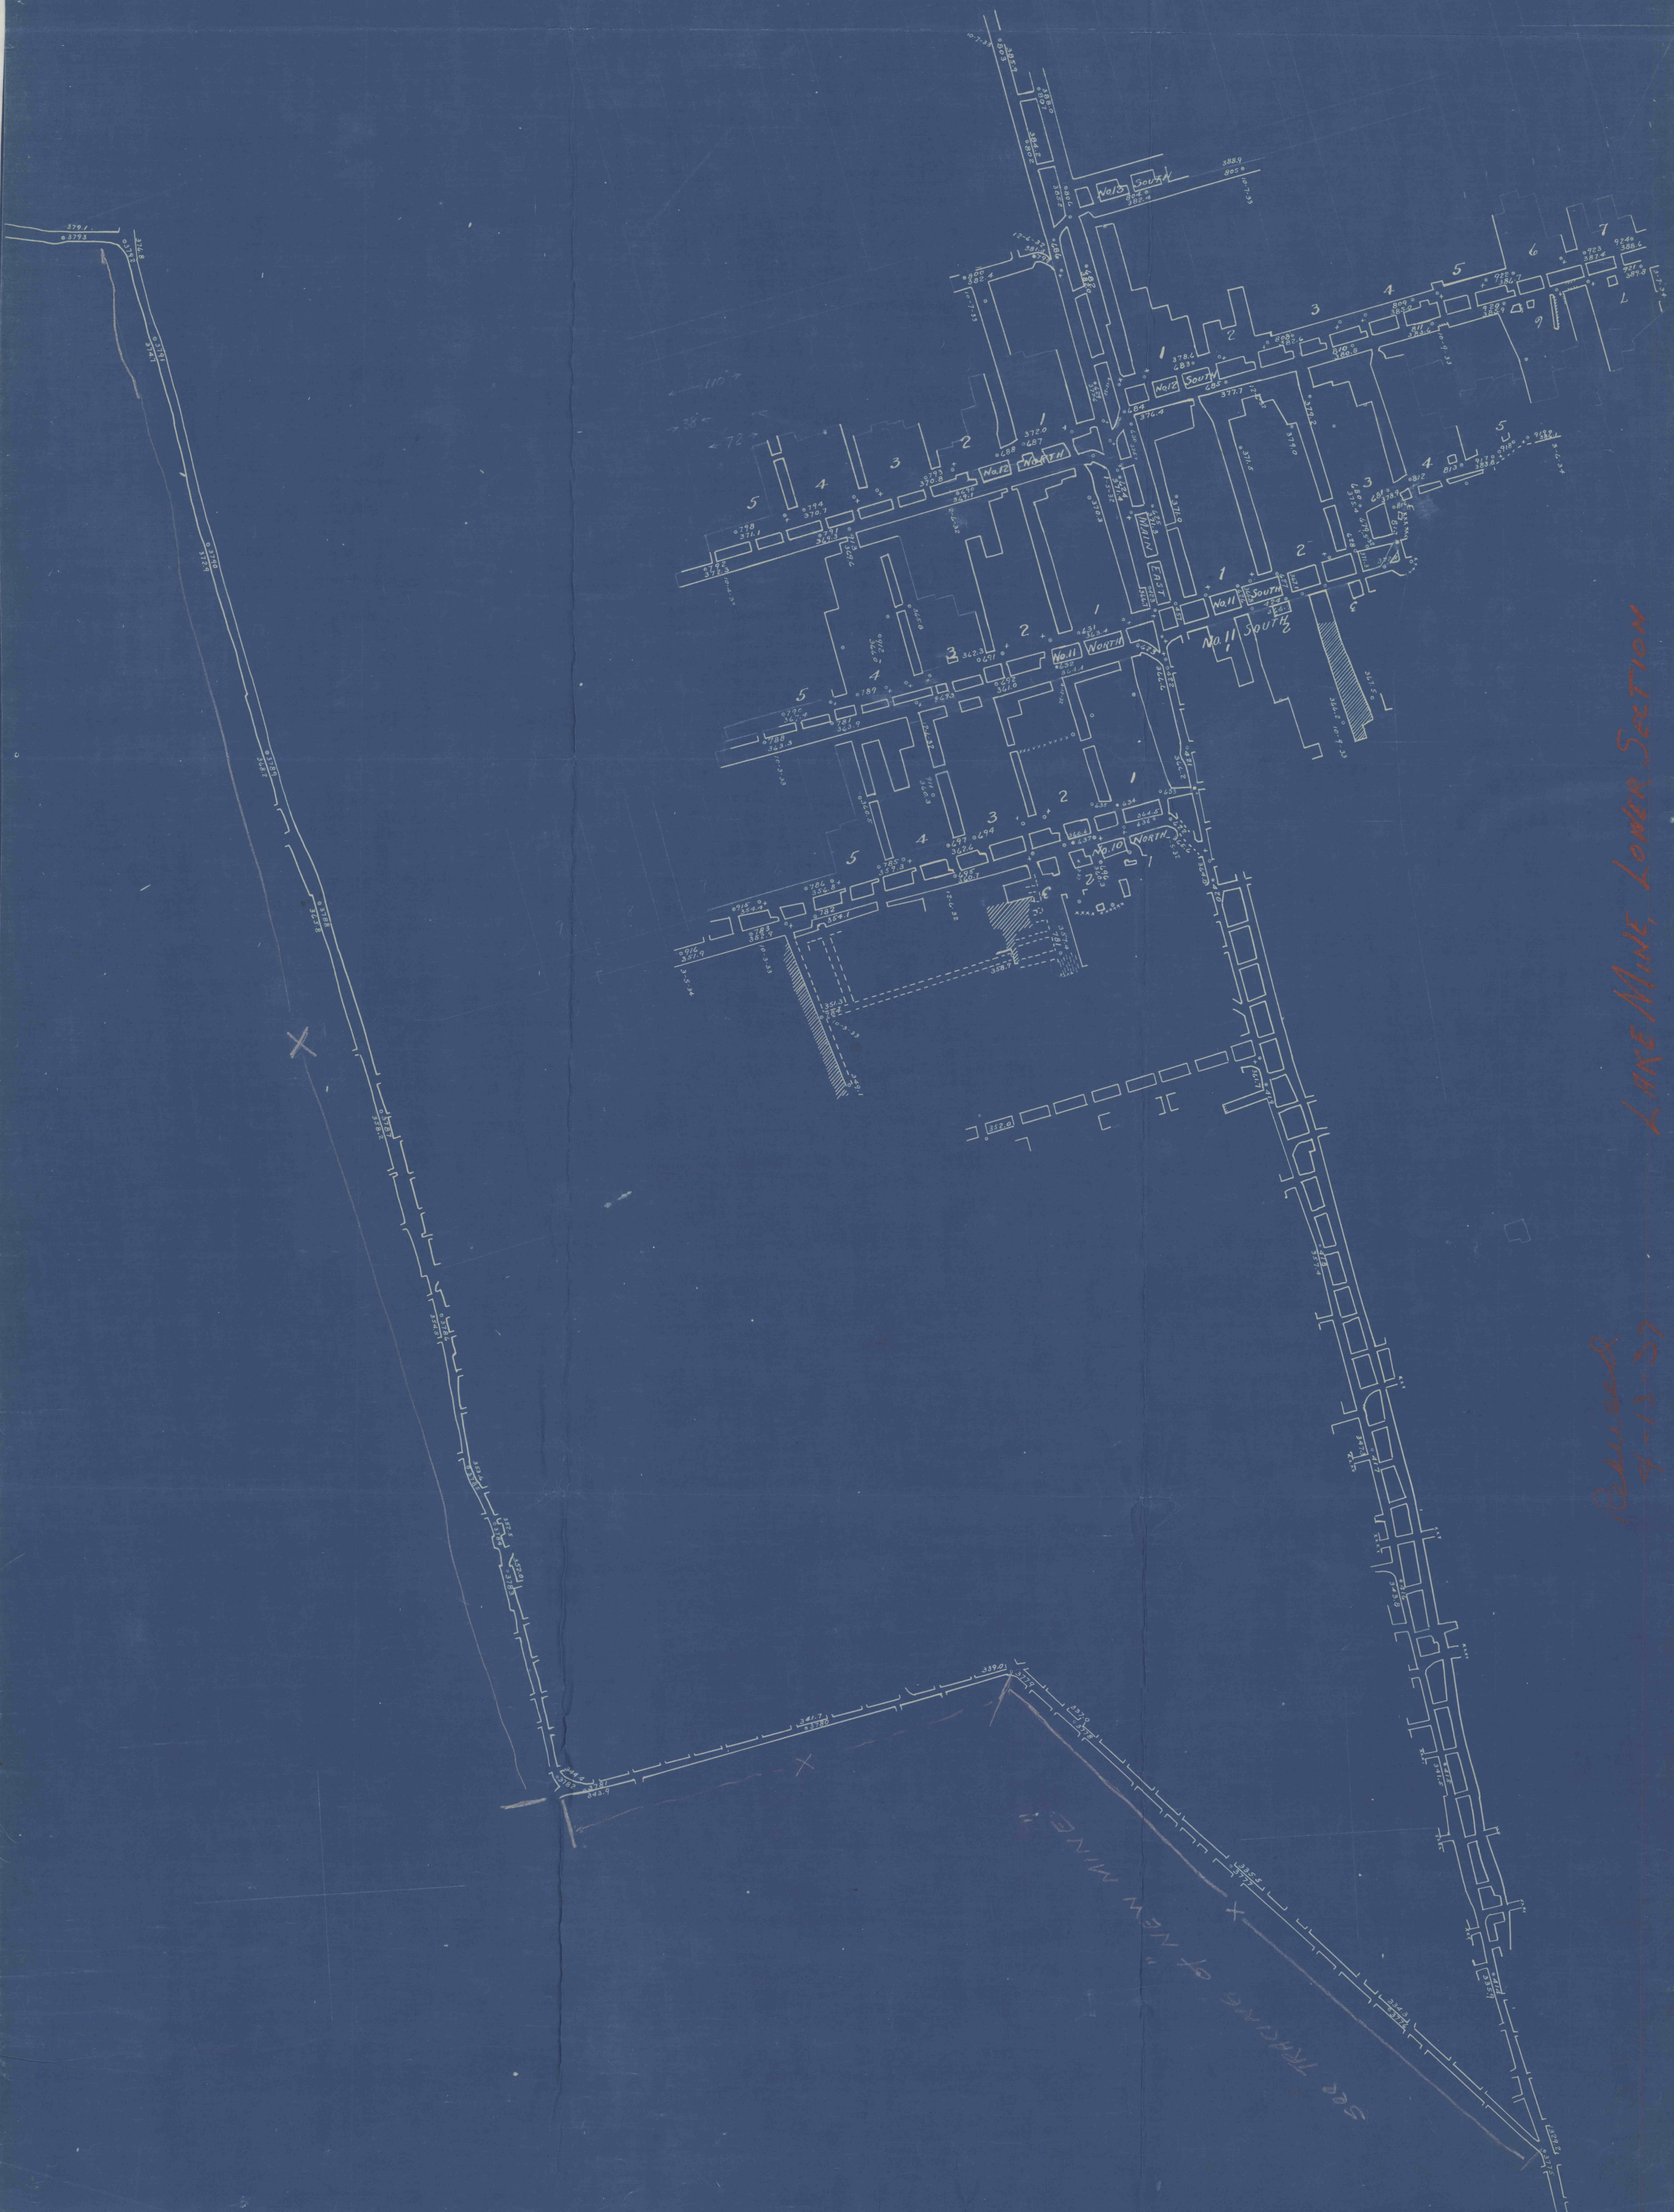

LANE MINE, LOWER SECTION

Revised
4-13-37

SEE TRACKS OF NEW MINE