


APRIL 14, 1914

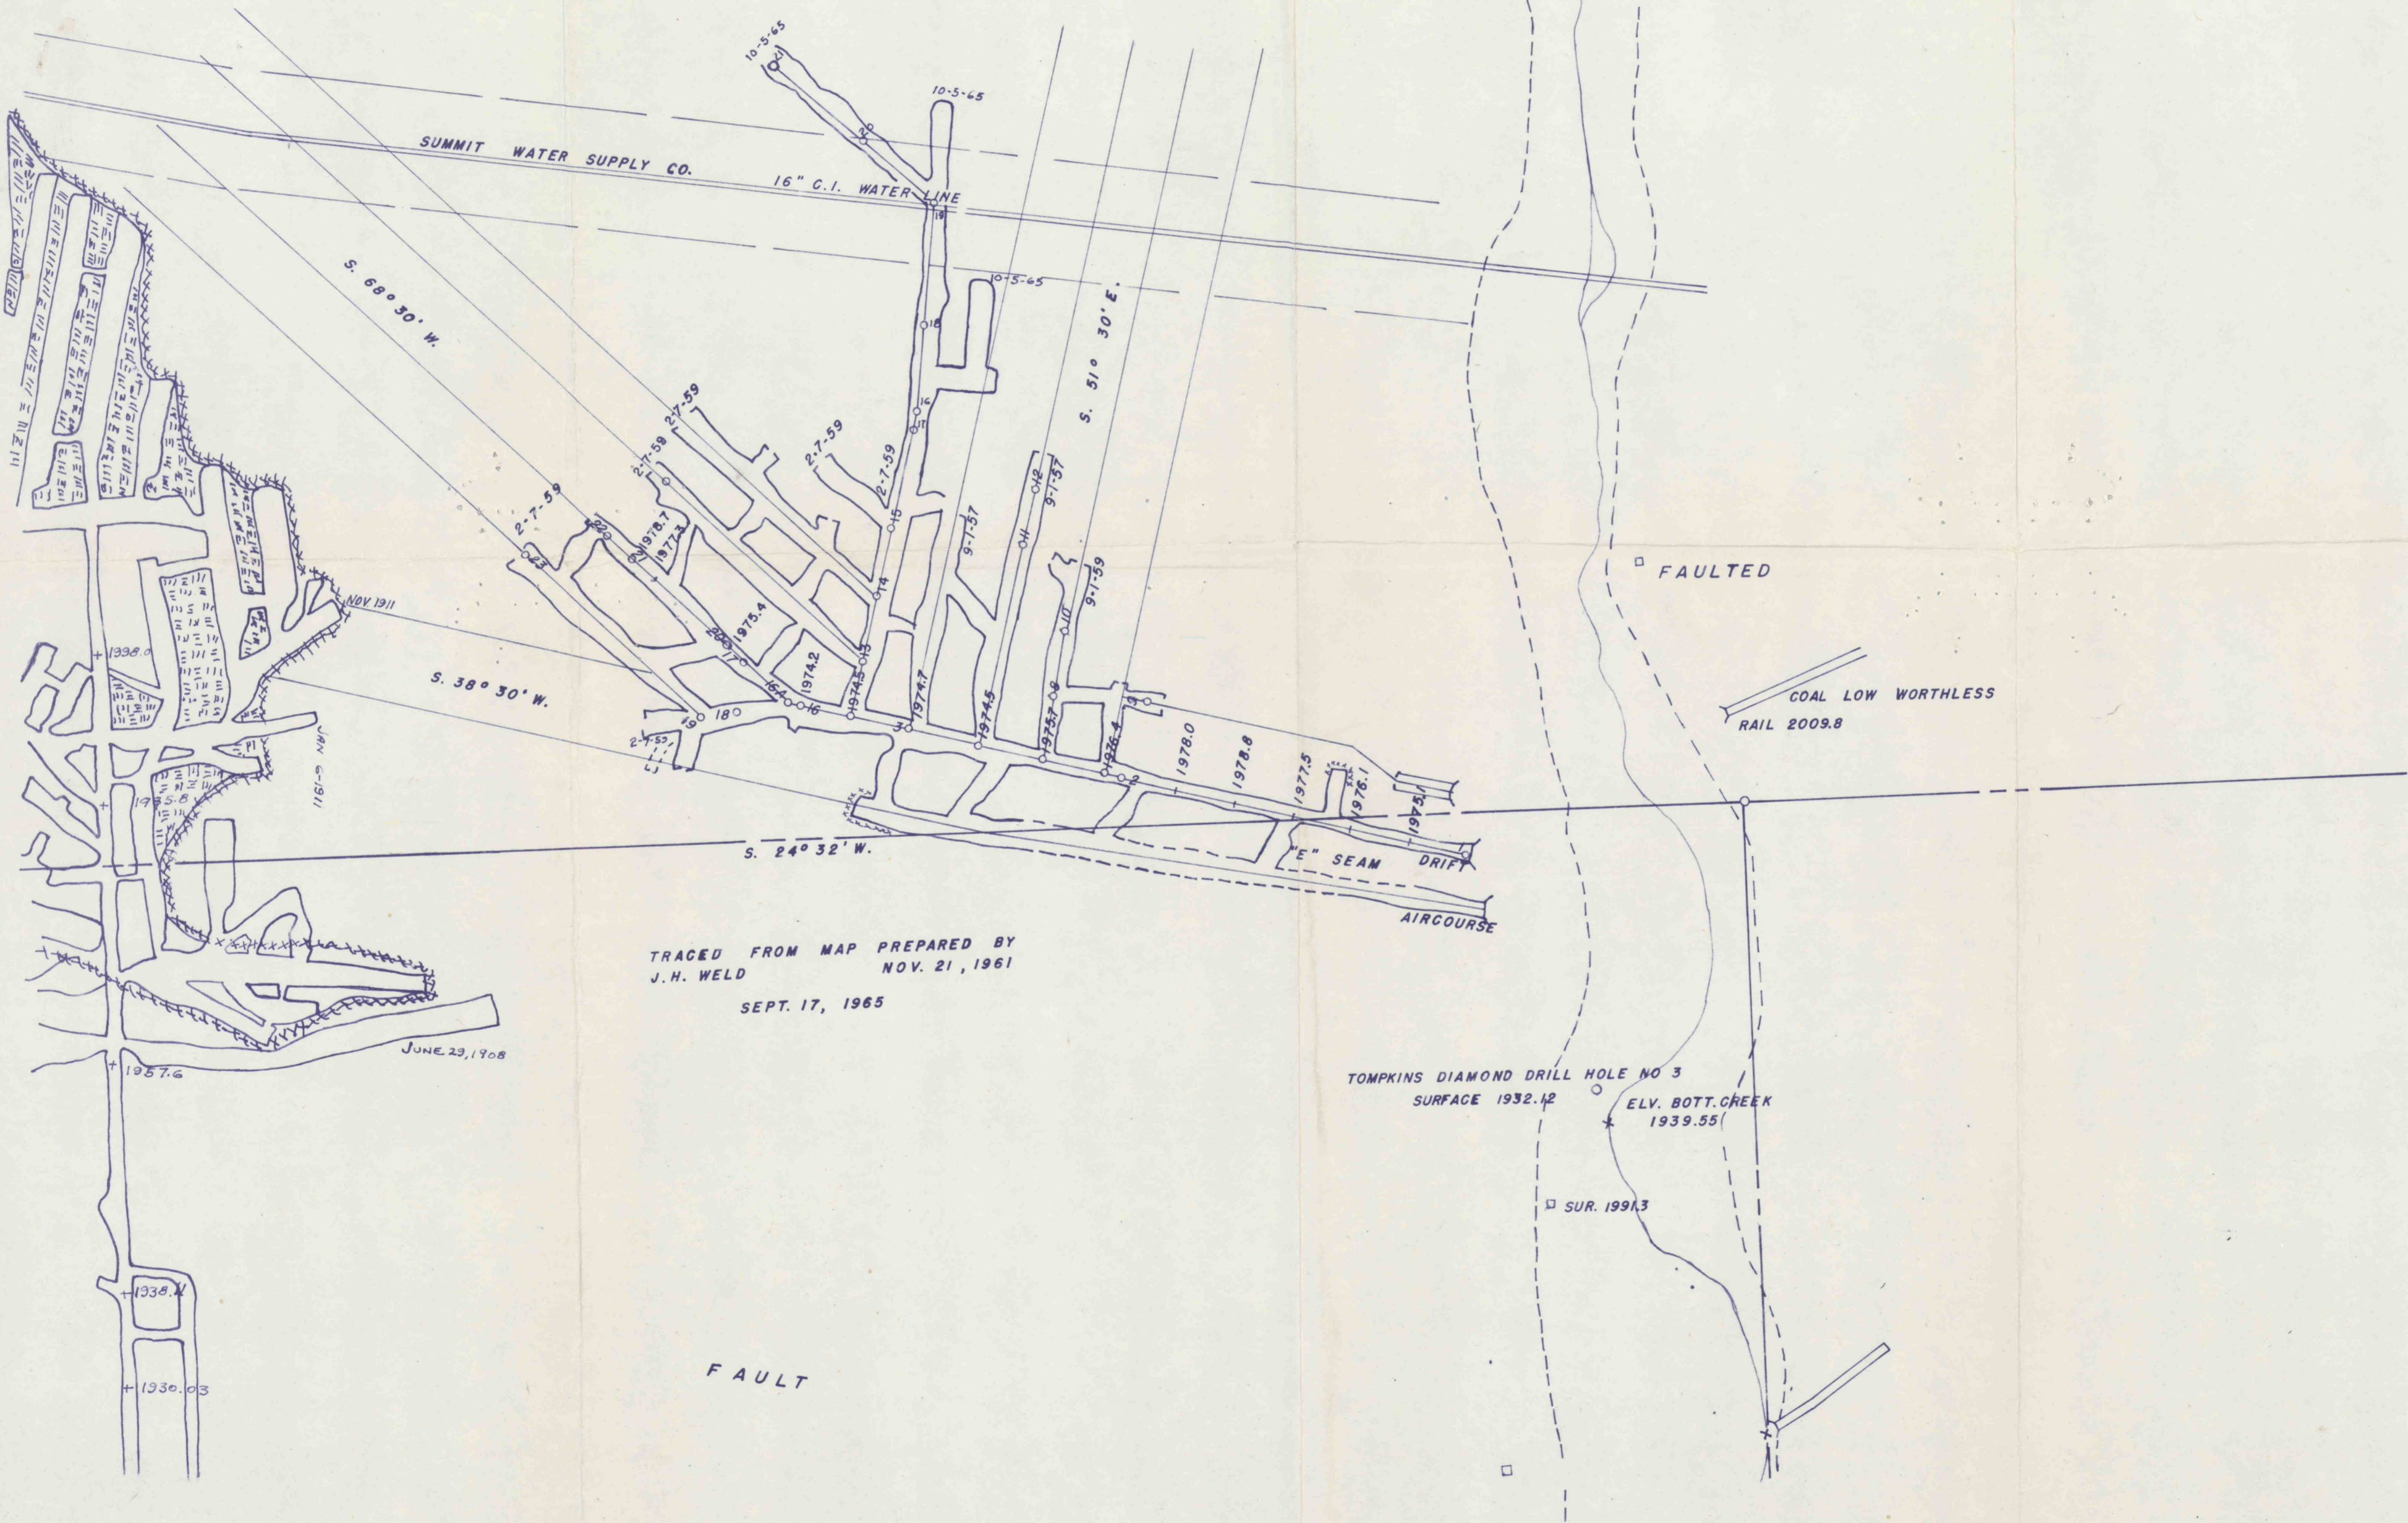

TRACED FROM MAP PREPARED BY
J.H. WELD NOV. 21, 1961
SEPT. 17, 1965

TOMPKINS DIAMOND DRILL HOLE NO 3
SURFACE 1932.12
ELV. BOTT. CREEK 1939.55

FAULT

COAL LOW WORTHLESS
RAIL 2009.8

FAULTED

FAULTED

ELV. BOTT. CREEK 2047.0

ELV. BOTT. CREEK 2059.0

ELV. BOTT. CREEK 206.79

SUR. 1991.3

SUMMIT WATER SUPPLY CO.
16" C.I. WATER LINE

S. 68° 30' W.
S. 38° 30' W.

S. 51° 30' E.

S. 24° 32' W.

NOV 1911

JAN 1911

JUNE 29, 1908

AIRCOURSE

"E" SEAM DRIFT



2-7-59

2-7-59

2-7-59

2-7-59

2-7-59

2-7-59

2-7-59

2-7-59









10-5-65

10-5-65

