


MATCH TO 15A

MATCH TO 15B

I HEREBY CERTIFY THAT THE PRINTED MATERIAL ON THIS MAP CORRECTLY SHOWS THE MINE AND PROPERTY OF INLAND STEEL COAL COMPANY LANCASTIRE NO. 25 MINE AS OF AUGUST 1, 1985. THIS MAP SHOWS THE FINAL WORKINGS OF THE MINE PRIOR TO SEALING.

I FURTHER CERTIFY THAT THIS MAP WAS REPRODUCED UNDER MY JURISDICTION, FROM THE FIELD SURVEYS, AND THAT THE SURVEYS ON THE SURFACE AND UNDERGROUND ARE CORRECTLY COORDINATED, AND THE MAP IS CORRECT TO THE BEST OF MY KNOWLEDGE AND BELIEF.

David M. Hedges
 DAVID M. HEDGES, P.E.
 PROJECT ENGINEER
 REGISTERED PROFESSIONAL ENGINEER OF
 THE COMMONWEALTH OF PENNSYLVANIA
 NO. PE-034335-E

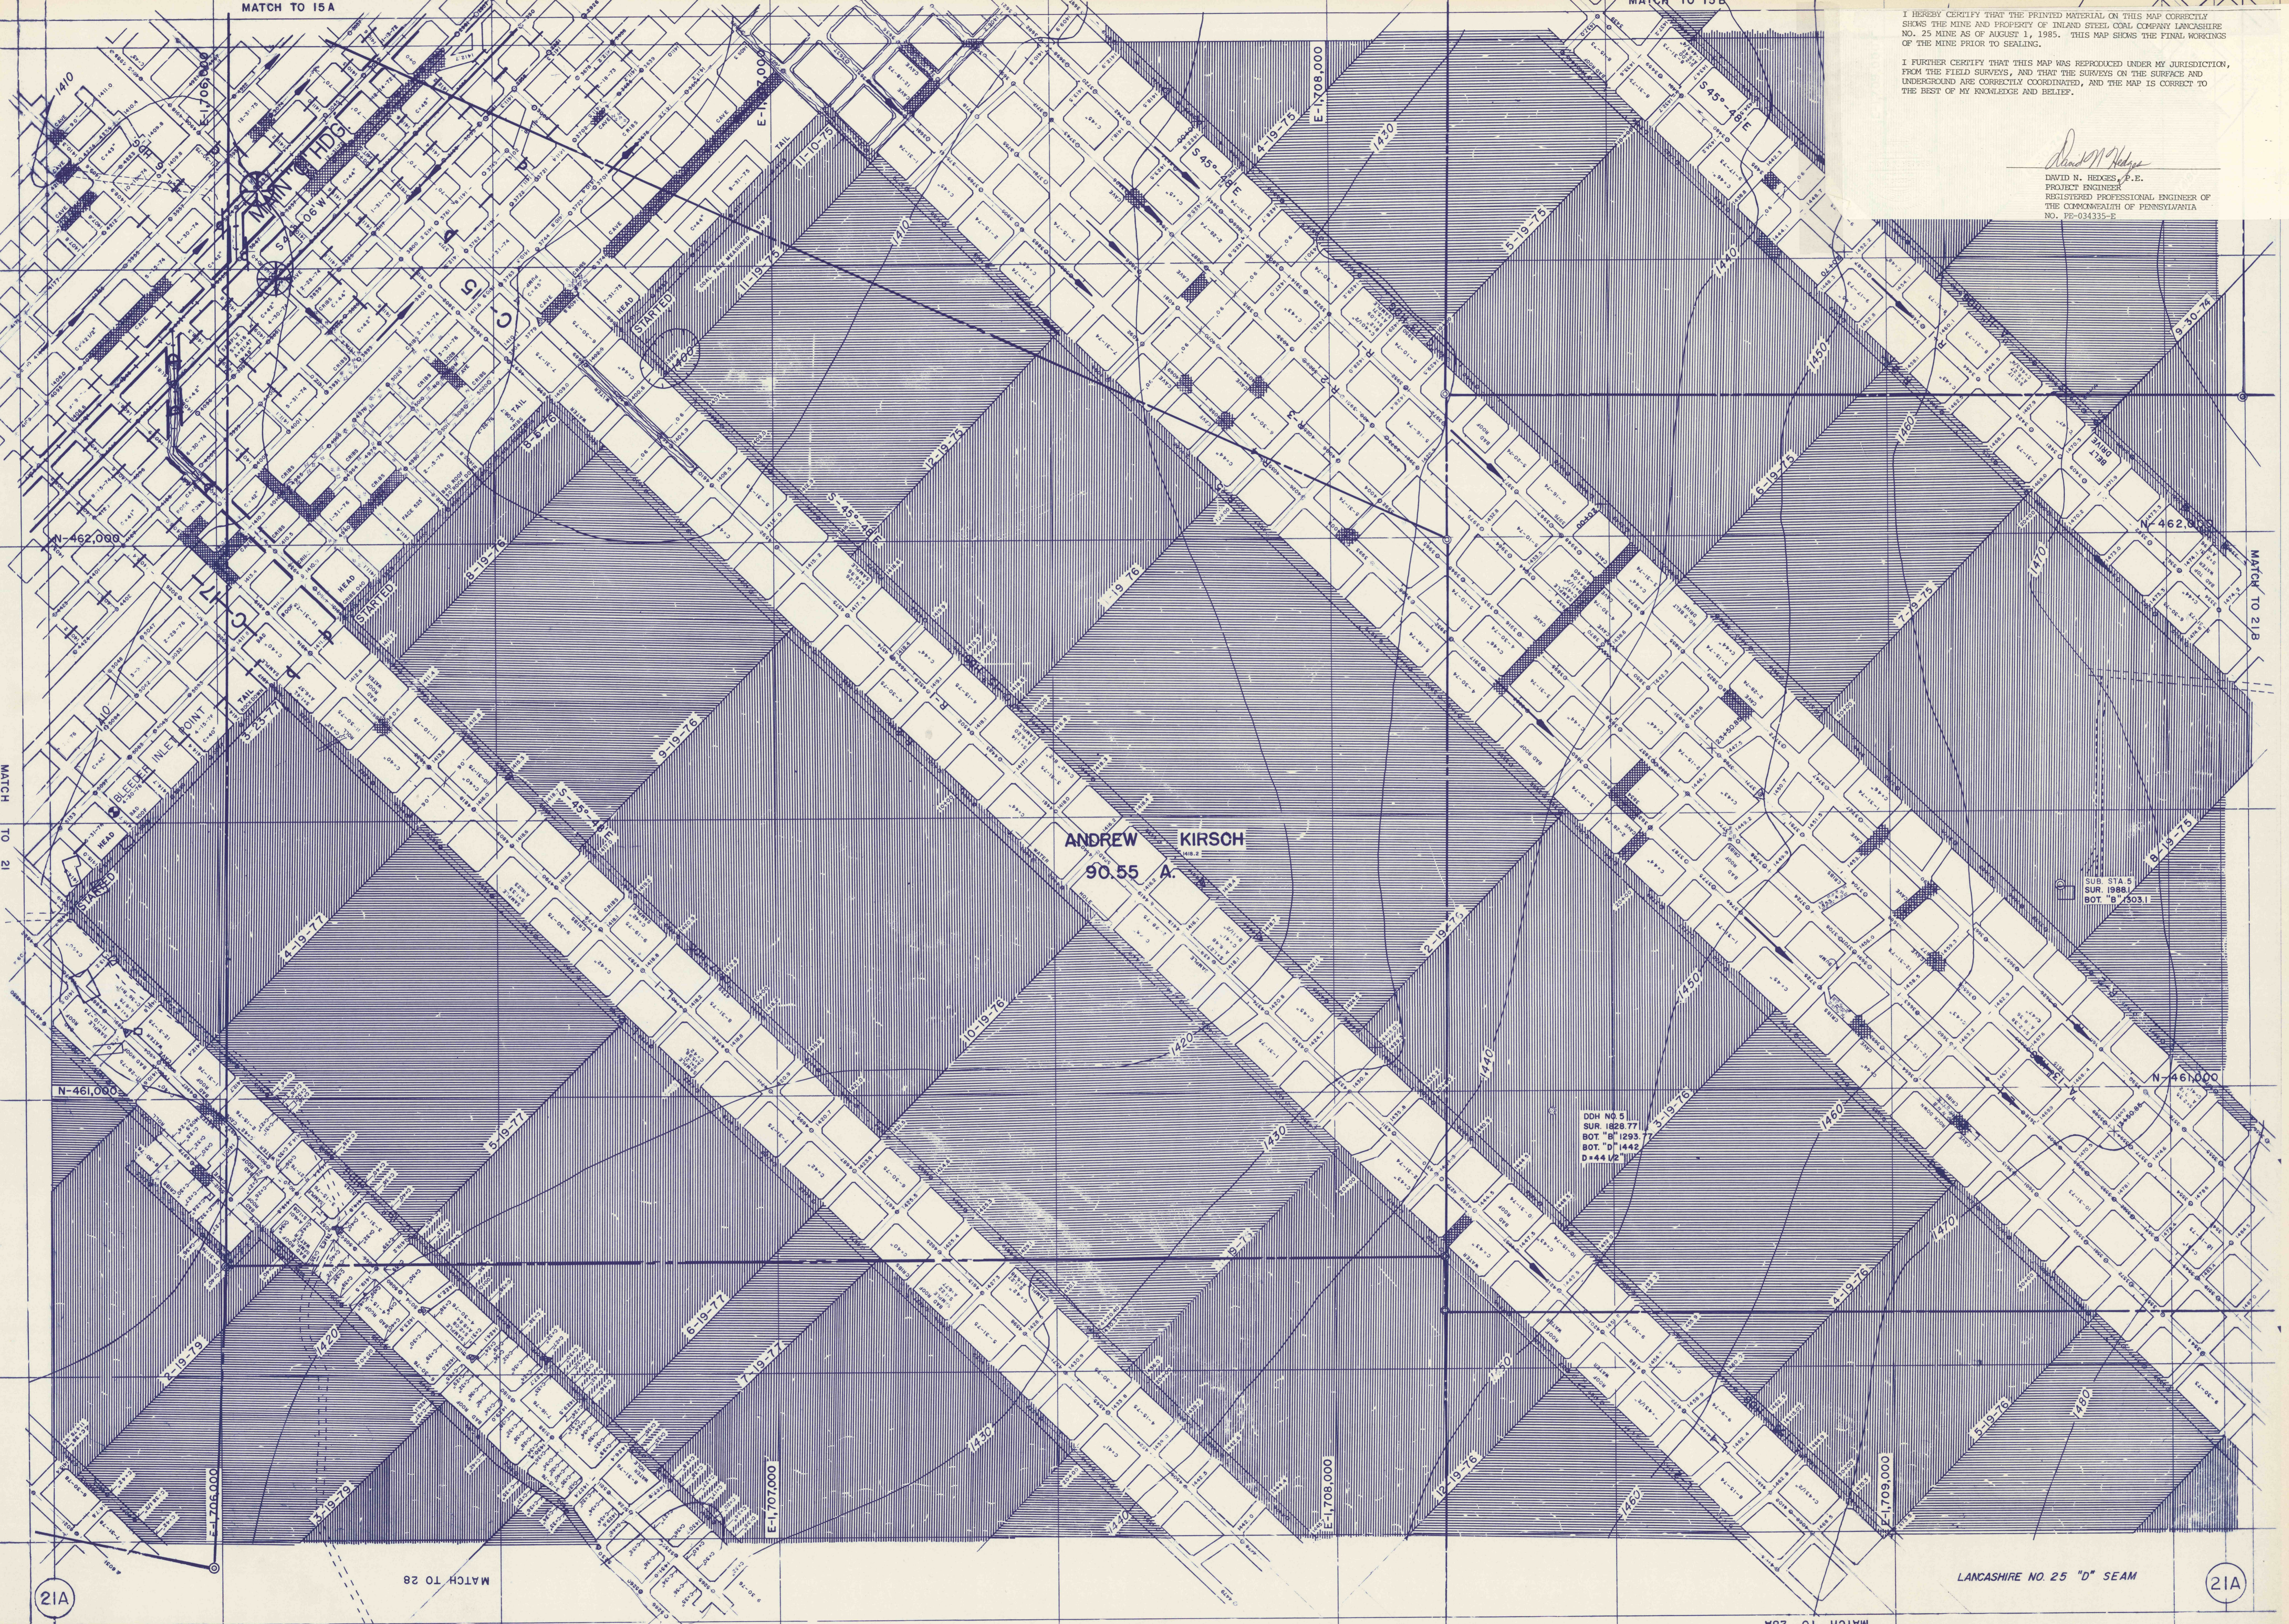

ANDREW KIRSCH
 90.55 A.

DDH NO 5
 SUR. 1928 771
 BOT. 'B' 1293 7
 BOT. 'D' 1442
 D=44 1/2'

LANCASTIRE NO. 25 "D" SEAM

21A

21A

MATCH TO 21

MATCH TO 21B

MATCH TO 28

MATCH TO 28A