

D.H. 53
1000.04
306 - 1000.04
797.01

A. DEEMER


P. WAGNER

R. CONRAD

D. WOODSIDE

H. LOWMAN

#119

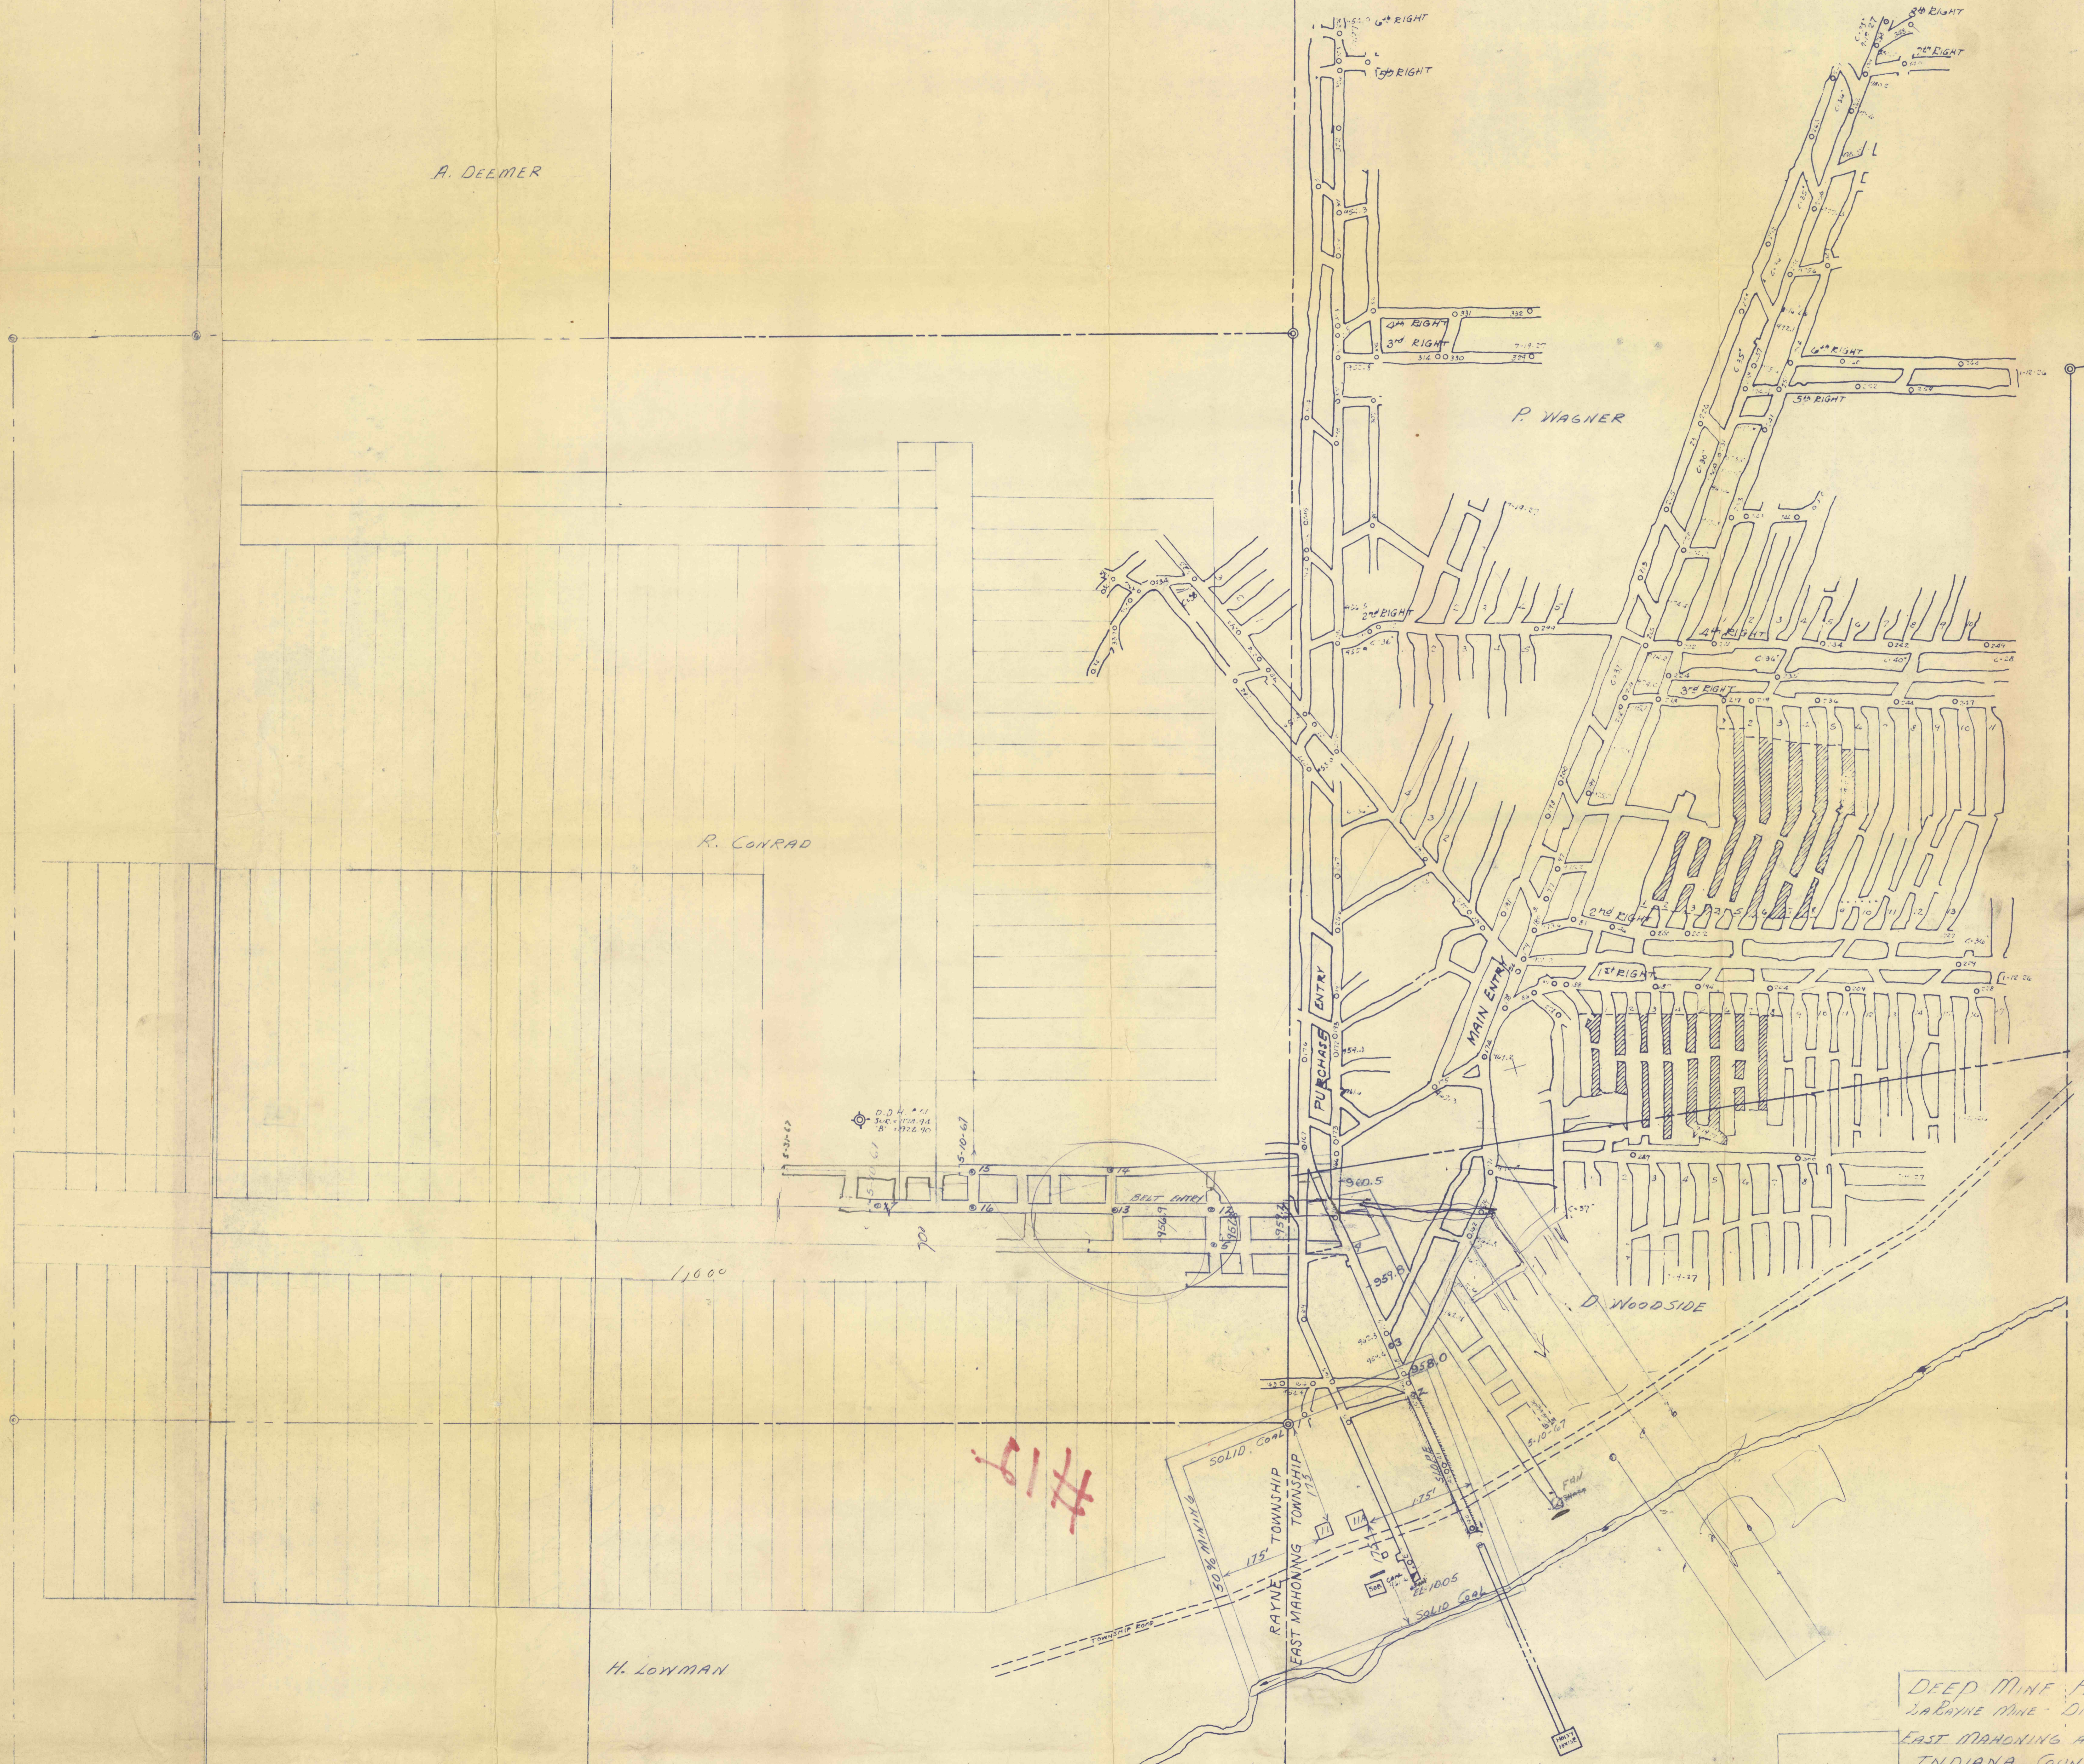

DEEP MINE PROPERTY MAP
 LA RAYNE MINE - DIXON RUN COAL CO.
 EAST MARIONING AND RAYNE TOWNSHIPS,
 INDIANA COUNTY, PENN. A.
 B-SEAM SCALE - 1" = 100'
 DRAWN BY - A.K.B. AND J.C.P.
 DATE - 5-10-67