

GEORGE LASH AND JOE LASH - COAL CO.

CURWENSVILLE, PA.



MAP OF MINE

PIKE TWP, CLFD. CO. PA.

SCALE 1" = 100'

CLEARFIELD, PA.  
OCT 10, 1957

ROY C. KINDIG  
REG. ENGR.

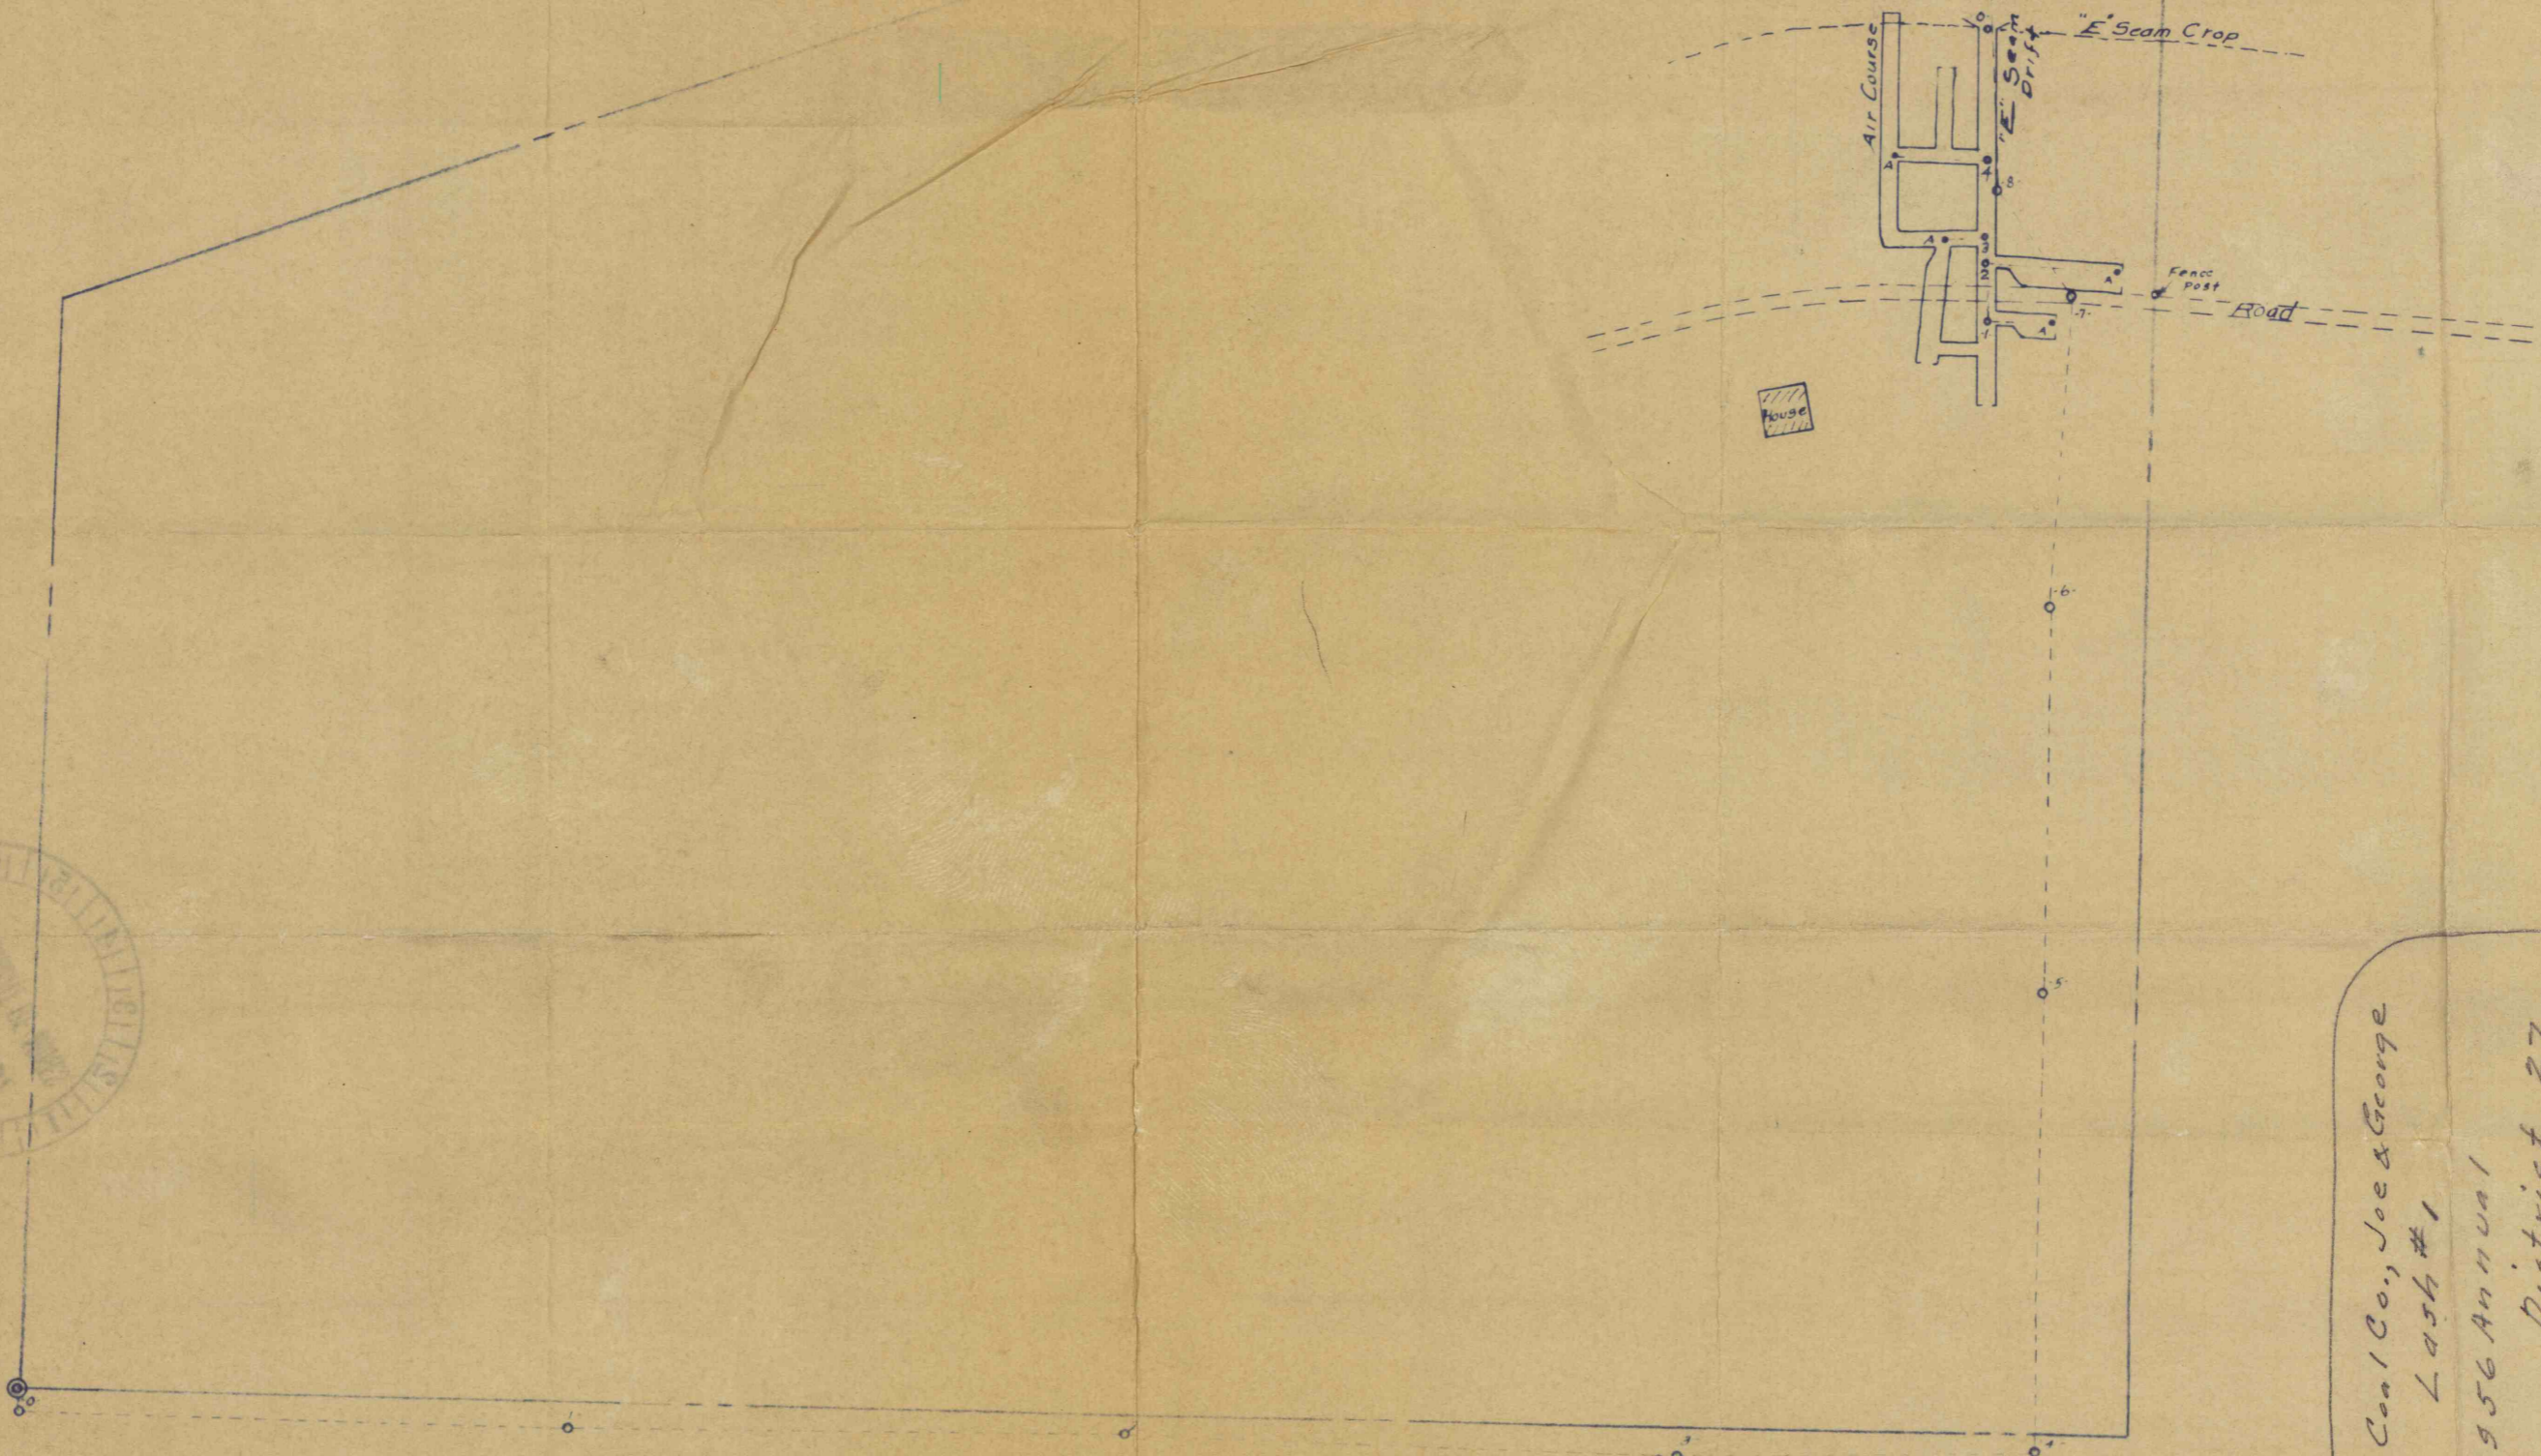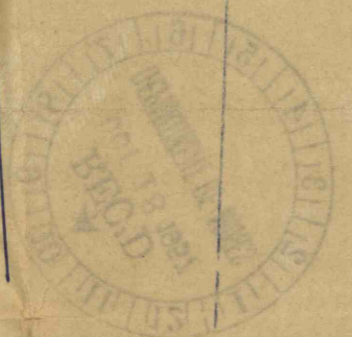

Lash Coal Co., Joe & George  
Lash #1  
1956 Annual  
District 27  
Clearfield Co.

250