


TOTAL ACREAGE 8.41
 MINED 0.81
 TO BE MINED 7.60

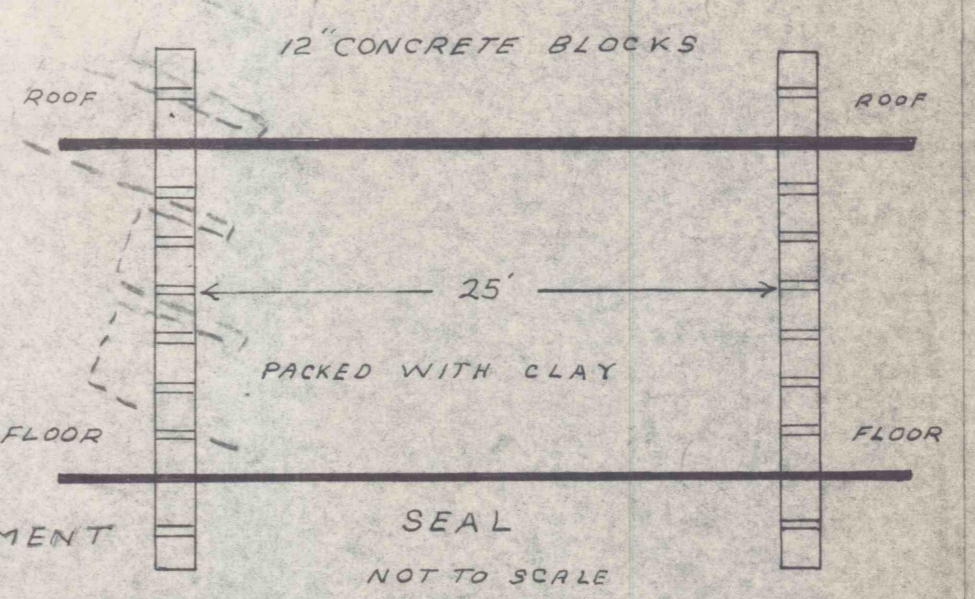

HOLDING LAGOON ALKALINE WATER
 NO DISCHARGE CAPACITY 555,000 GAL.

- LEGEND**
- = MINING COMPLETED JUNE 4, 1971
 - = 6 MONTHS ADVANCE
 - = PROPERTY LINE

**JOSEPH LAW
 MINE NO. 17
 LOWER FREEPORT SEAM
 STONYCREEK TWP. SOMERSET CO. PA.
 SCALE - 1" = 100' NOV. 21, 1966
 V. E. ERICKSON R. P. E. No. 7074
 V. E. Erickson**

