
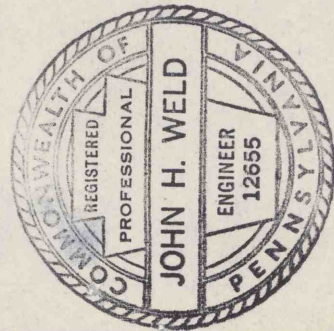
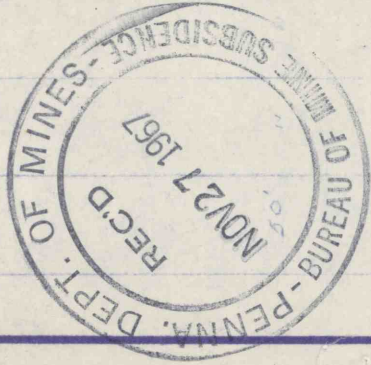


SECTION MAP

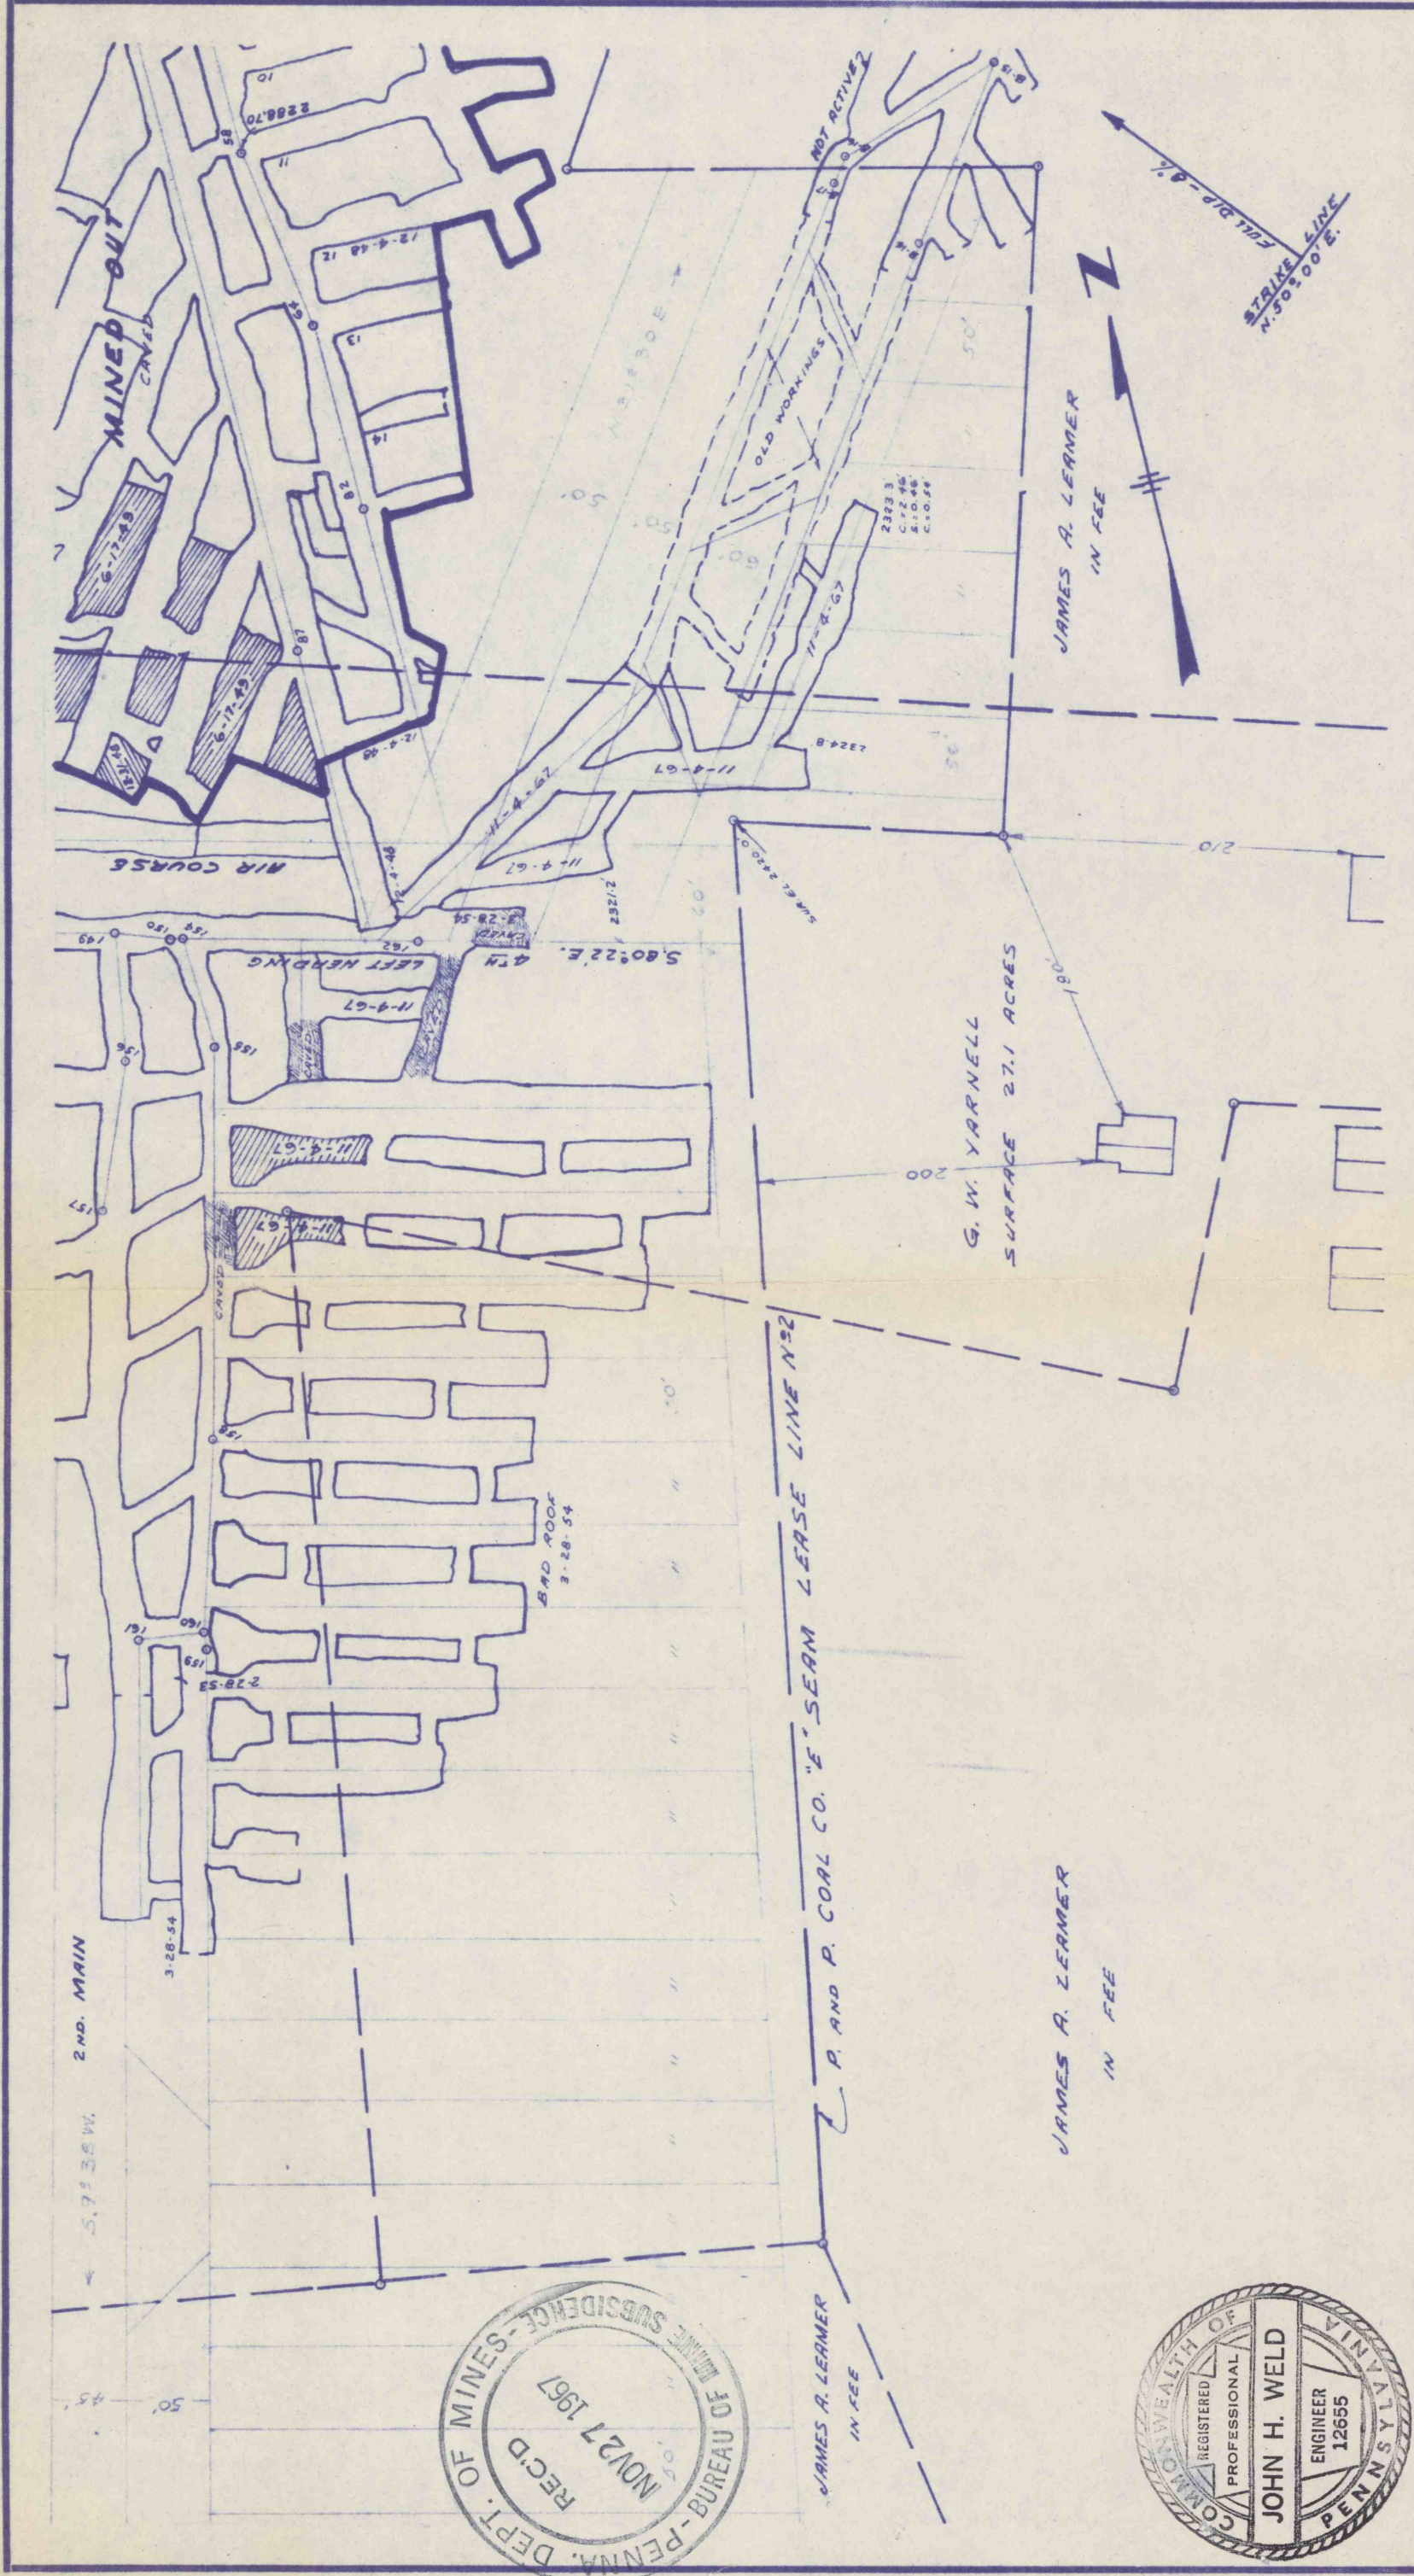

SIX MONTHS PROJECTION 10-1-66 SCHEDULE 4-1-67 11-4-67 SCHEDULE 5-4-68 UPPER FREEPORT REFERENCES "E" SEAM		DRAWN BY REVISIONS	NAME DATE	JOHN H. WELD PROFESSIONAL ENGINEER R. D. 1, BOX 52 SOUTH FORK, PA.	R. AND P. COAL COMPANY MINING METHOD ROOM AND PILLAR SYSTEM SPLITTING PILLARS AND STUMPS ON RETREAT. COAL = 3' 2"	SCALE 1"=100 FT. B. M. NO. FILE # 67 MINING OCT. 1, 1966
DWG. NO. 5						