


LEVI McGUIRE TRACT

E NORTON TRACT

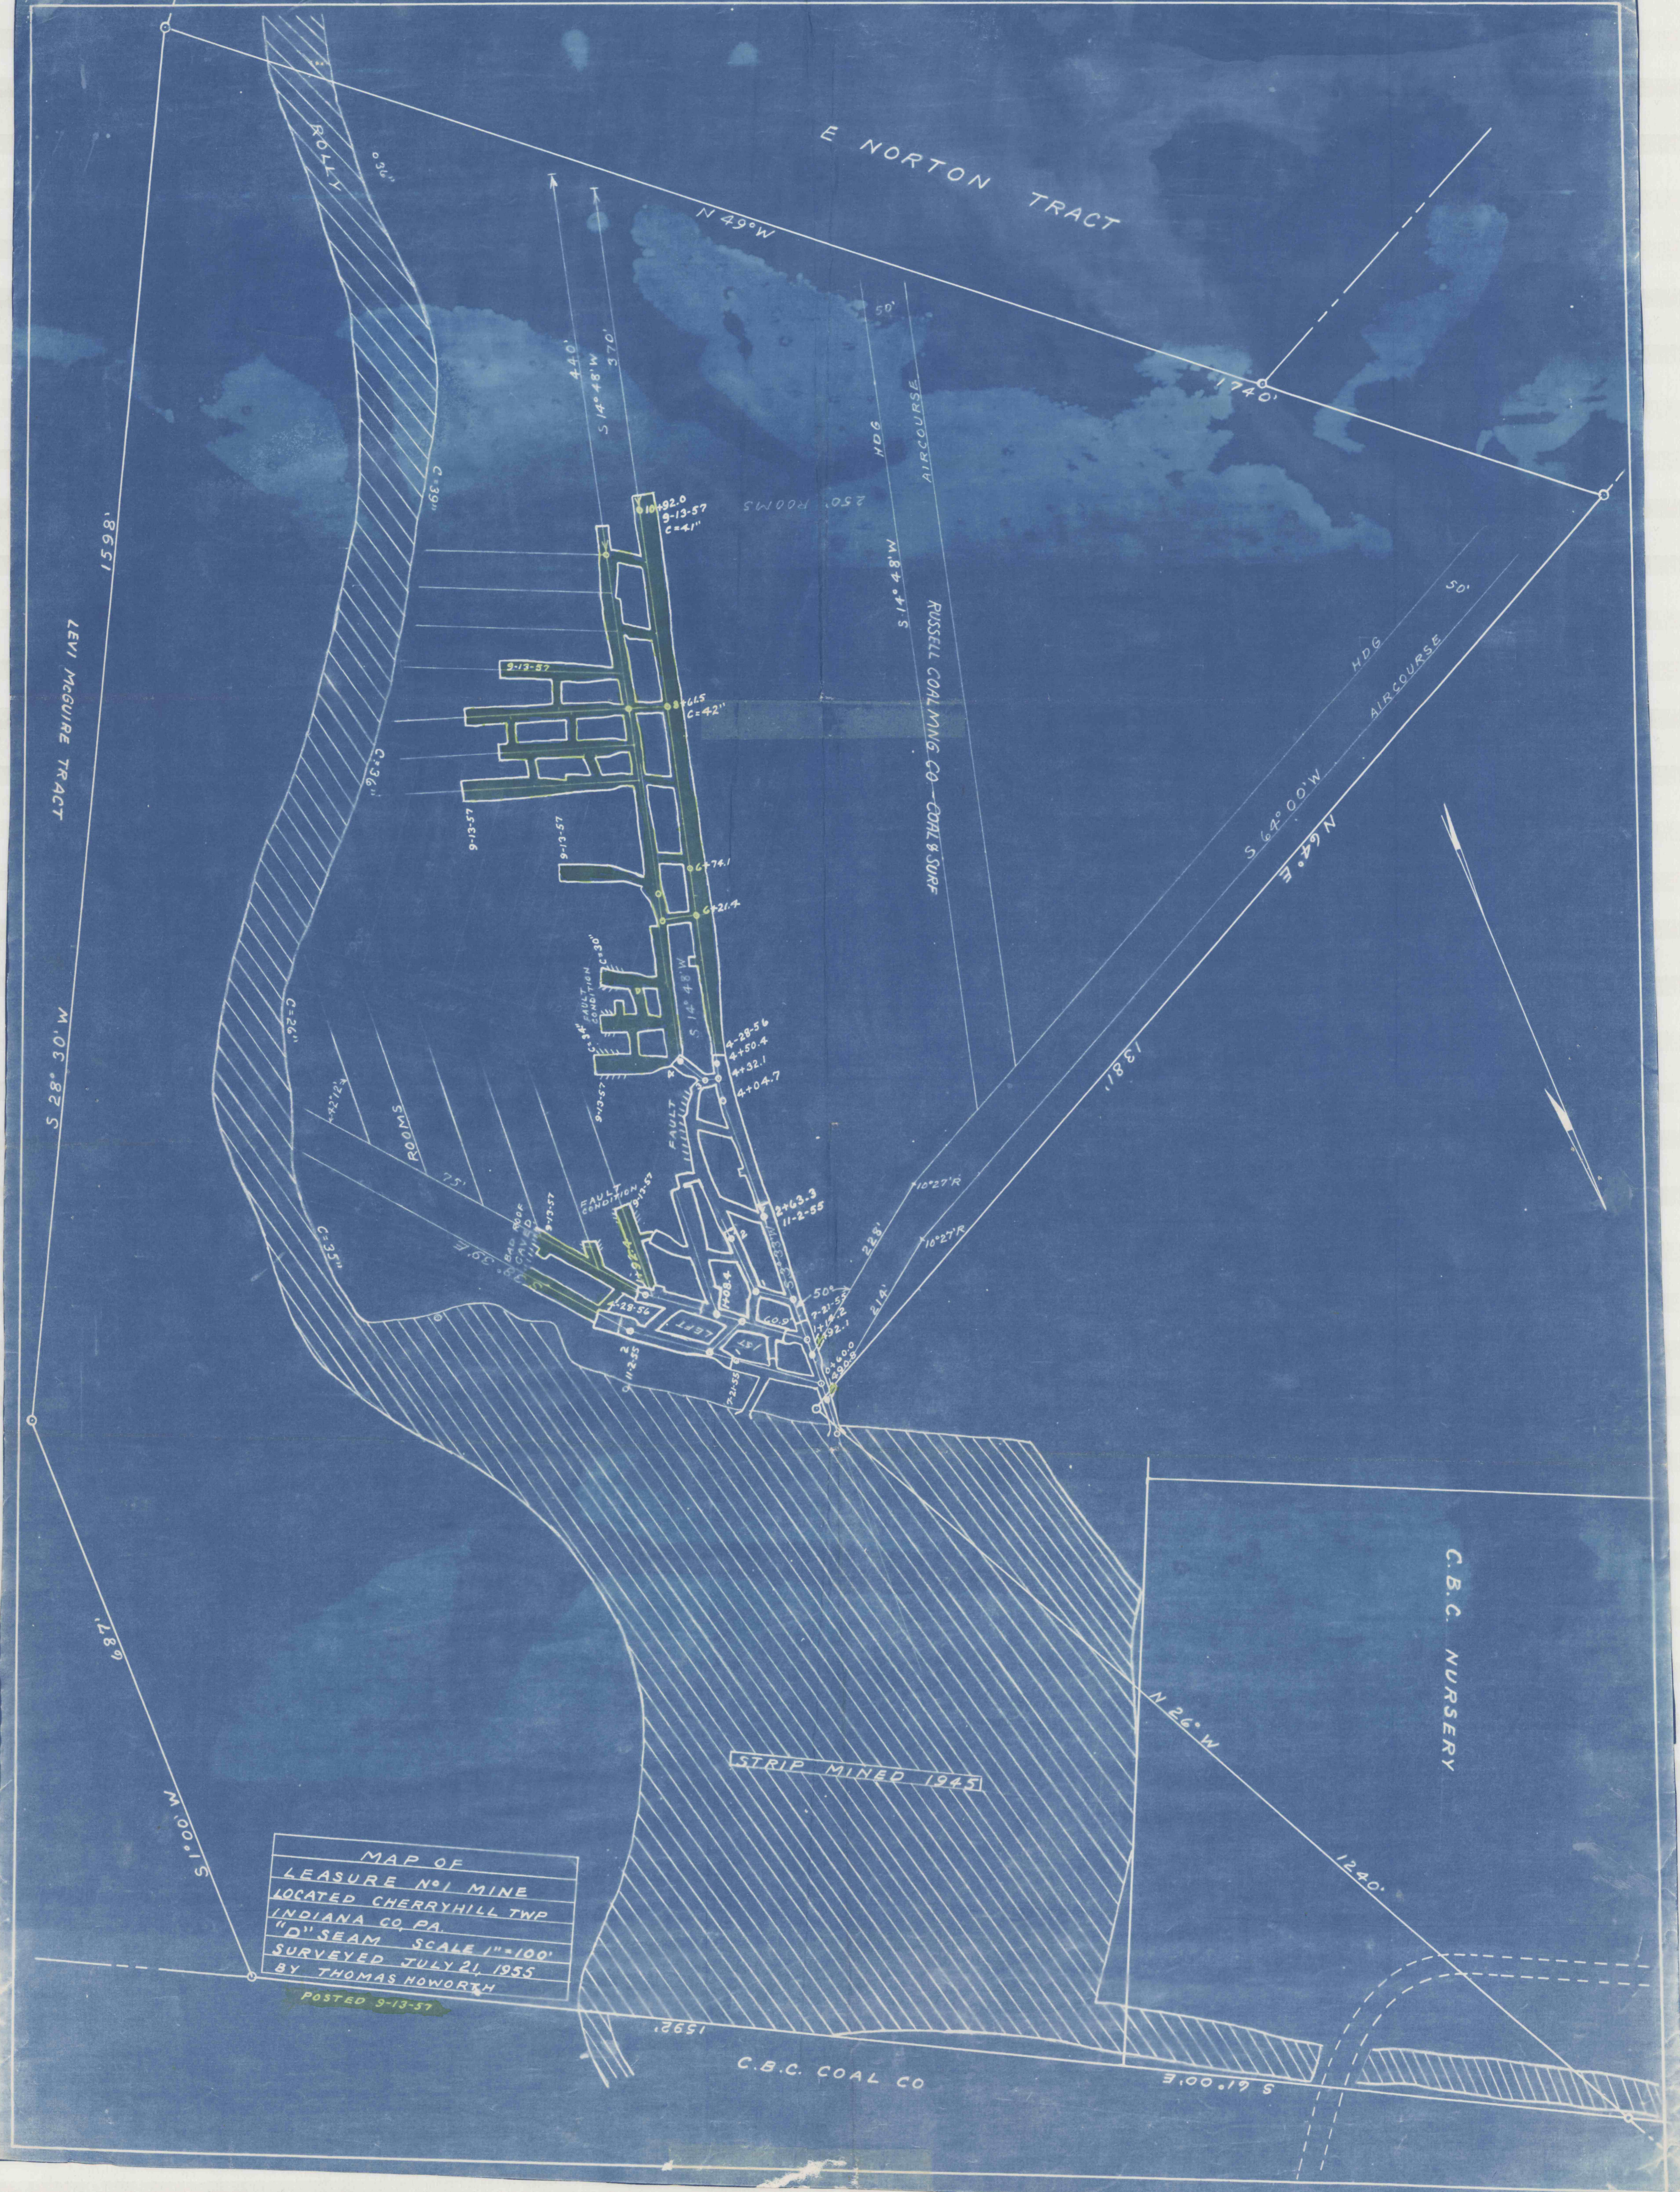

M. 02° 48' S

687'

M. 00° 15' S

MAP OF
LEASURE NO. 1 MINE
LOCATED CHERRYHILL TWP
INDIANA CO, PA.
"D" SEAM SCALE 1"=100'
SURVEYED JULY 21, 1955
BY THOMAS HOWORTH

POSTED 9-13-57

STRIP MINED 1945

C.B.C. COAL CO

C.B.C. NURSERY

18651

N 49° W

440'

S 14° 48' W

370'

50'

HDG AIR COURSE

RUSSELL COALMING CO - COAL & SURF

1740'

50'

HDG AIR COURSE

M. 00° 42' S

N 64° E

1381'

10° 27' R

10° 27' R

228'

214'

ROOMS

75'
















FAULT CONDITION



















250' ROOMS

10+22.0

11-17-2

11-17-2

