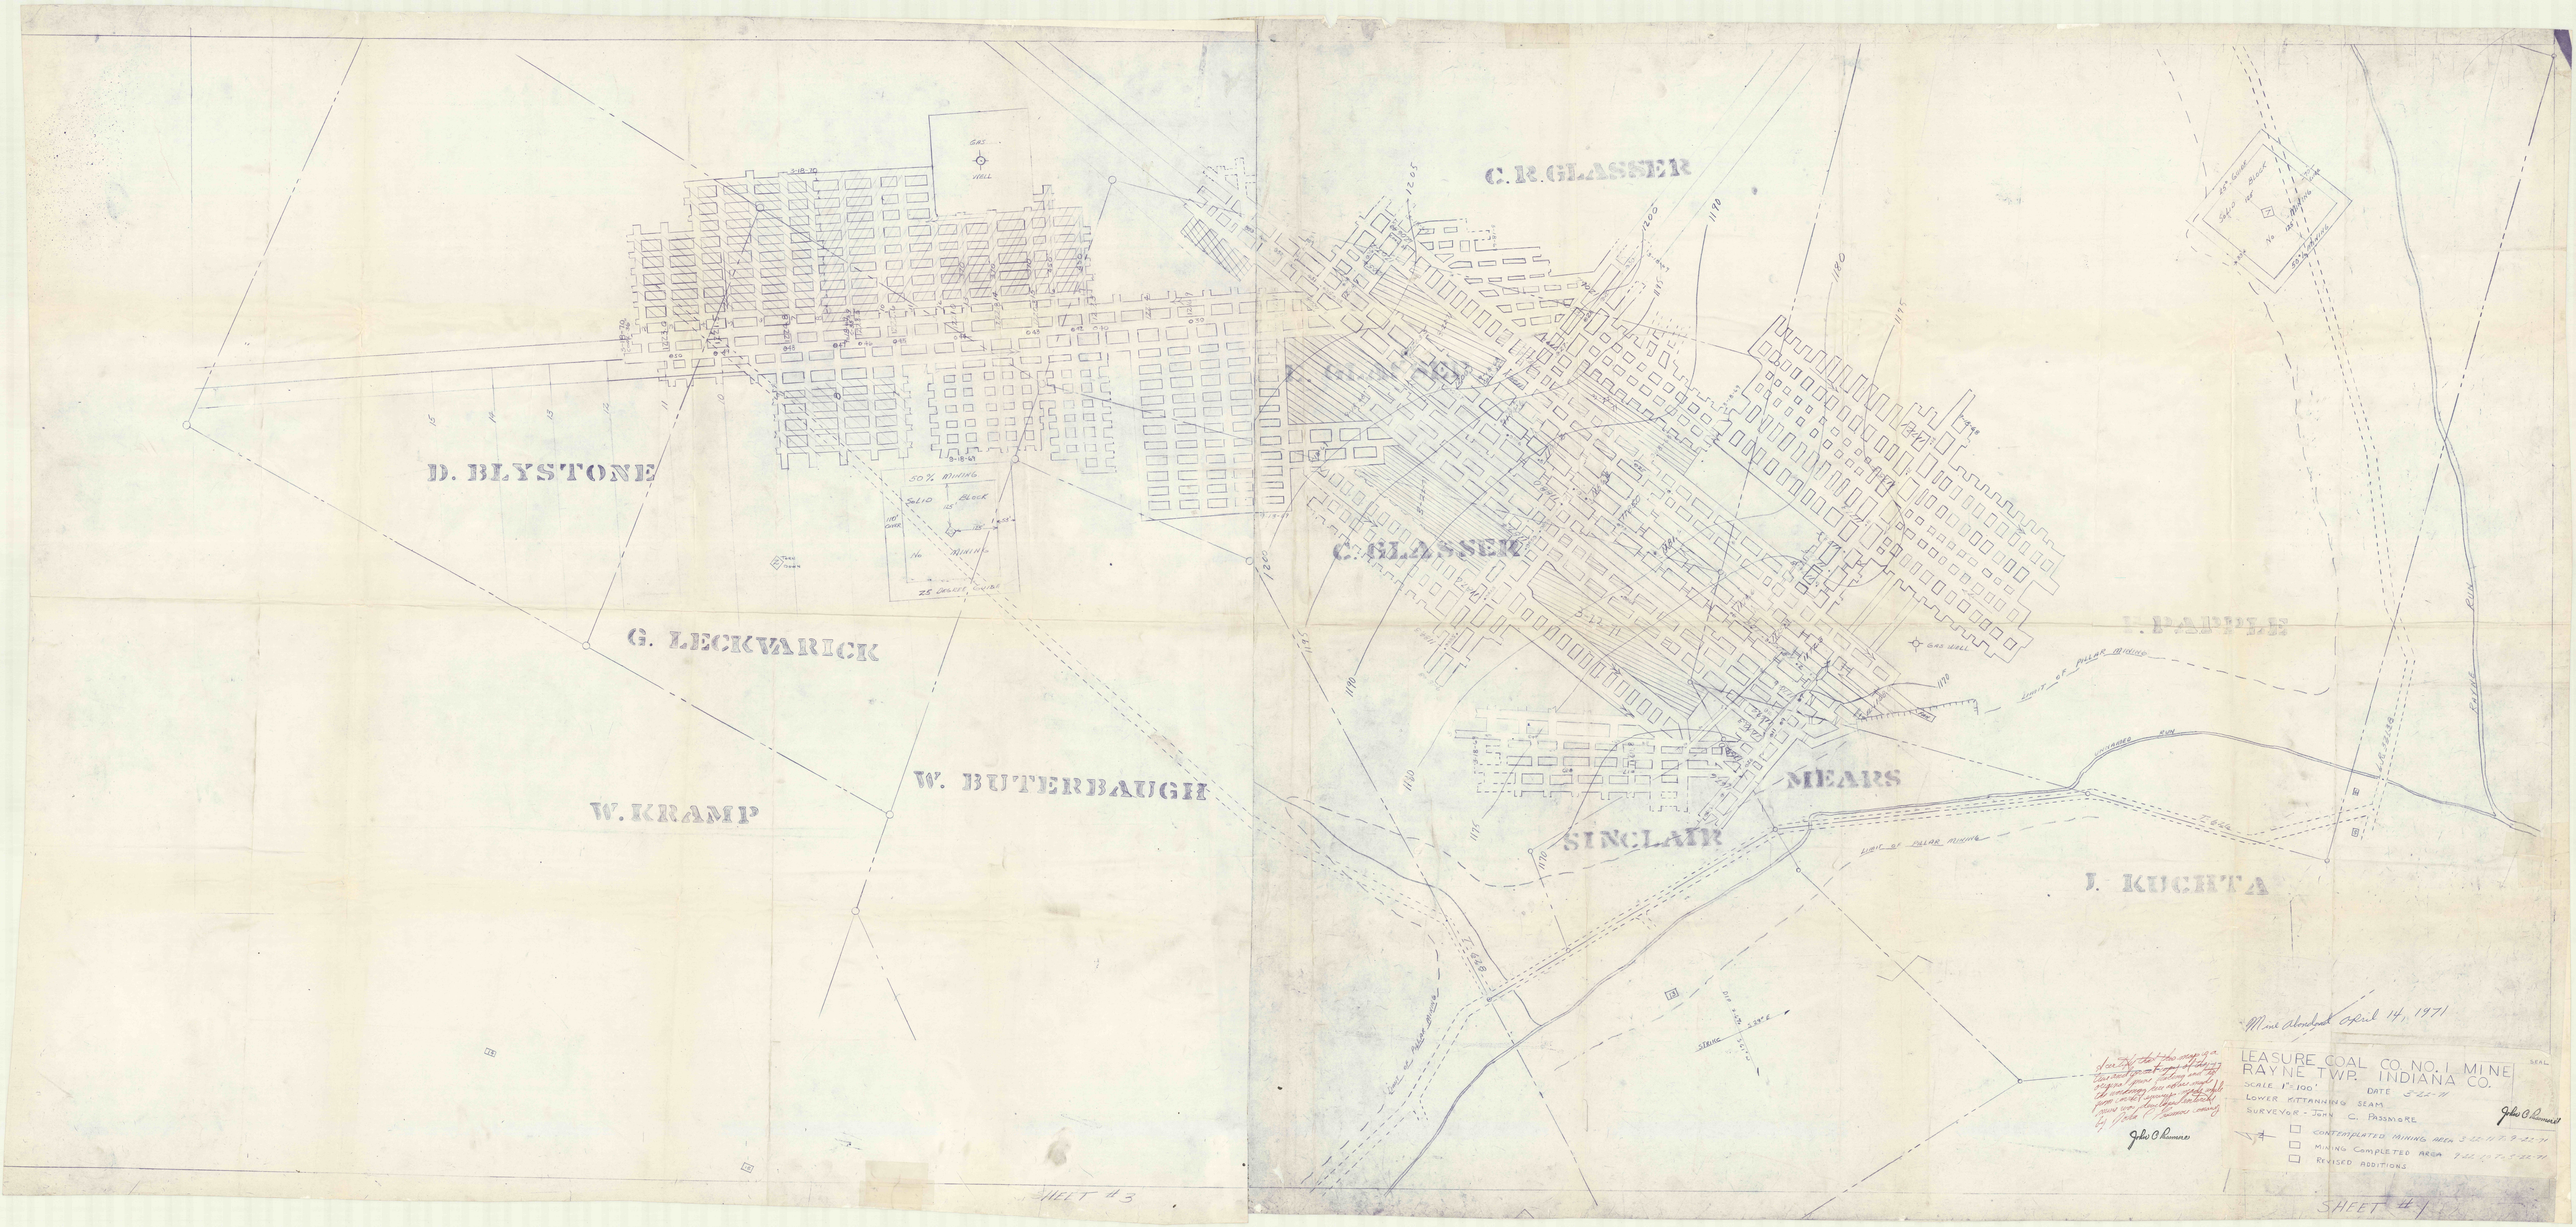
D. BLYSTONE
G. LECKVARICK
W. KRAMP
W. BUTTERBAUGH
C. R. GLASSER
C. GLASSER
MEARS
SINCLAIR
J. KUCHTA
J. BAPPLE
GAS WELL
50% MINING
SOLID BLOCK
No MINING
25 CHAINS, CHAINS
LIMIT OF PILLAR MINING
STRING
Mine abandoned April 14, 1971
LEASURE COAL CO. NO. 1 MINE
RAYNE TWP. INDIANA CO.
SCALE 1" = 100'
DATE 5-22-71
LOWER KITTANNING SEAM
SURVEYOR - JOHN C. PASSMORE
CONTEMPLATED MINING AREA
MINING COMPLETED AREA
REVISED ADDITIONS
SHEET #1
SHEET #3