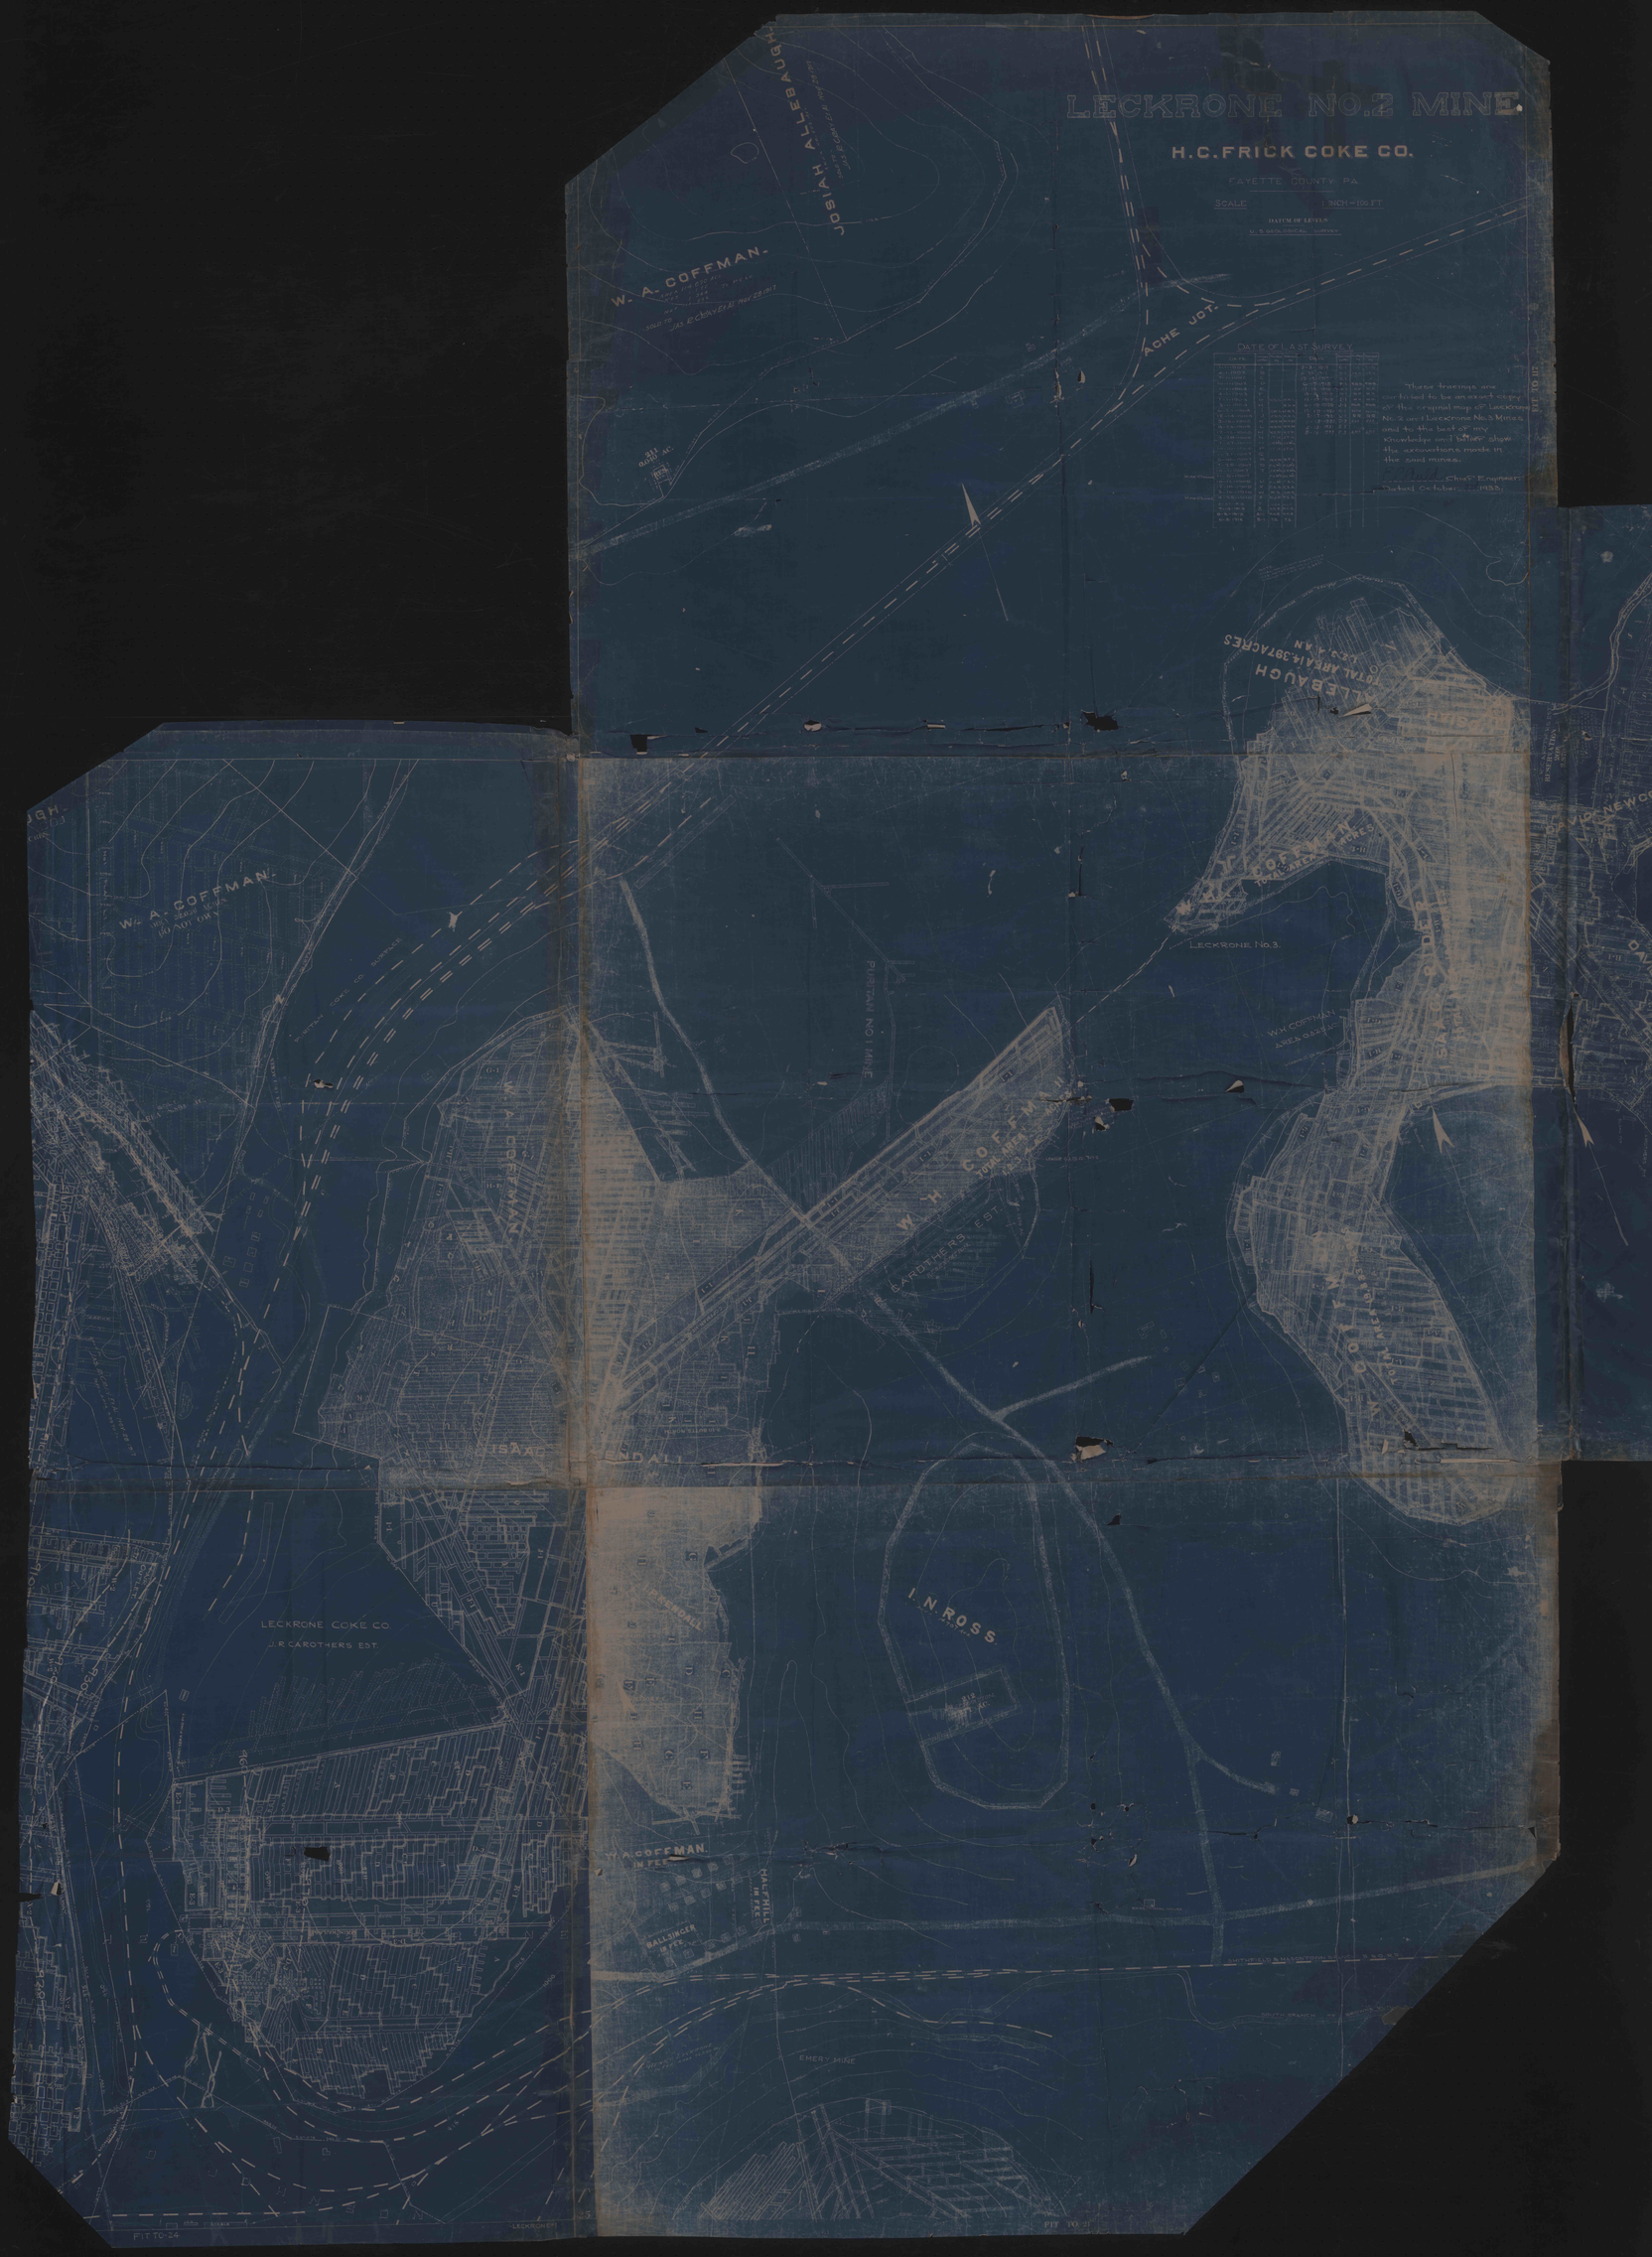
LECKRONE NO.2 MINE.
H.C.FRICK COKE CO.
FAYETTE COUNTY PA.
SCALE 1 INCH = 100 FT.
DATUM OF LEVEL
U.S. GEOLOGICAL SURVEY
DATE OF LAST SURVEY
These tracings are certified to be an exact copy of the original map of Leckrone No. 2 and Leckrone No. 3 Mines and to the best of my knowledge and belief show the excavations made in the said mines.
Chief Engineer
Dated October 2, 1933.
JOSIAH ALLEBAUGH
W. A. COFFMAN.
ACHE JCT.
W. A. COFFMAN.
LECKRONE No. 3.
PURITAN NO. 1 MINE
W. H. COFFMAN
LECKRONE COKE CO.
J. R. CAROTHERS EST.
I. N. ROSS
W. A. COFFMAN.
HALFHILL IN FEE
BALLSINGER IN FEE
EMERY MINE