


- SURVEY DATES**
- A - NOV 18, 1951
  - B - APR 21, 1952
  - C - DEC 2, 1952
  - D - SEPT 18, 1953
  - E - SEPT 25, 1954
  - F - OCT 25, 1955
  - G - FEB 27, 1956
  - H - OCT 24, 1956
  - I - APRIL 10, 1957
  - J - Nov 17, 1957
  - K - MAY 9, 1958
  - L - MARCH 13, 1959
  - M - SEPT 13, 1959
  - N - Nov 12, 1960
  - O - July 1, 1961
  - P - JAN 21, 1962

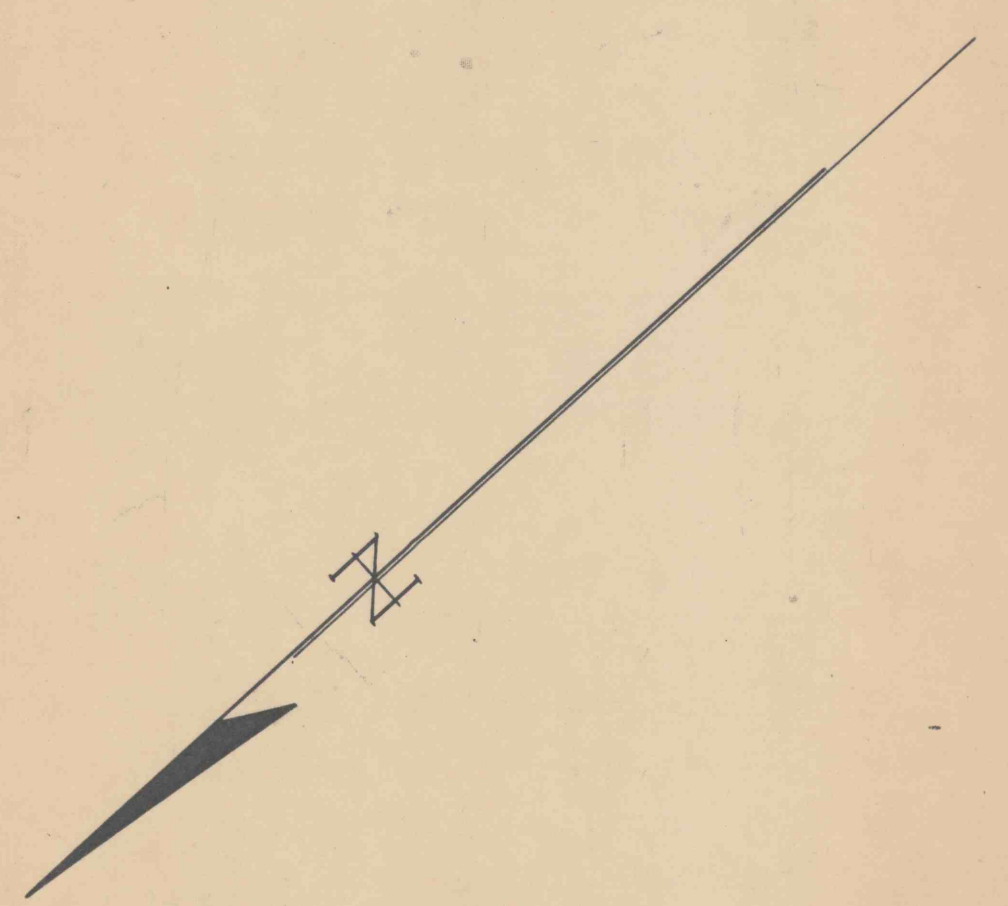


Formerly a sugar tree.

Shannopin Coal Co  
Electric Pole Line  
Water Line

Carrie Williamson

W. W. McClure Heirs

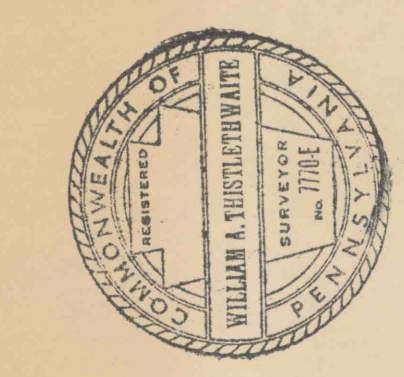

**MINE MAP OF  
LECKRONE No. 2 MINE  
OF  
THE LECKRONE COAL & COKE COMPANY  
Dunkard Twp., Greene County, Pa.  
Scale 1" = 100'  
A.J. Oppermann, R.P.E., Uniontown, Pa.  
11-23-51**