


SURVEY DATES

- A - NOV 18, 1951.
- B - APR 21, 1952.
- C - DEC 2, 1952.
- D - SEPT 18, 1953.
- E - SEPT 25, 1954.
- F - OCT 25, 1955.
- G - FEB 27, 1956.
- H - OCT 24, 1956.
- I - APRIL 16, 1957.
- J - Nov 17, 1957.
- K - MAY 9, 1958.
- L - MARCH 13, 1959.

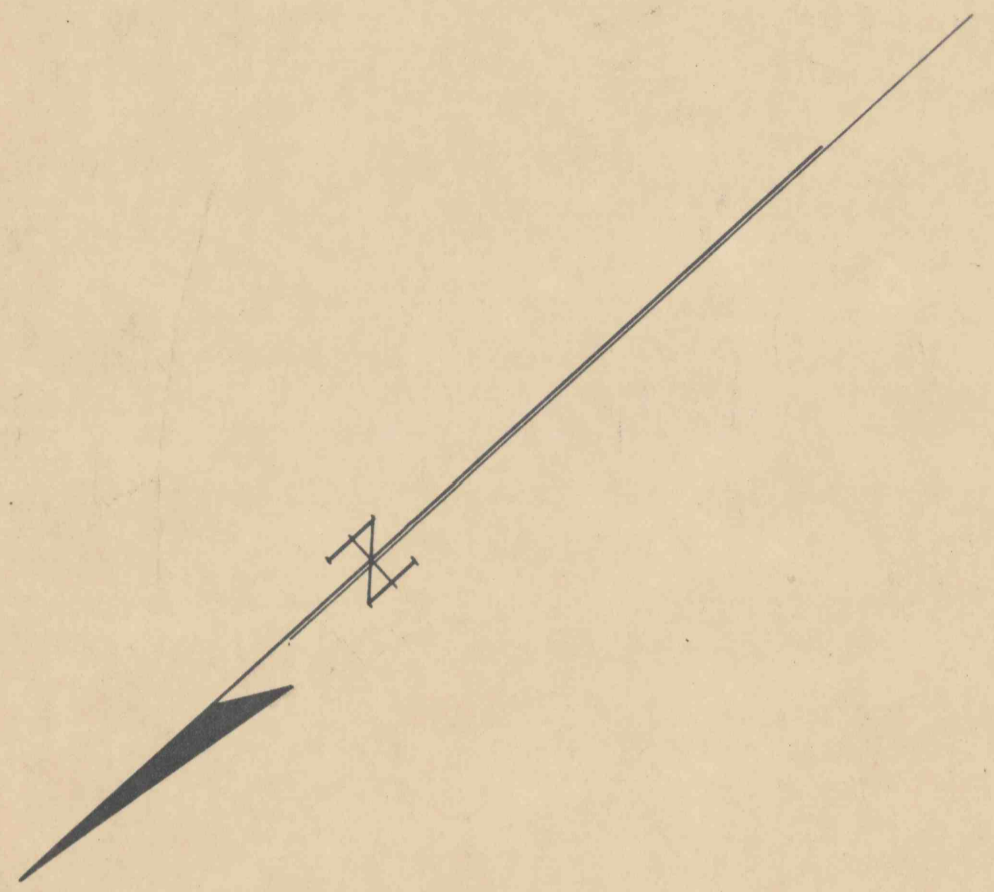

COAL RESERVATION
Area = 2.984 Acres

SURFACE AREA = 2.6829 Acres.

Carrie Williamson

W. W. McClure Heirs

MINE MAP OF
LECKRONE N^o 2 MINE
OF
THE LECKRONE COAL & COKE COMPANY
Dunkard Twp., Greene County, Pa
Scale 1" = 100'
A.J. Oppermann, R. P. E., Uniontown, Pa.
11-23-51

Mrs. James B. Black