

OLIVER NO. 3 MINE

LEISENRING NO. 2 MINE.


OF THE
UNITED STATES STEEL CORP'N.
DUNBAR TWP. - FAYETTE CO. - PA.

DATUM OF LEVELS 16.1 FT. BELOW MEAN TIDE AT SANDY HOOK

SCALE 1"=100'

DATE OF SURVEYS

JANUARY 19 1894	A	MAY 14 1906	R1	DECEMBER 20 1917	F3	December 22 1953	T-4
SEPTEMBER 24 "	B	AUGUST 14 "	S-1	OCTOBER 18 1918	G-3	June 20 1954	U-4
DECEMBER 20 "	C	DECEMBER 21 "	T1	APRIL 4 1919	H-3	December 20 1954	V-4
APRIL 3 1895	D	MARCH 13 1907	U1	JANUARY 5 1920	I-3	June 20 1955	W-4
AUGUST 1 "	E	JUNE 20 "	V1	JUNE 17 1920	J-3	December 20 1955	X-4
NOVEMBER 2 "	F	OCTOBER 5 "	W1	DECEMBER 20 1920	K-3	June 20 1956	Y-4
JANUARY 24 1896	G	JANUARY 8 1908	X1	MARCH 3 1921	L-3	Note - Leisenring No. 2 Mine is now part of Leisenring No. 3 Mine.	
MAY 26 "	H	MARCH 17 "	Y1	JULY 25 1922	M-3	November 30 1956	
AUGUST 25 "	I	JUNE 25 "	Z1	FEBRUARY 7 1923	N-3		
DECEMBER 22 "	J	OCTOBER 2 "	A2	AUGUST 1 1923	O-3		
MARCH 27 1897	K	DECEMBER 16 "	B2	DECEMBER 20 1923	P-3		
JULY 19 "	L	MARCH 18 "	C2	JULY 2 1924	Q-3		
OCTOBER 18 "	M	JUNE 25 1909	D2	JULY 31 1925	R-3		
JANUARY 4 1898	N	SEPTEMBER 29 "	E2	DECEMBER 17 1925	S-3		
APRIL 9 "	O	DECEMBER 15 "	F2	JULY 13 1926	T-3		
JULY 14 "	P	MARCH 25 1910	G2	DECEMBER 13 1926	U-3		
DECEMBER 30 "	Q	JUNE 14 "	H2	JULY 1 1927	V-3		
APRIL 20 1899	S	SEPTEMBER 15 "	I2	MARCH 13 1928	W-3		
AUGUST 25 "	T	DECEMBER 3 1910	J-2	DECEMBER 21 1928	X-3		
DECEMBER 14-21 "	U	MARCH 16 1911	K-2	June 10 1943	Y-3		
MARCH 19 1900	V	JUNE 16 1911	L-2	December 10 1943	Z-3		
JUNE 13 "	W	SEPTEMBER 20 1911	M-2	June 10 1944	A-4		
SEPTEMBER 6 "	X	DECEMBER 13 1911	N-2	December 10 1944	B-4		
DECEMBER 14 "	Y	MARCH 21 1912	O-2	June 10 1945	C-4		
MARCH 2 1901	Z	JUNE 27 1912	P-2	December 10 1945	D-4		
JUNE 10 "	AI	SEPT. 24 1912	Q-2	June 4 1946	E-4		
SEPTEMBER 30 "	BI	DECEMBER 8 1912	R-2	December 9 1946	F-4		
DECEMBER 30 "	C1	MARCH 22 1913	S-2	June 10 1947	G-4		
MAY 16 1902	DI	JUNE 11 1913	T-2	December 10 1947	H-4		
AUGUST 21 "	E1	SEPT. 11 1913	U-2	June 10 1948	I-4		
MAY 14 1903	H1	DECEMBER 11 1913	V-2	December 10 1948	J-4		
		March 17 1914	W-2	June 10 1949	K-4		
MARCH 16 1904	J1	JUNE 13 1914	X-2	December 12 1949	L-4		
MAY 23 "	K1	SEPTEMBER 10 1914	Y-2	June 20 1950	M-4		
AUGUST 18 "	L1	DECEMBER 11 1914	Z-2	December 20 1950	N-4		
NOVEMBER 22 "	M1	JUNE 11 1915	A-3	June 20 1951	O-4		
MARCH 8 1905	N1	DECEMBER 3 1915	B-3	December 20 1951	P-4		
JUNE 16 "	O1	MAY 27 1916	C-3	June 18 1952	Q-4		
SEPTEMBER 21 "	P1	NOVEMBER 28 1916	D-3	December 22 1952	R-4		
JANUARY 26 1906	Q1	MAY 26 1917	E-3	June 24 1953	S-4		

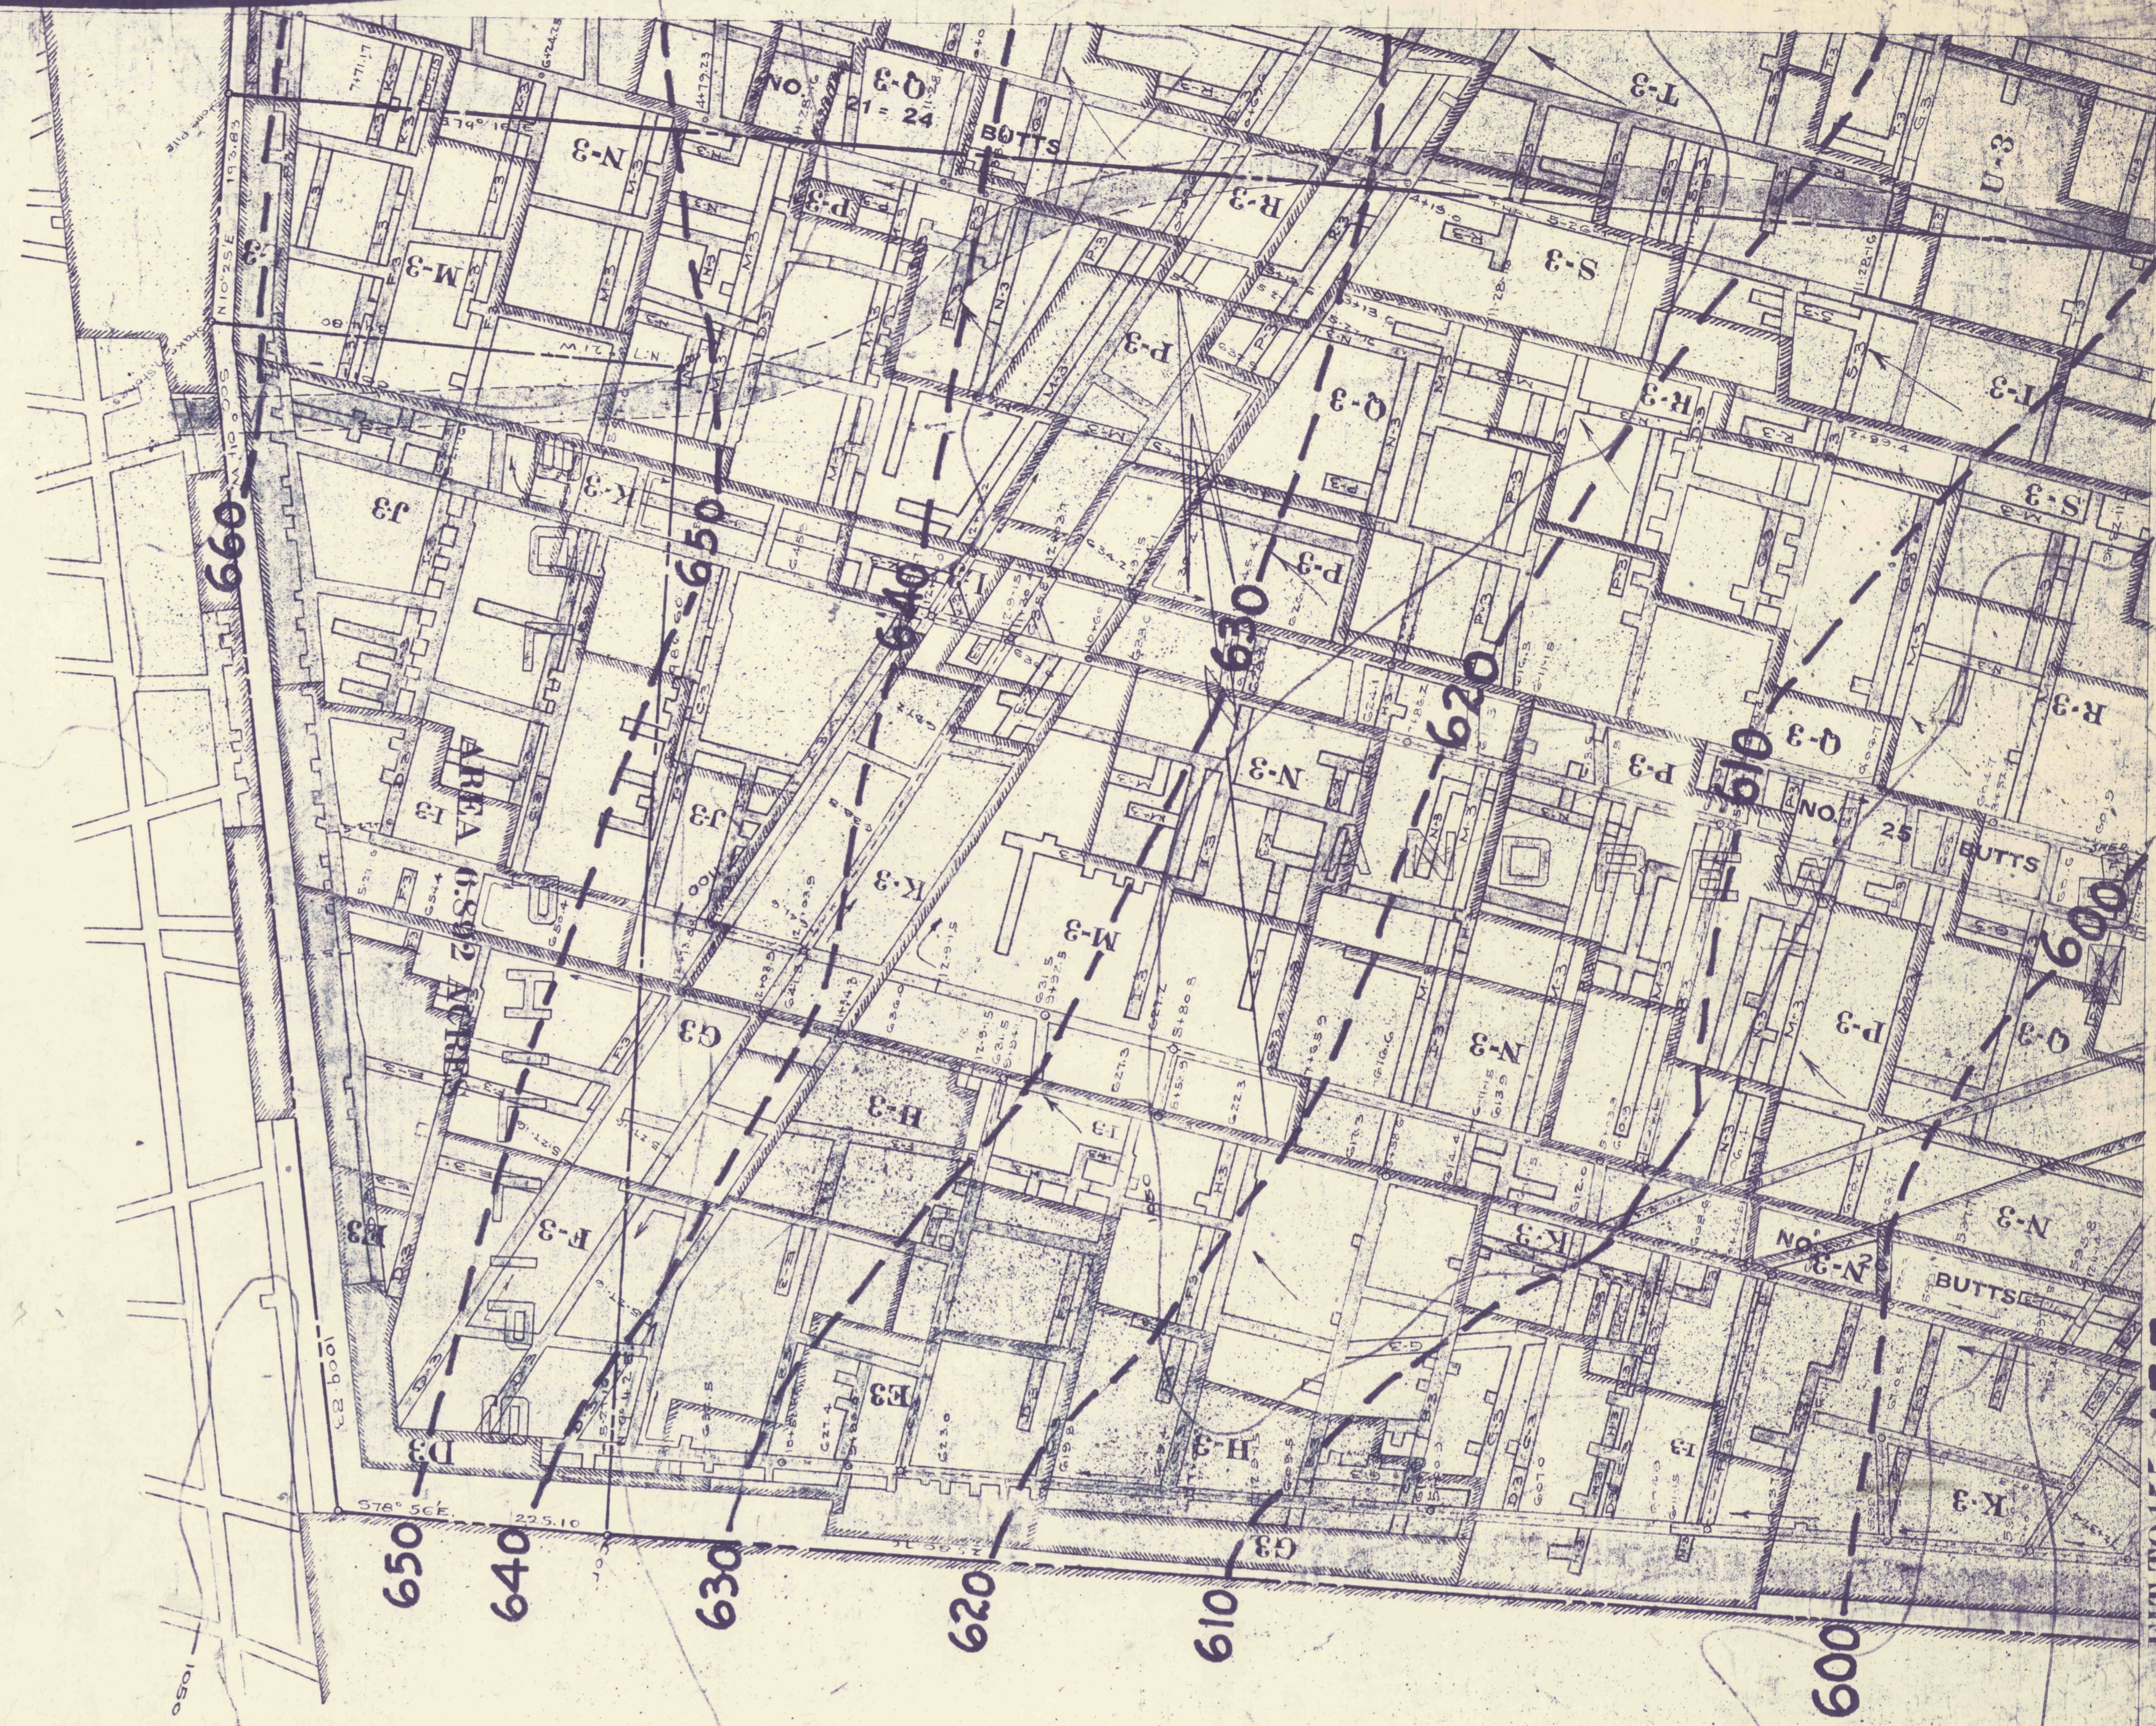

26 SHEETS
FIT THUS

	117	116		
127	126	125	124	
136	135	134	133	132
144	143	142	141	140
150	149	148	147	146
TITLE SHEET	155	154	153	152

FIT TO 157 157

FIT TO 155 155

OLIVER NO 3