


FIT TO 197 197

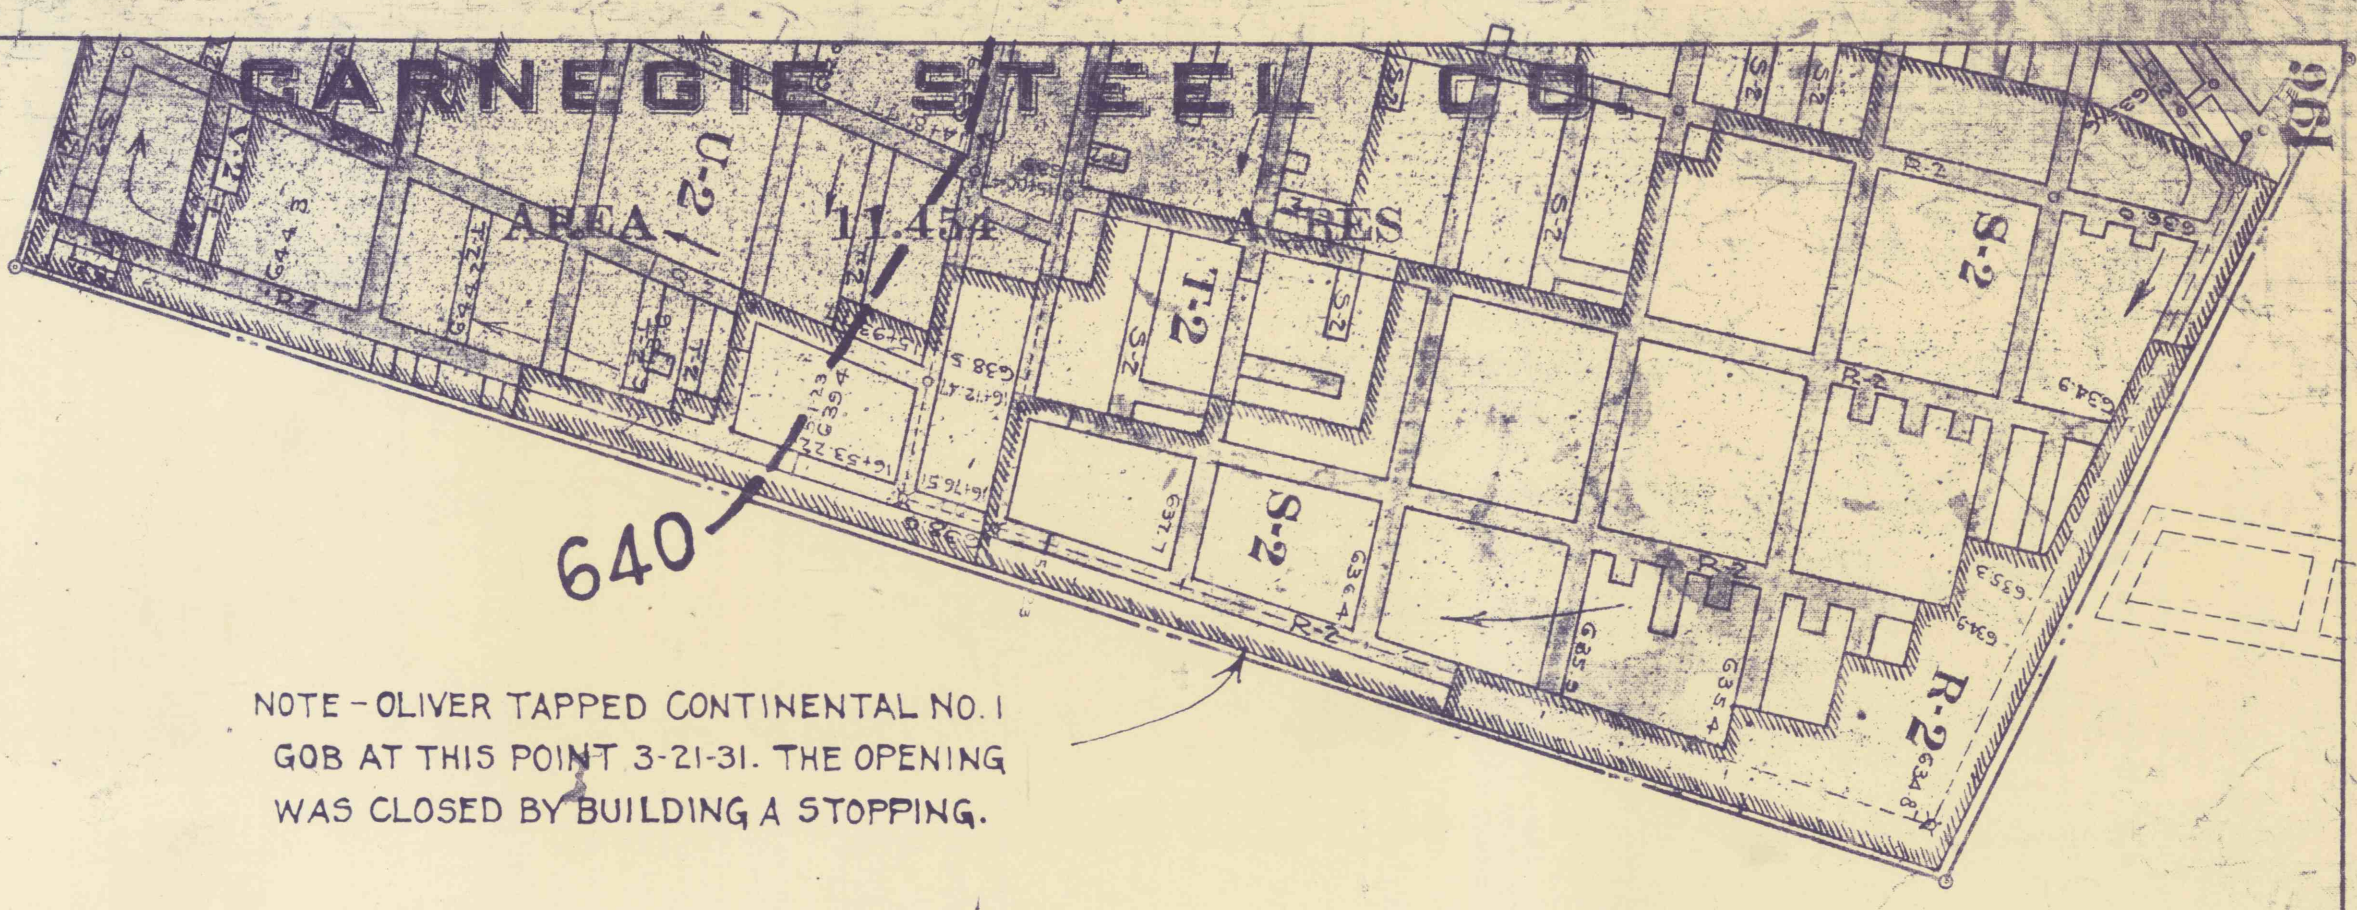

NOTE - OLIVER TAPPED CONTINENTAL NO. 1  
GOB AT THIS POINT 3-21-31. THE OPENING  
WAS CLOSED BY BUILDING A STOPPING.

# LEITH MINE

OF THE

H. C. FRICK COKE CO.

SOUTH UNION TWP. - FAYETTE CO. - PA.


DATUM OF LEVELS 16.1 FT. BELOW MEAN TIDE AT SANDY HOOK

SCALE 1"=100'

## DATE OF SURVEYS

3-10-1893	A	6-28-1900	A-1	2-7-1907	A-2	J.T.	7-21-1913	A-3	J.Z.	10-23-1925	A-4	A.S.	1-23-41	A-5	N.H.E.
1-1-1894	B	10-26-1900	B-1	4-25-1907	B-2	J.T.	10-21-1913	B-3	J.Z.	4-28-1926	B-4	A.S.	4-15-41	B-5	N.H.E.
4-11-1894	C	1-16-1901	C-1	7-30-1907	C-2	T.S.	1-23-1914	C-3	J.Z.	10-29-1926	C-4	W.S.	10-10-41	C-5	R.H.
10-16-1894	D	4-27-1901	D-1	10-30-1907	D-2	J.T.	4-24-1914	D-3	J.Z.	5-23-1927	D-4	A.S.	1-5-42	D-5	R.H.
12-22-1894	E	7-19-1901	E-1	1-24-1908	E-2	J.T.	7-22-1914	E-3	J.Z.	9-30-1927	E-4	A.S.	6-11-42	E-5	R.H.
4-4-1895	F	10-29-1901	F-1	4-21-1908	F-2	T.S.	0-20-1914	F-3	J.Z.	11-23-1928	F-4	A.S.			
6-28-1895	G	1-13-1902	G-1	7-13-1908	G-2	T.S.	1-23-1915	G-3	J.Z.	9-30-1929	G-4	R.H.			
8-27-1895	H	3-19-1902	H-1	10-26-1908	H-2	T.S.	4-30-1915	H-3	T.S.	11-3-1931	H-4	A.S.			
1-6-1896	I	7-28-1902	I-1	1-23-1909	I-2	T.S.	10-24-1915	I-3	T.S.	11-14-1932	I-4	A.S.			
4-16-1896	J	10-28-1902	J-1	4-24-1909	J-2	J.T.	4-27-1916	J-3	A.S.	12-5-1933	J-4	A.S.			
7-23-1896	K	4-6-1903	K-1	7-30-1909	K-2	T.S.	10-24-1916	K-3	A.S.	10-30-1936	K-4	A.S.			
11-9-1896	L	7-17-1903	L-1	10-25-1909	L-2	T.S.	1-20-1917	L-3	F.Y.	12-28-1936	L-4	A.S.			
12-30-1896	M	10-27-1903	M-1	1-19-1910	M-2	S.J.P.	10-22-1917	M-3	F.Y.	3-25-1937	M-4	S.J.P.			
3-23-1897	N	1-4-1904	N-1	4-20-1910	N-2	A.S.	4-26-1918	N-3	R.H.	7-5-1937	N-4	S.J.P.			
6-28-1897	O	1-6-1904	O-1	7-22-1910	O-2	A.S.	10-14-1918	O-3	A.S.	10-6-1937	O-4	S.J.P.			
10-1-1897	P	7-3-1904	P-1	10-27-1910	P-2	A.S.	4-23-1918	P-3	A.S.	11-4-1937	P-4	S.J.P.			
12-25-1897	Q	10-4-1904	Q-1	1-21-1911	Q-2	A.S.	10-28-1919	Q-3	R.H.	6-29-1938	Q-4	A.S.			
3-29-1898	R	1-6-1905	R-1	4-21-1911	R-2	T.S.	4-23-1920	R-3	R.H.	10-6-1938	R-4	S.J.P.			
5-22-1898	S	4-4-1905	S-1	7-24-1911	S-2	A.S.	10-26-1920	S-3	A.S.	1-3-1939	S-4	S.J.P.			
8-28-1898	T	6-29-1905	T-1	10-24-1911	T-2	A.S.	4-29-1921	T-3	A.S.	3-30-1939	T-4	R.E.A.			
12-7-1898	U	10-10-1905	U-1	1-22-1912	U-2	T.S.	12-21-1921	U-3	A.S.	7-27-1939	U-4	R.E.A.			
4-10-1899	V	1-13-1906	V-1	4-23-1912	V-2	A.S.	1-30-1923	V-3	A.S.	10-13-1939	V-4	R.E.A.			
6-10-1899	W	4-25-1906	W-1	7-22-1912	W-2	A.S.	4-27-1923	W-3	A.S.	2-1-40	W-4	R.E.A.			
10-11-1899	X	7-27-1906	X-1	10-21-1912	X-2	T.S.	10-21-1923	X-3	R.H.	3-27-1940	X-4	R.E.A.			
1-2-1900	Y	11-9-1906	Y-1	1-20-1913	Y-2	T.S.	4-28-1924	Y-3	R.H.	7-10-1940	Y-4	R.E.A.			
4-2-1900	Z			4-23-1913	Z-2	J.Z.	5-11-1925	Z-3	R.H.	10-7-1940	Z-4	R.E.A.			

15 SHEETS - FIT THUS

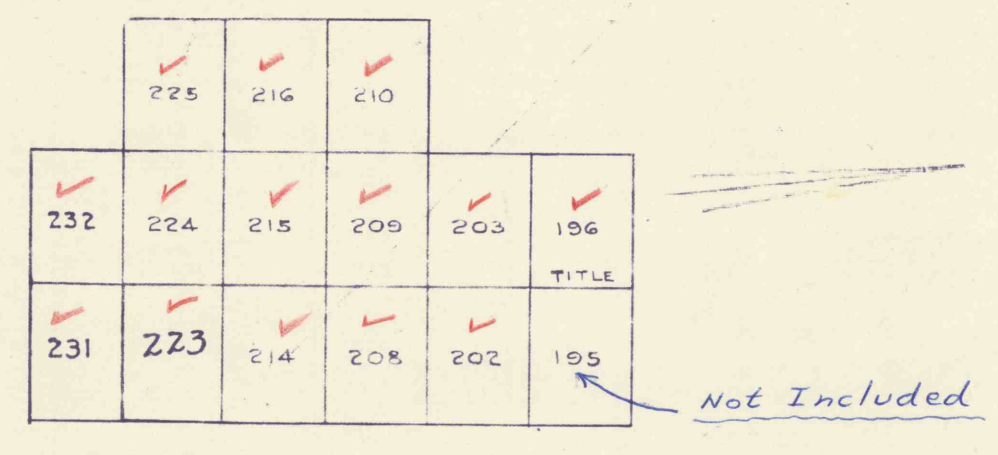

FIT TO 195 195

FIT TO 203 203

FIT TO 190 190

TITLE SHEET LEITH MINE 196 CONT'L NO. 1

TITLE SHEET LEITH MINE 196 CONT'L NO. 1