LEITH — CROSSLAND
LEMONT NO. 2 202

202

FIT TO 195 195

FIT TO 203 203

FIT TO 201 201

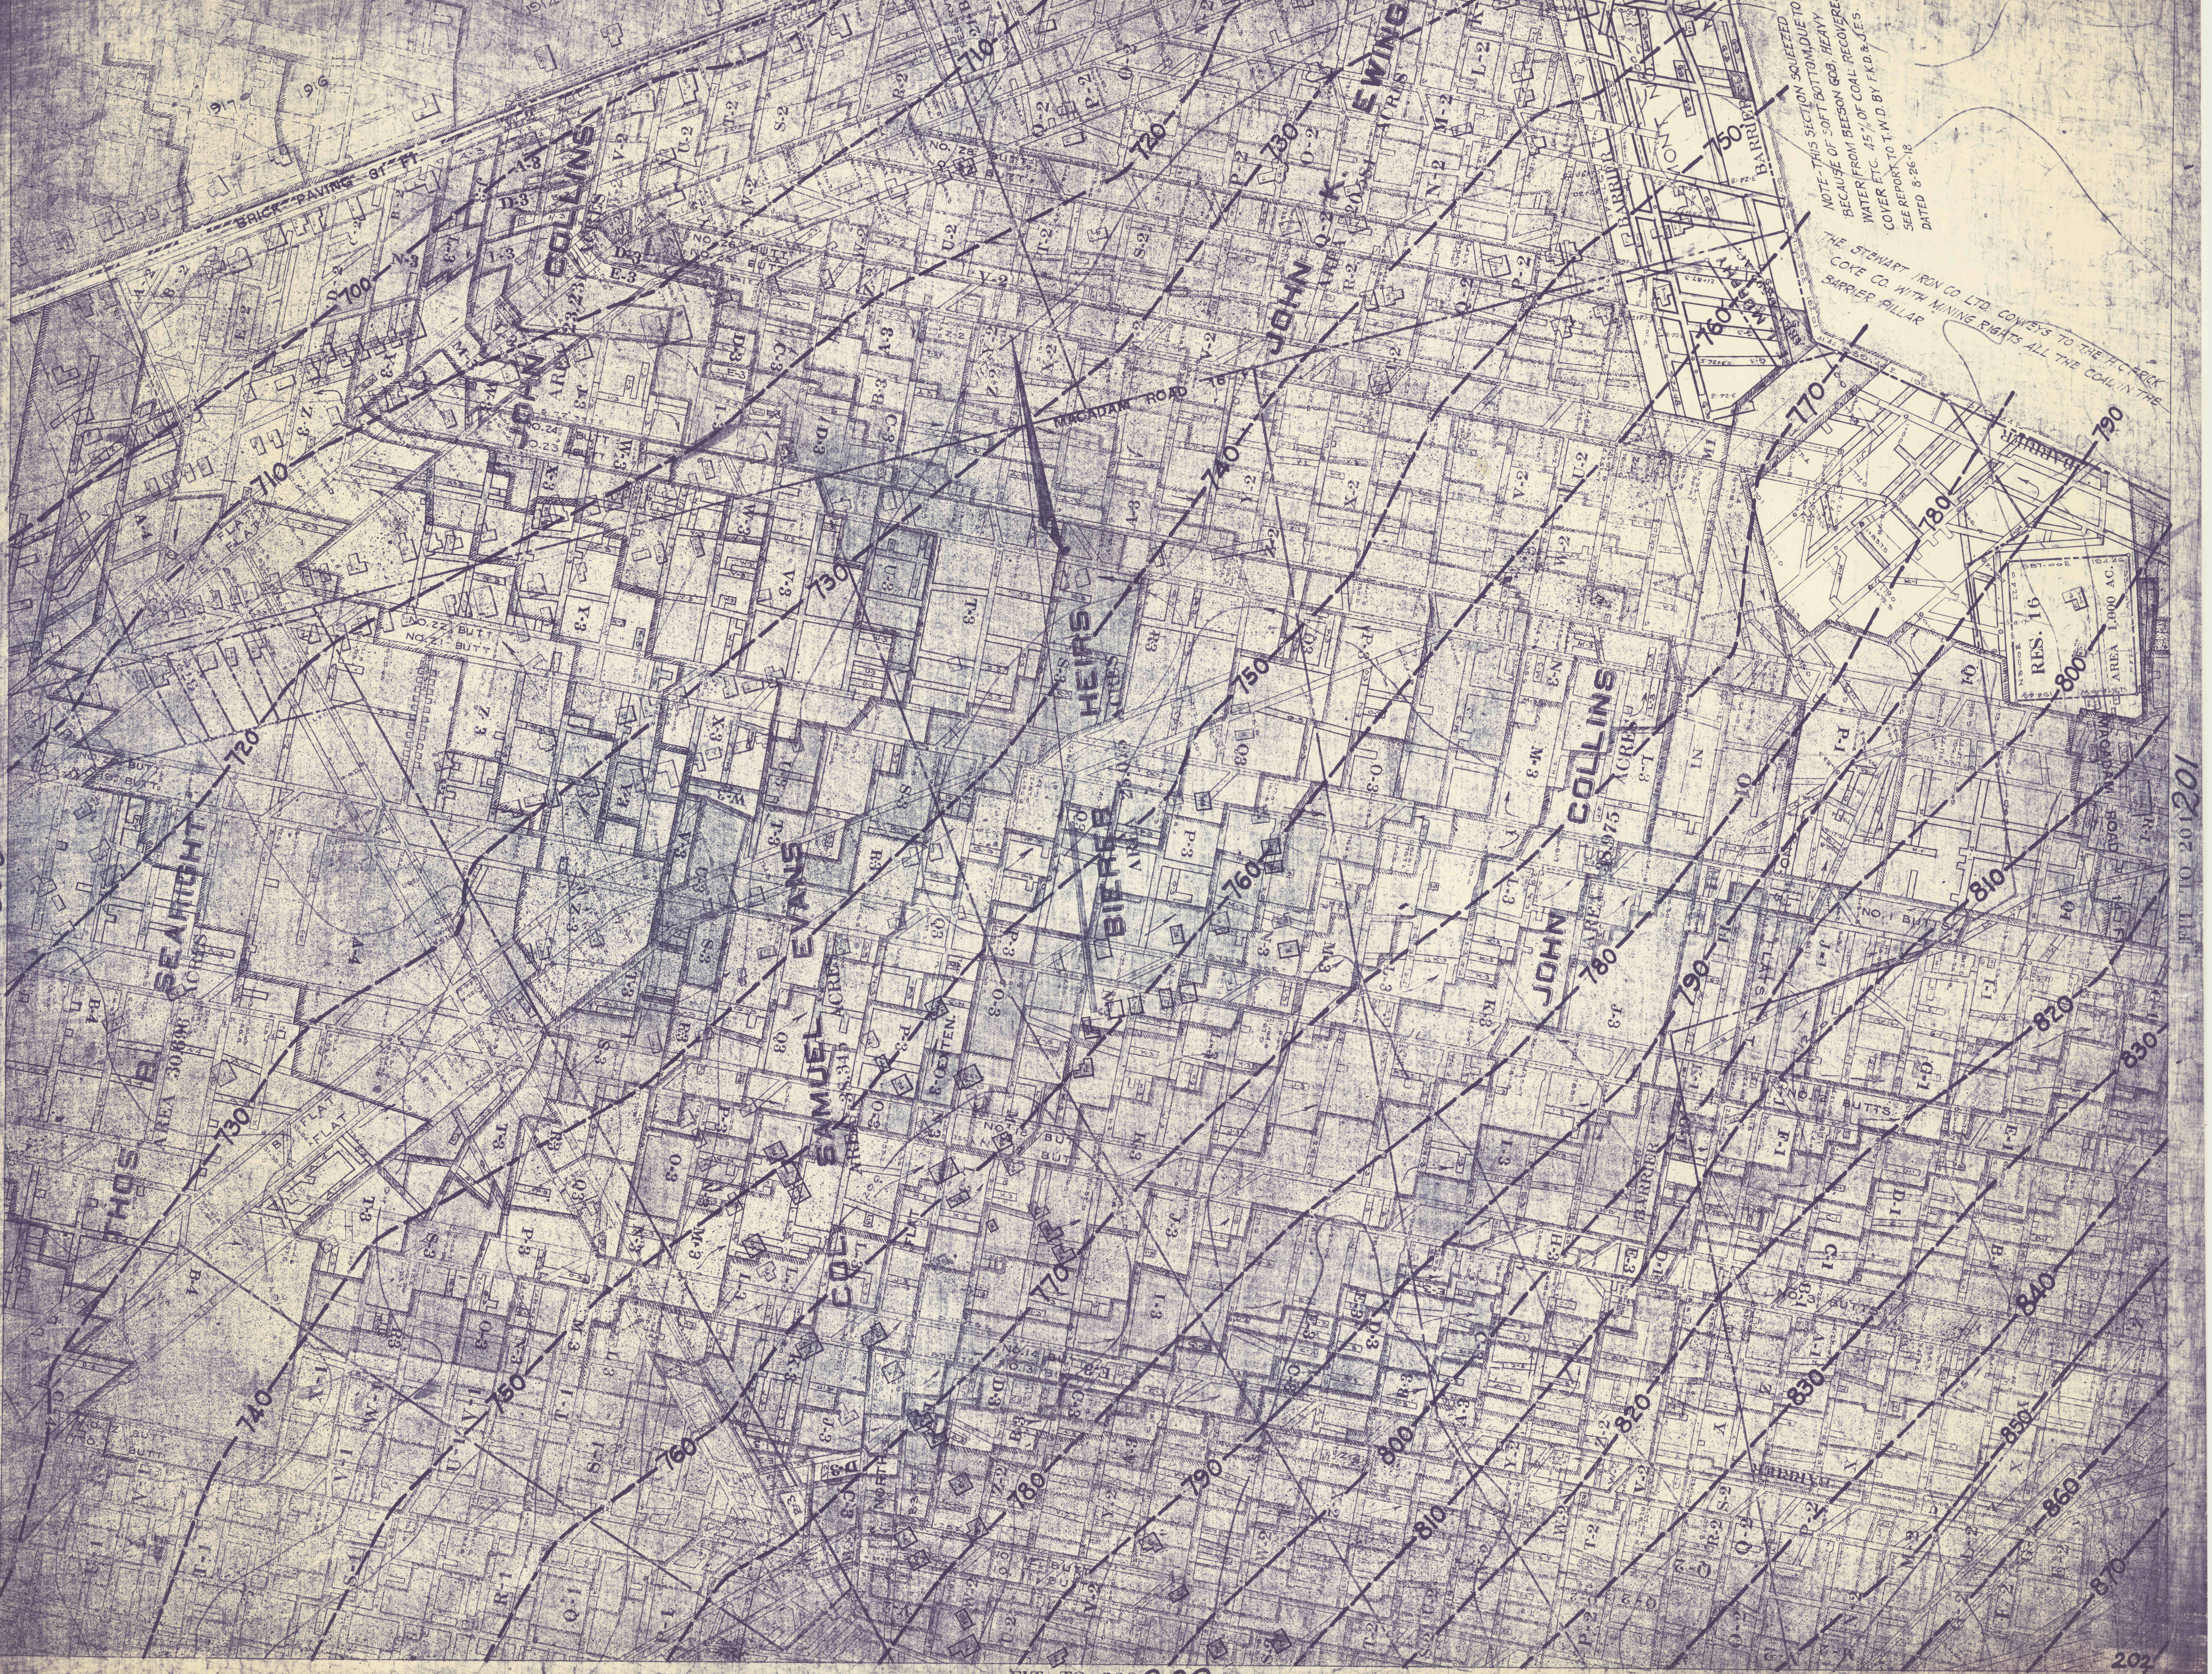

NOTE - THIS SECTION SQUEEZED
BECAUSE OF SOFT BOTTOM, DUE TO
WATER FROM BEESON GOB, HEAVY
COVER ETC. 45% OF COAL RECOVERED.
SEE REPORT TO T.W.D. BY F.K.D. & J.E.S.
DATED 8-26-18

THE STEWART IRON CO. LTD. CONVEYS TO THE H.C. FRICK
COKE CO. WITH MINING RIGHTS ALL THE COAL IN THE
BARRIER PILLAR

FIT TO 208 208

202

LEITH — CROSSLAND
LEMONT NO. 202