

LEMONT NO. 1 MINE

of the

H. C. FRICK—COKE—CO.

— NORTH-UNION-TWP. — FAYETTE-COUNTY-PA. —

Datum of levels 16.1 feet below mean tide at Sandy Hook N. J.


SCALE 1"=100'

Date of Surveys

MONTH	DATE	YEAR	LETTER	MONTH	DATE	YEAR	LETTER	MONTH	DATE	YEAR	LETTER	MONTH	DATE	YEAR	LETTER
SEPTEMBER	24	1895	A	FEBRUARY	3	1895	D-1	JULY	27	1919	G-2	NOVEMBER	25	1921	J-3
FEBRUARY	18	1895	D	MAY	4	1895	E-1	OCTOBER	21	1919	H-2	JULY	8	1925	K-3
MAY	12	1895	C	JULY	21	1895	F-1	JANUARY	21	1911	M-2	FEBRUARY	3	1925	L-3
AUGUST	17	1895	B	OCTOBER	27	1895	G-1	APRIL	21	1911	N-2	SEPTEMBER	4	1925	M-3
OCTOBER	24	1894	E	JANUARY	25	1894	H-1	JULY	21	1911	N-2	MARCH	21	1924	N-3
JANUARY	5	1897	F	MAY	4	1894	I-1	OCTOBER	25	1911	N-2	MARCH	20	1925	O-3
APRIL	13	1897	G	JULY	27	1894	J-1	JANUARY	21	1912	N-2	OCTOBER	9	1925	P-3
JULY	23	1897	H	NOVEMBER	8	1894	K-1	APRIL	21	1912	N-2	MARCH	20	1926	O-3
OCTOBER	15	1897	I	JANUARY	26	1894	L-1	OCTOBER	23	1912	O-2	SEPTEMBER	5	1927	X-3
JANUARY	11	1898	J	APRIL	25	1894	M-1	JANUARY	21	1913	O-2	OCTOBER	5	1927	Y-3
APRIL	15	1898	K	JULY	31	1895	N-1	MAY	23	1913	P-2	SEPTEMBER	5	1941	
JULY	11	1898	L	NOVEMBER	15	1895	O-1	OCTOBER	25	1913	P-2	JANUARY	2	1942	
OCTOBER	5	1898	M	MARCH	6	1894	P-1	JANUARY	25	1914	T-2				
JANUARY	3	1898	N	JUNE	12	1894	Q-1	MAY	11	1914	U-2				
MARCH	30	1893	O	SEPTEMBER	14	1894	R-1	JULY	31	1914	V-2				
JULY	10	1893	P	JANUARY	15	1897	S-1	OCTOBER	14	1914	W-2				
SEPTEMBER	28	1893	Q	APRIL	27	1897	T-1	APRIL	25	1915	X-2				
JANUARY	29	1906	R	AUGUST	6	1897	U-1	OCTOBER	27	1916	Y-2				
MAY	1	1906	S	OCTOBER	21	1897	V-1	APRIL	8	1916	Z-2				
AUGUST	9	1905	T	FEBRUARY	4	1898	W-1	DECEMBER	27	1917	A-3				
NOVEMBER	22	1900	U	APRIL	20	1898	X-1	APRIL	13	1918	B-3				
FEBRUARY	22	1901	V	JULY	13	1898	Y-1	MAY	15	1918	C-3				
MAY	31	1901	W	OCTOBER	21	1898	Z-1	DEC.	13	1919	D-3				
SEPTEMBER	3	1901	X	JANUARY	22	1898	A-2	MAY	13	1919	E-3				
DECEMBER	12	1901	Y	APRIL	23	1898	B-2	NOVEMBER	13	1919	F-3				
FEBRUARY	22	1902	Z	JULY	27	1898	C-2	MAY	13	1920	G-3				
MAY	23	1902	A-1	OCTOBER	26	1898	D-2	NOVEMBER	12	1920	H-3				
SEPTEMBER	7	1907	B-1	JANUARY	19	1910	E-2	MAY	18	1921	I-3				
DECEMBER	4	1907	C-1	APRIL	23	1910	F-2								

— 14 SHEETS —

FIT THUS,

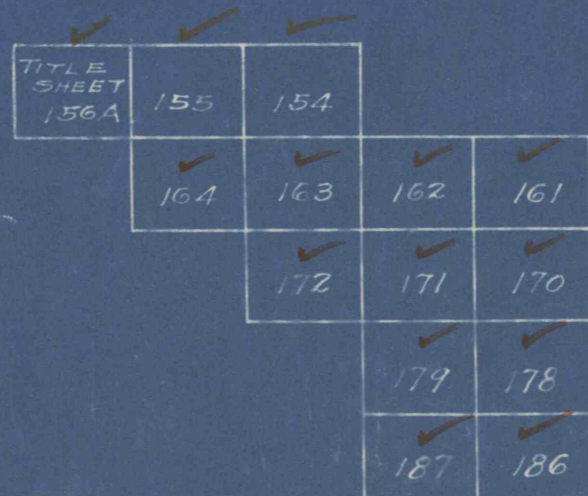

See Lemont #2 Title Sheet
for Pasting Plan of #1 & 2
Combined

OLIVER NO. 3

FIT TO 155