

KINDER MINE
WARNER LEONARD COAL CO.

PITTSBURG COAL CO.


KNOB MINE

MONONGAHELA

RIVER

PITTSBURG COAL CO.
CRESCENT MINE

LILLEY COAL AND COKE CO.
EAST PINE RUN TWP. WASH. CO. PA.
SCALE 1 IN. = 100 FT.

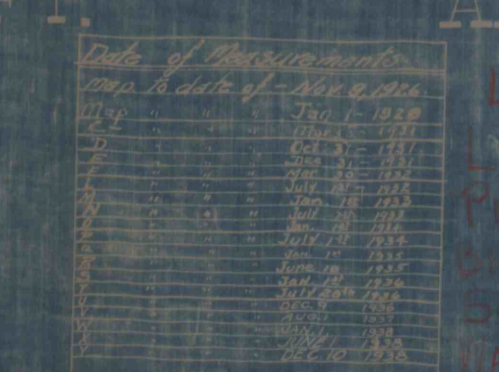

In the undersigned, hereby certify that this map is correct and shows all the information to the best of my knowledge and belief, required by the statute...
J. M. [Signature]
J. M. [Signature]