


SURVEYOR RUN LUMBER CO

JAS GRAHAM

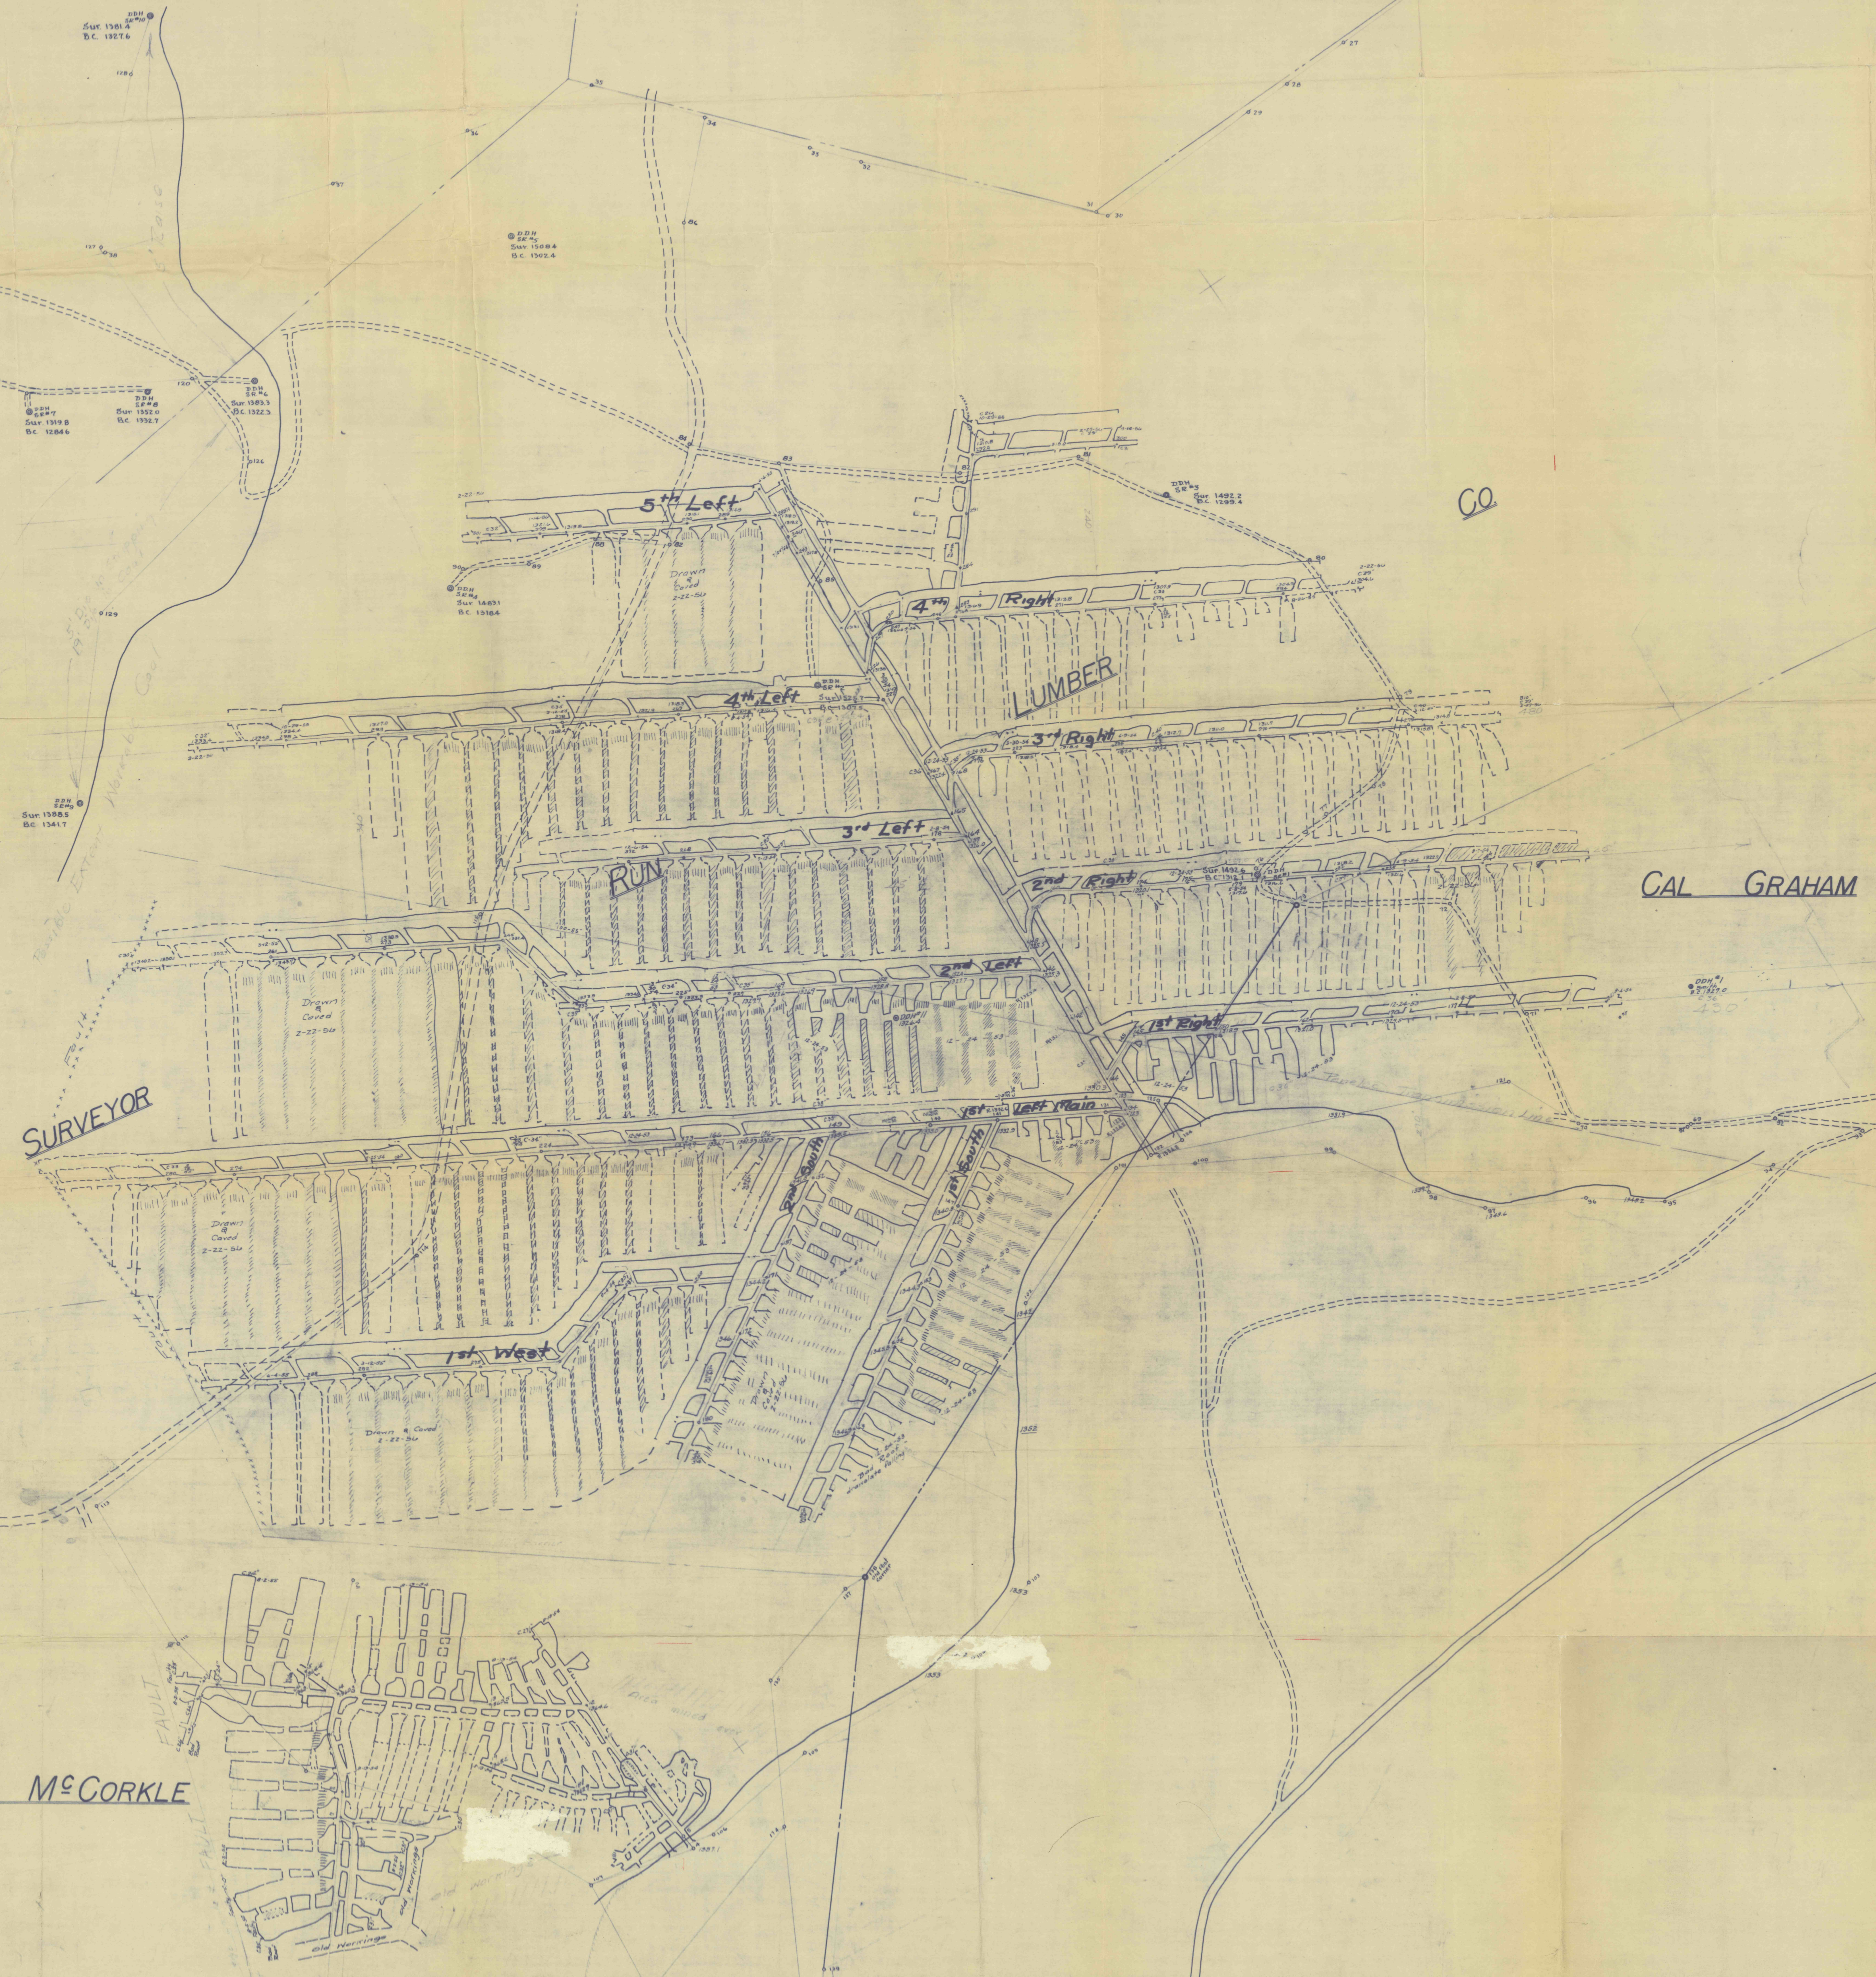

LINGLE COAL COMPANY

No. 7 Mine

Girard Twp.

Clearfield Co., Penna.

SCALE - 1 inch = 100 feet

Mar. 17, 1953
Clearfield, Penna.

Engineering Offices
Yost, Bromfield & Hess

NB. 272, 274
File 1299C

North