

N 84° 51' W


PROPERTY LINE

STEVENS

1930

S 5° 45' E 1600'


SURFACE - LINK COAL CO.
COAL LINK COAL CO.
57 ACRES

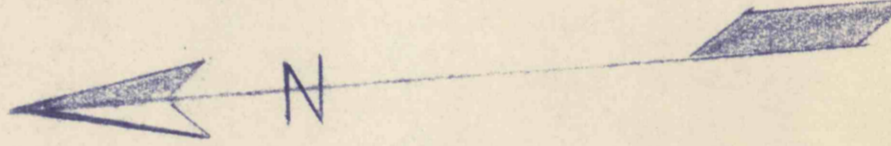

TOWNSHIP ROAD - To RICHLANDS

DAVIS MINE DRIFT

N 5° 45' E 1600'

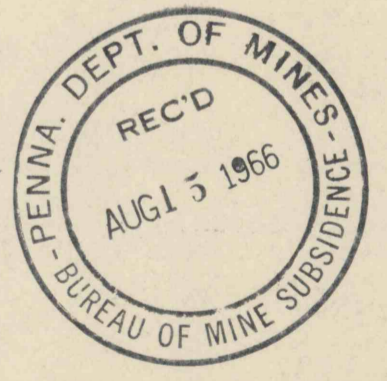

6 MONTH EXTRACTION
SUBSIDENCE BOUNDARY

PROPERTY & MINE MAP
OF
LINK COAL COMPANY
DYSART R.D. PENNA.
DEAN TOWNSHIP - CAMBRIA CO.

SCALE - 1" = 100' DATE - AUGUST 1966
COAL SEAM - "B" DRAWN BY - J.C.P.
REFERENCES - FORMER STAR
COAL COMPANY MINE SURVEY

NOTE - MINE ENTRANCE ELEVATION NOT EXACT
SEA LEVEL

SEAL

FIELD CO