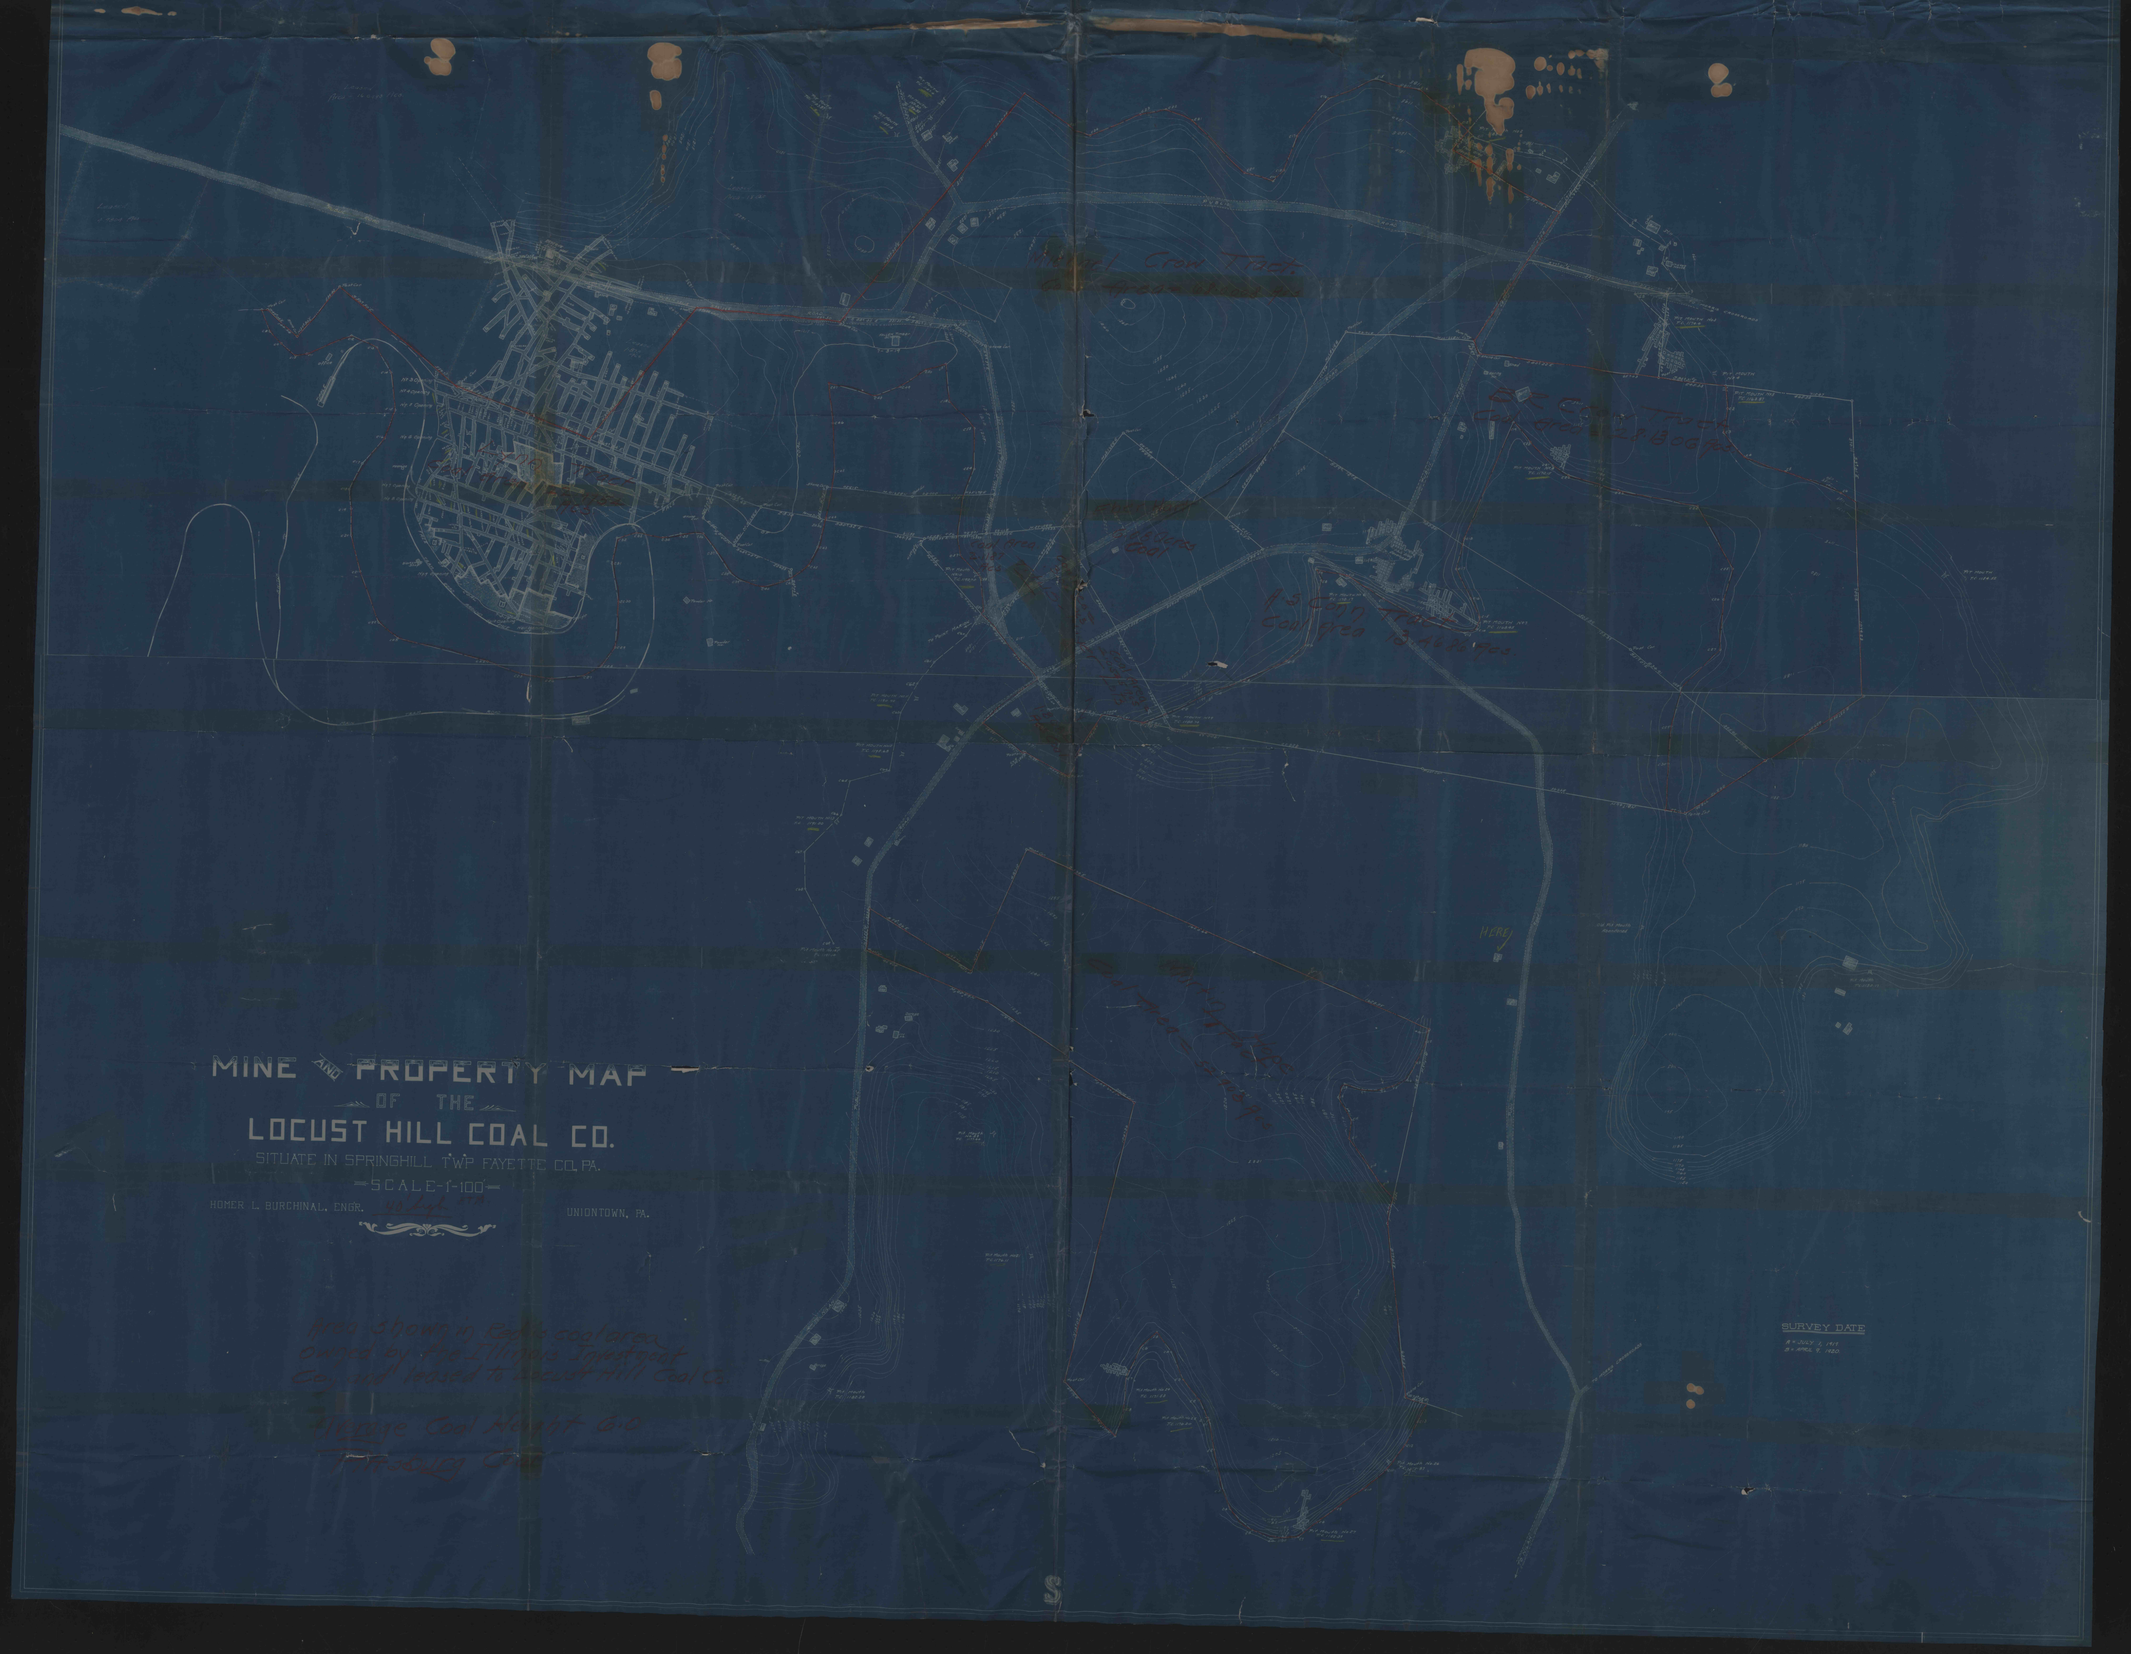
MINE AND PROPERTY MAP
OF THE
LOCUST HILL COAL CO.
SITUATE IN SPRINGHILL TWP FAYETTE CO. PA.
SCALE-1-100
HOMER L. BURCHINAL, ENGR.
UNIONTOWN, PA.
Area shown in Red's coal area owned by the Illinois Investment Co. and leased to Locust Hill Coal Co.
Average Coal Height 6.0
Pressing Crew
SURVEY DATE
A = JULY 1, 1911
B = APRIL 9, 1920